


GEORGE SHAFFER

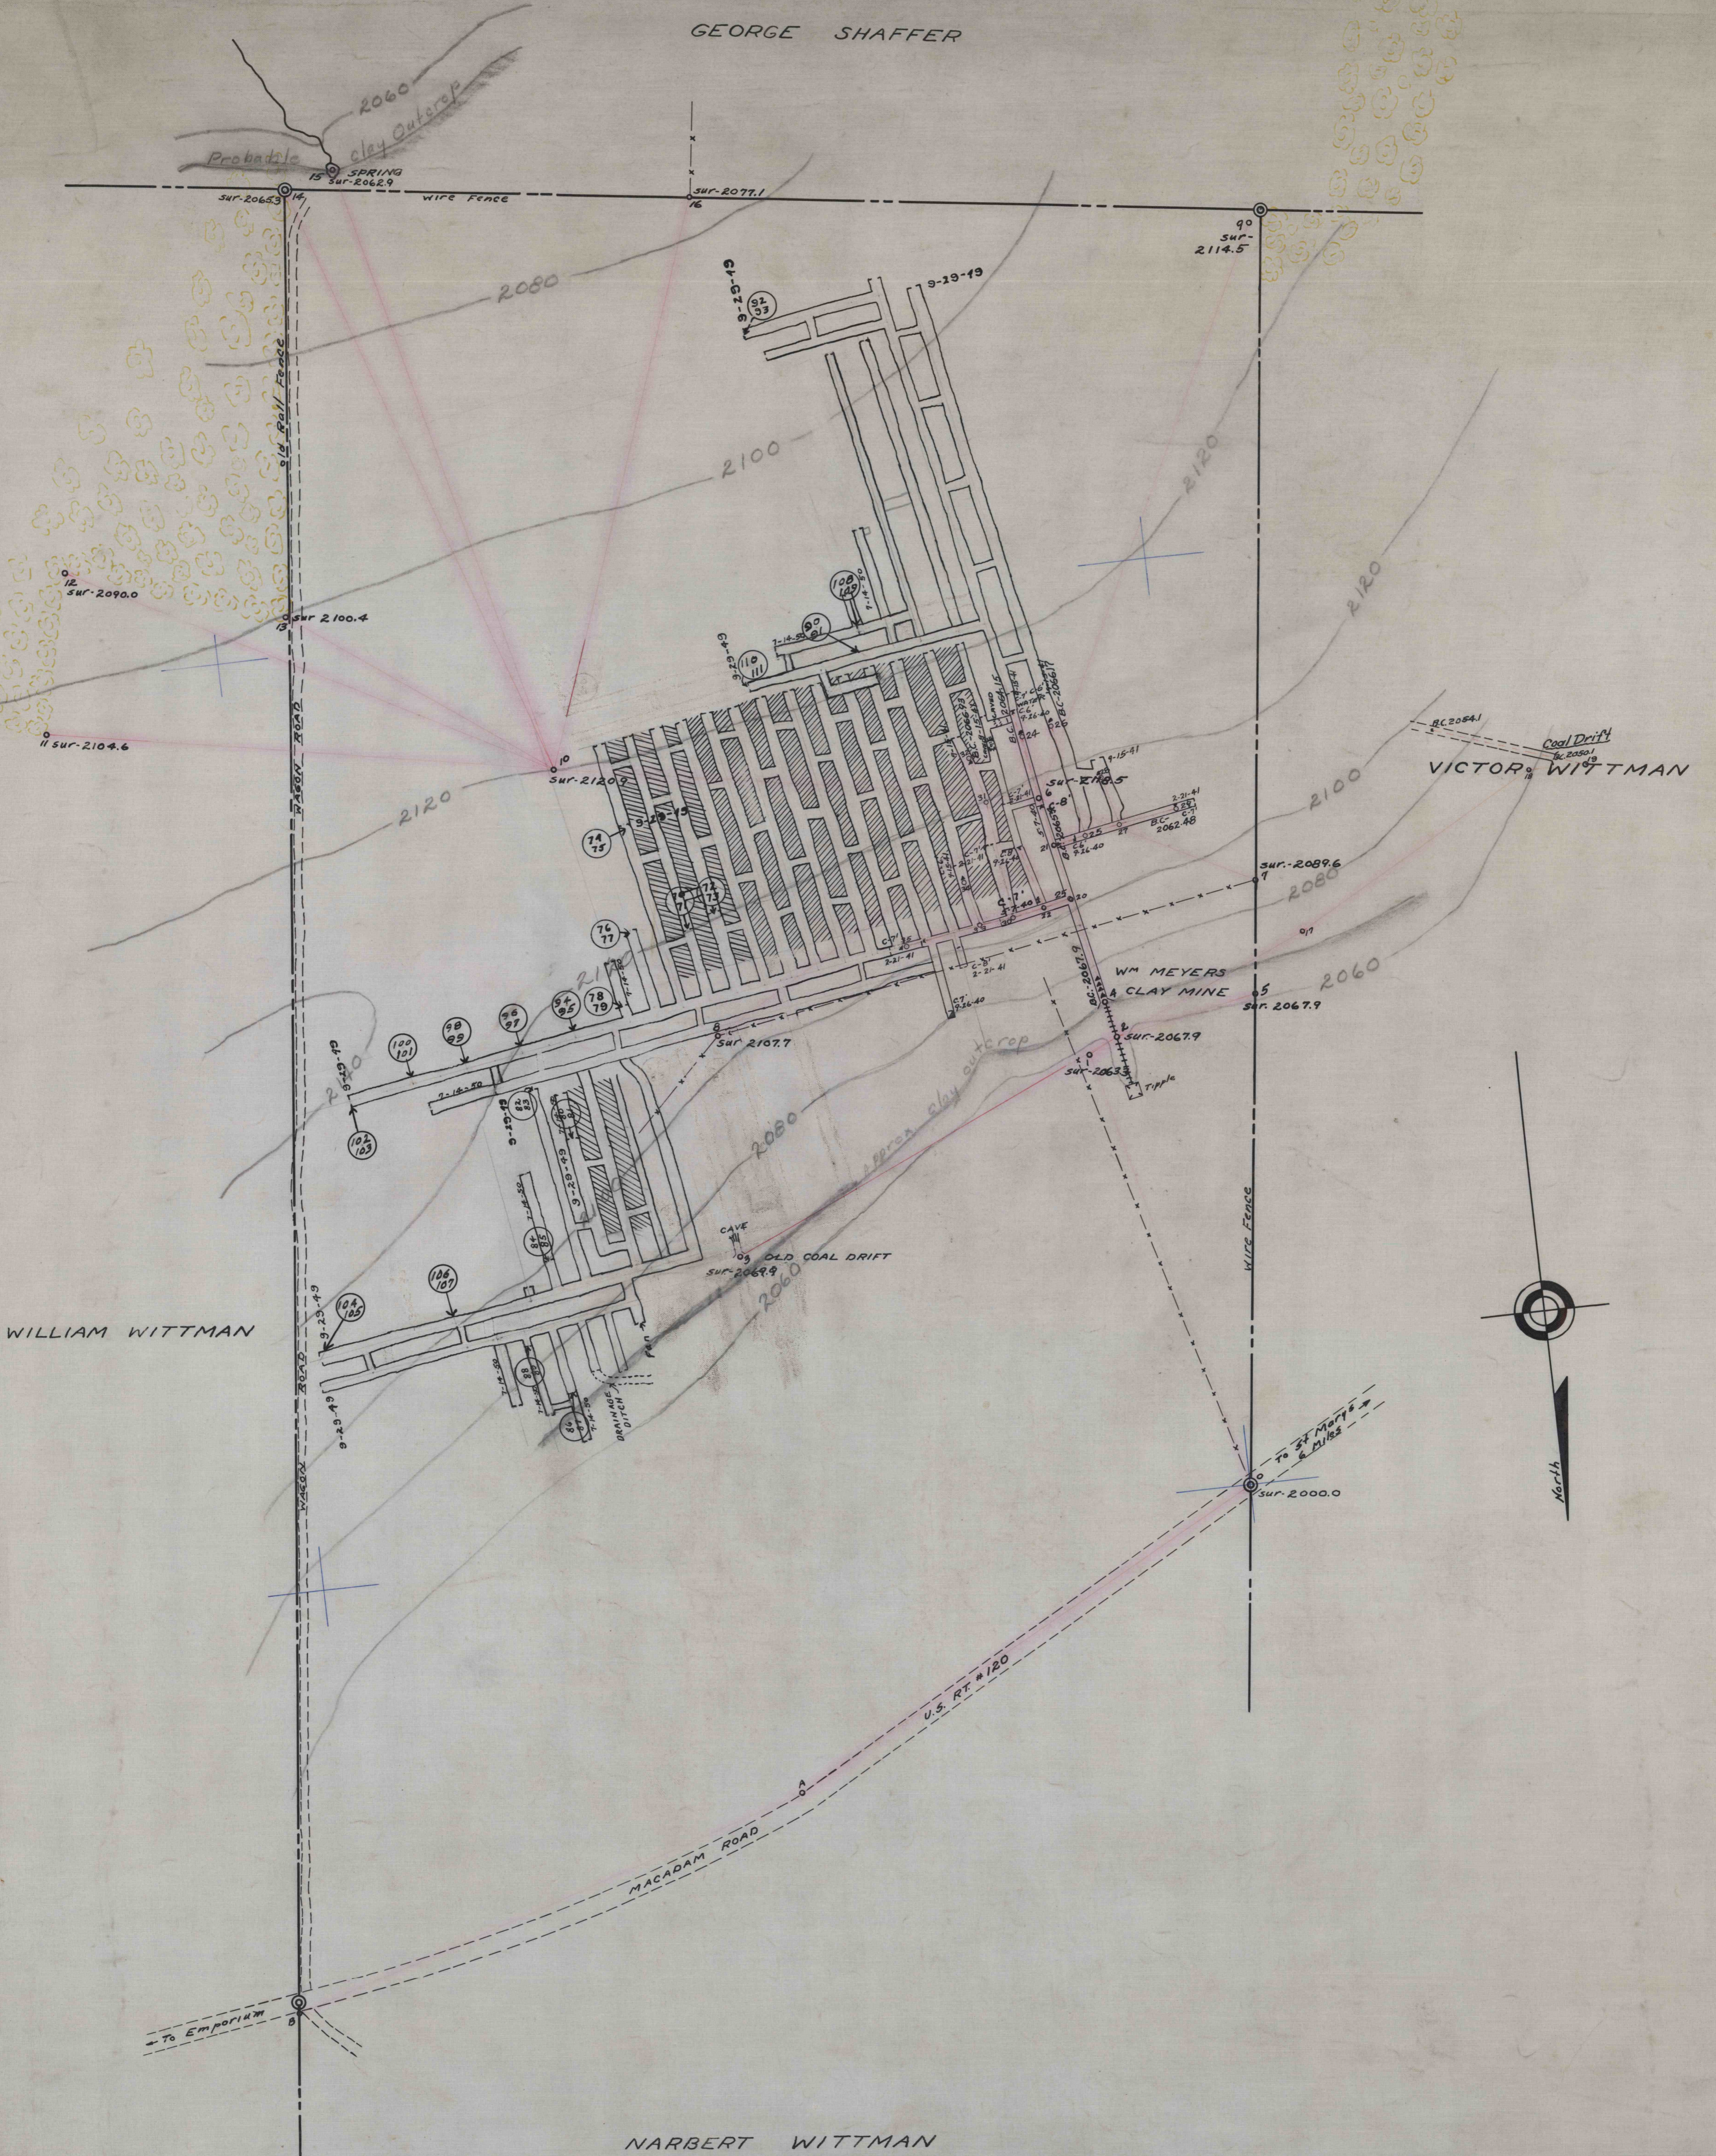

NORTH AMERICAN REFRACTORIES COMPANY
CLEVELAND, OHIO

MAP OF
CLAY LEASE AND MINE
OPERATED BY WM MEYERS
ON THE
NARBERT WITTMAN TRACT
BENZINGER TWP - ELK COUNTY, PENNA.

DRAWN - *ASD*
CHECKED - *JS*
SCALE 1" = 100 FT.
MAY 13, 1940
INDEX 30-3-56