


1108

3017

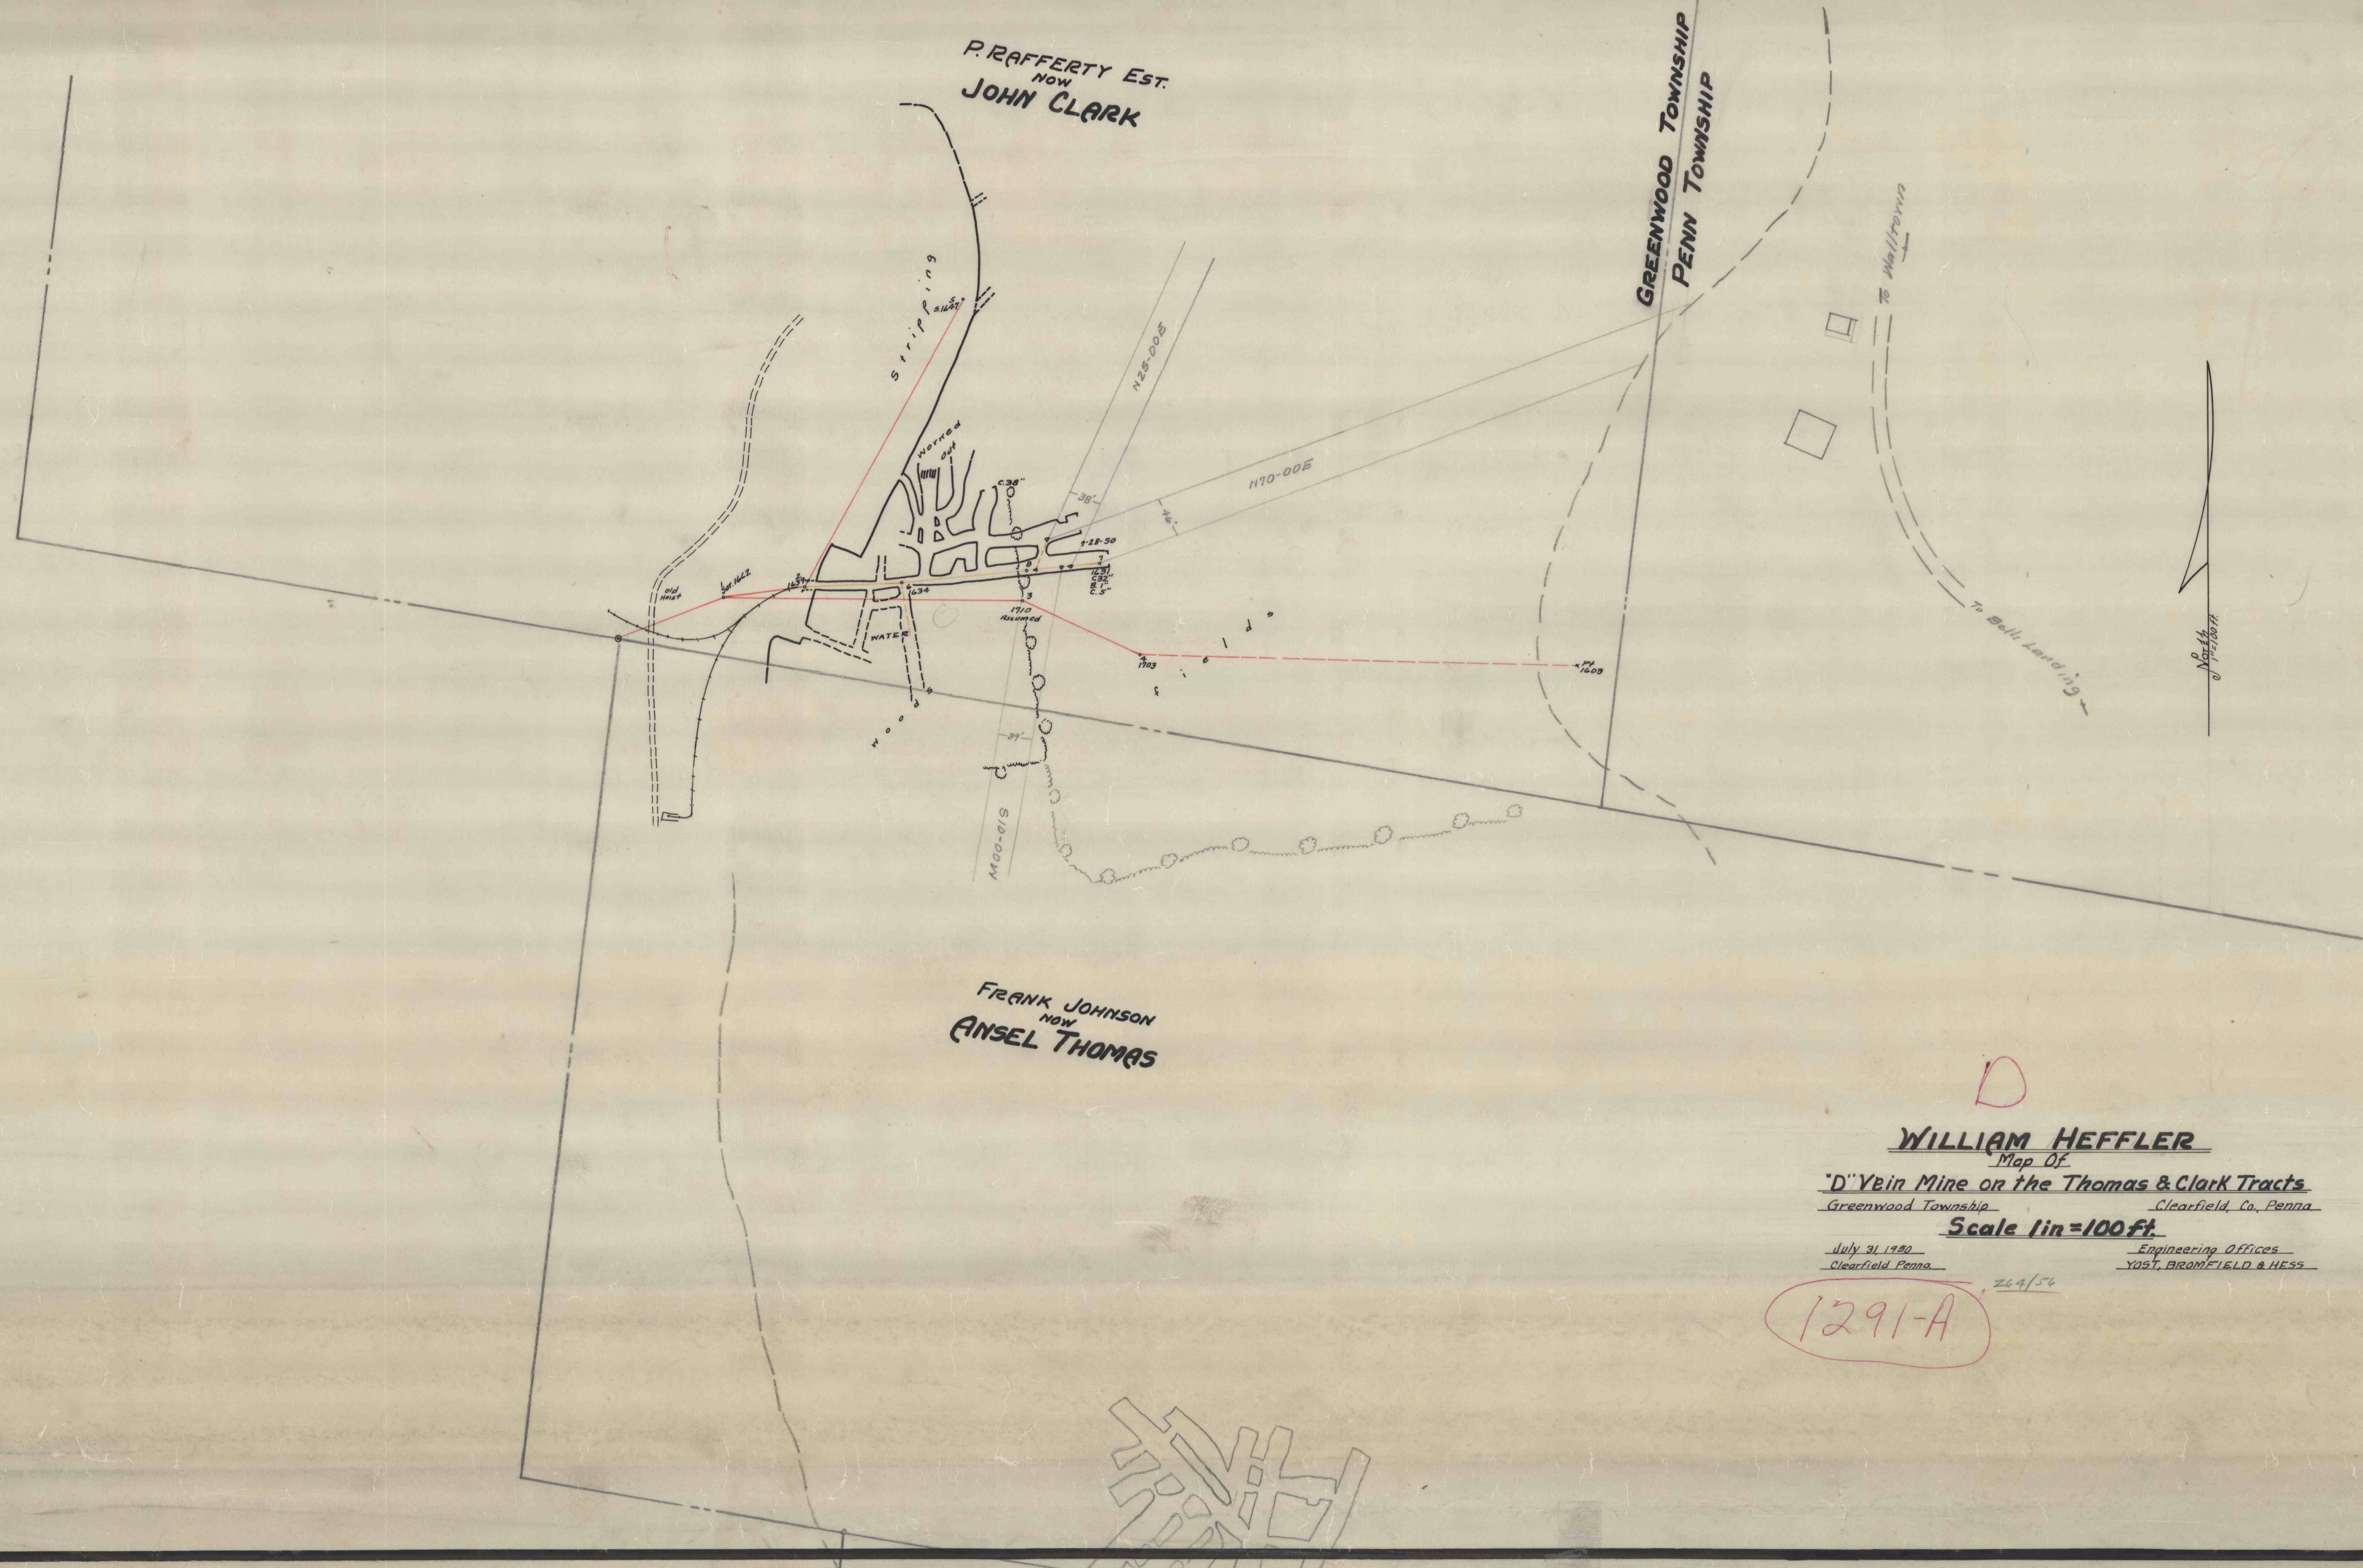

D

WILLIAM HEFFLER
 Map Of
"D"Yein Mine on the Thomas & Clark Tracts
 Greenwood Township Clearfield, Co., Penna.
 Scale 1 in = 100 ft.
 July 31 1950 Clearfield Penna. Engineering Offices
 YOST, BRAMFIELD & HESS

1291-A

