

James Cassidy

Lawhead Heirs,

Miles Fullerton.

Clearfield Steel & Iron Co.

James McPherson

To Hyde City, Public Road

N. 4° 41' E. 33.45'

(N 3° E. 201.2 P)

PD



Survey Of Coal Mine,  
of the  
Clearfield Steel & Iron Co.  
in relation to  
lands of,  
James Cassidy.

Lawrence Twp. Clearfield County, Pa.  
Scale 1"=100'

Clearfield Pa.  
Dec. 2- 1910

Office of, E. W. Hess,  
Engineer,

833A

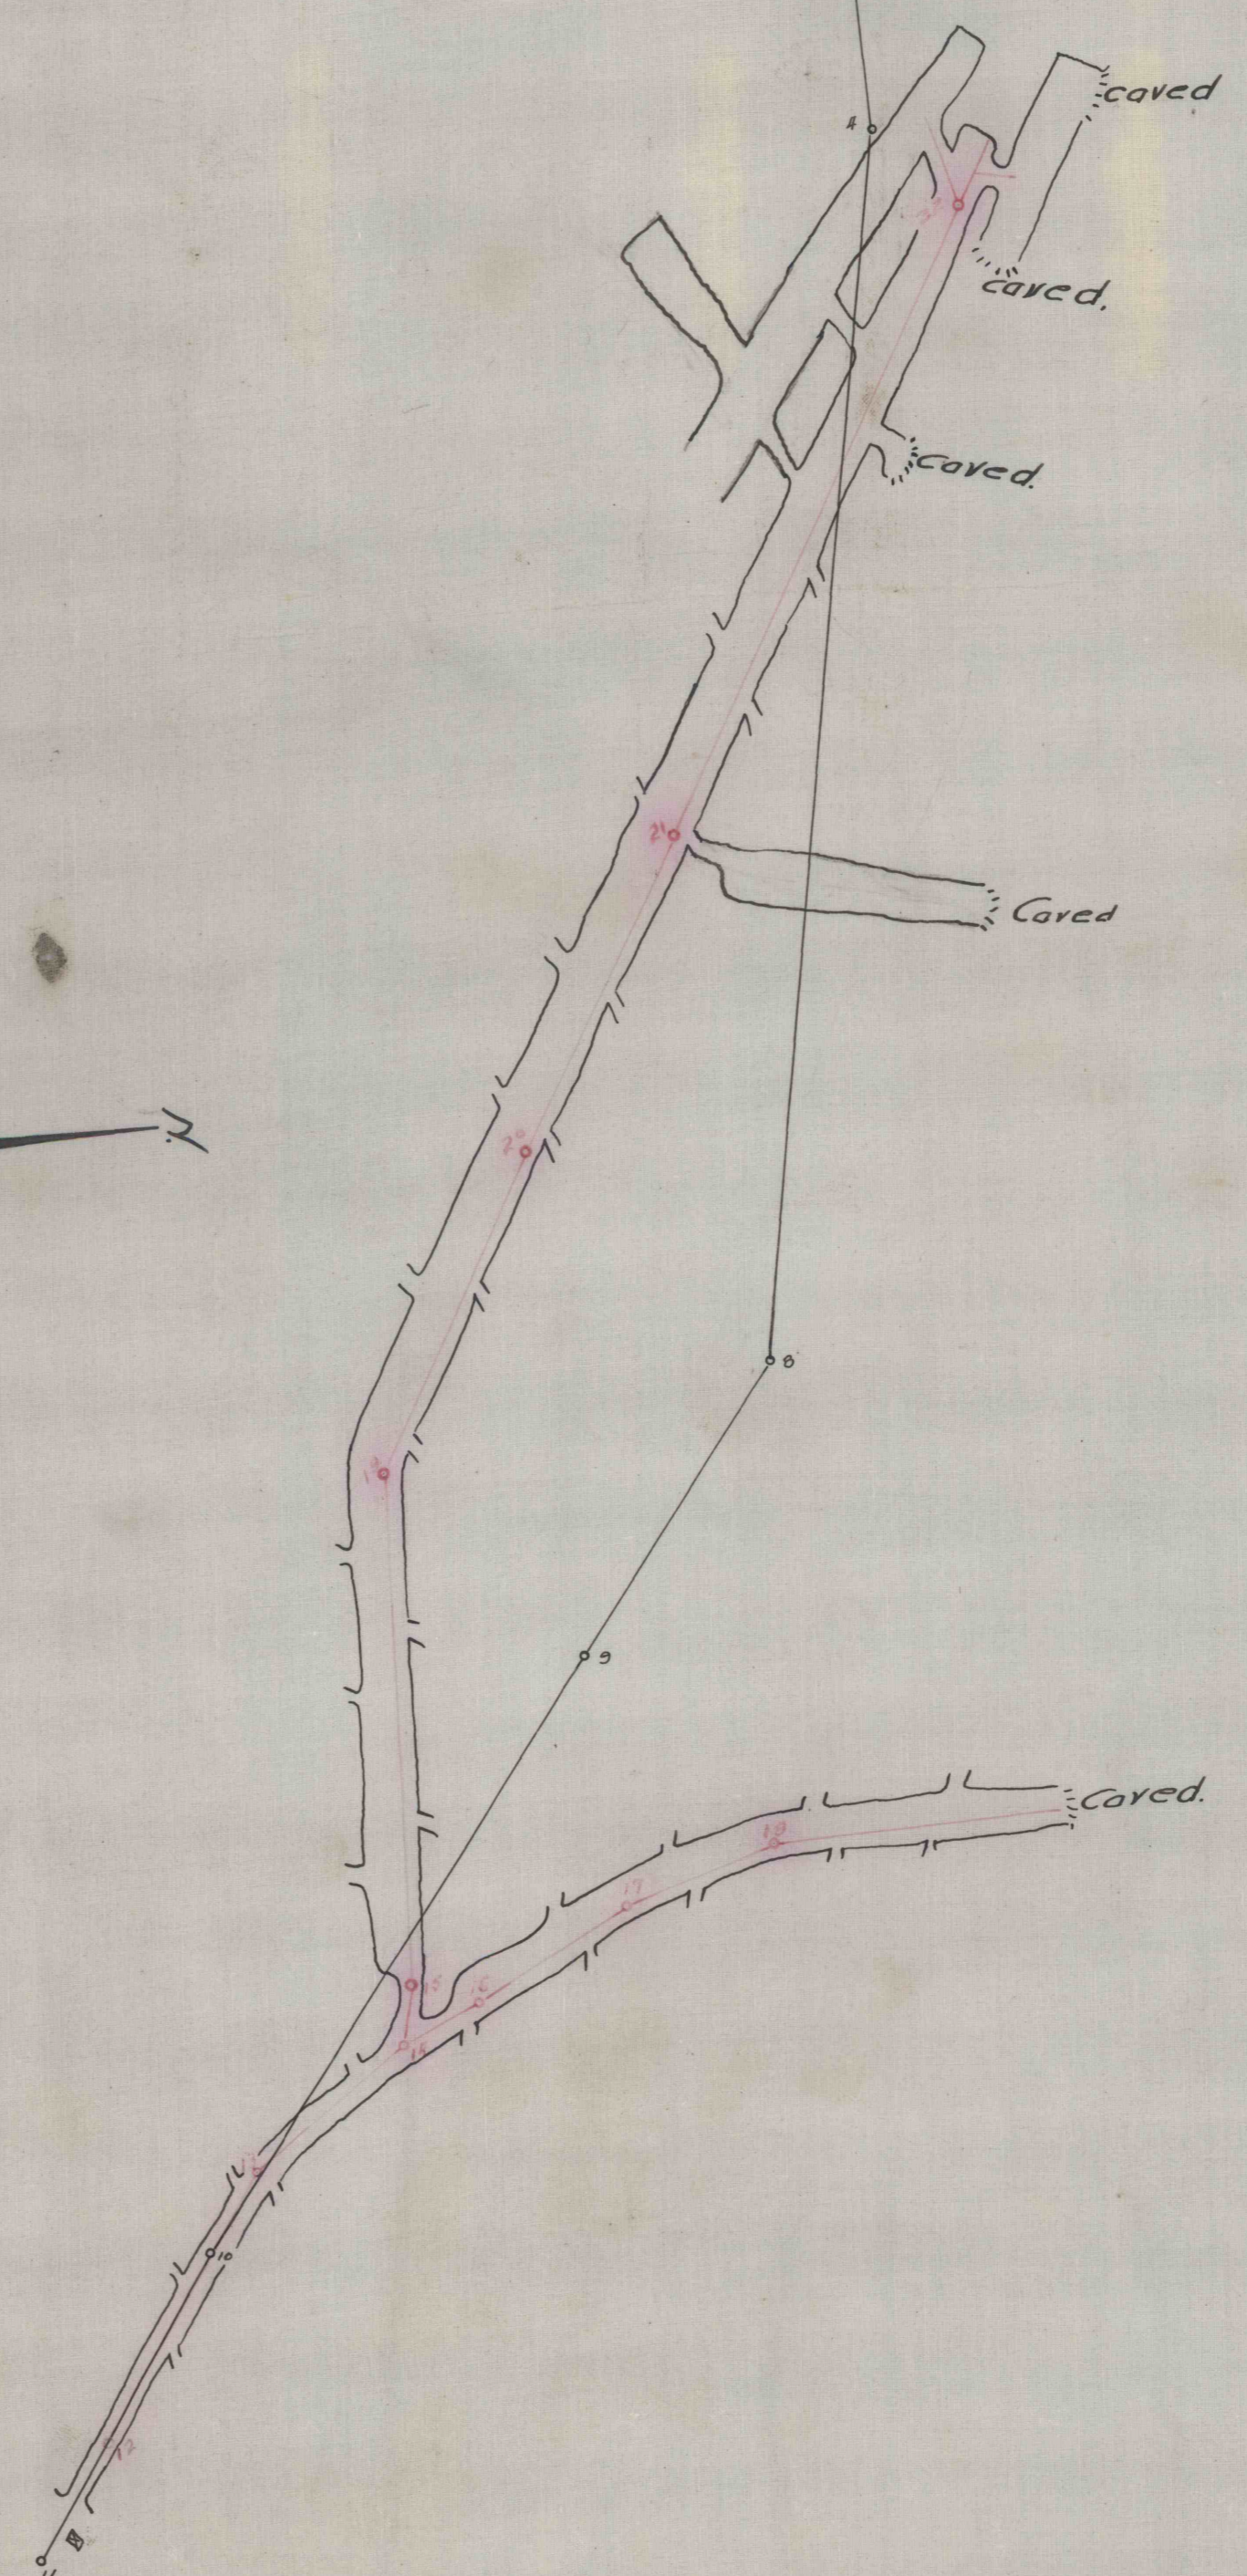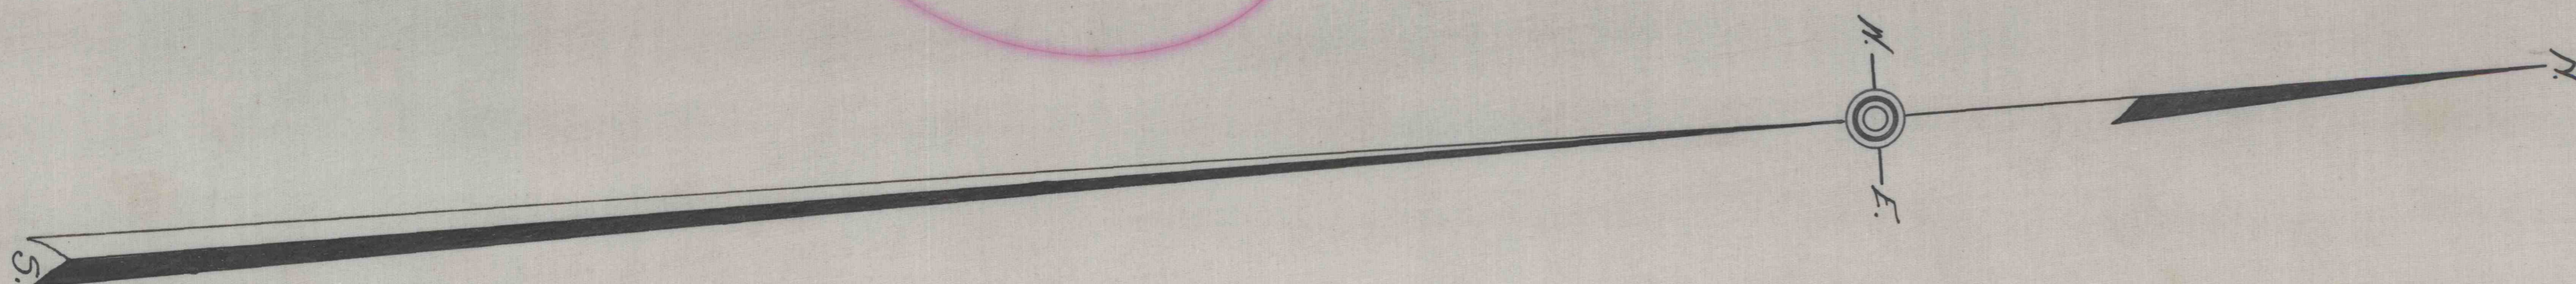

3097

Book 47

J.W.H.