


DM

TH. FORCEY ESTATE  
K & J COAL CO.

1215

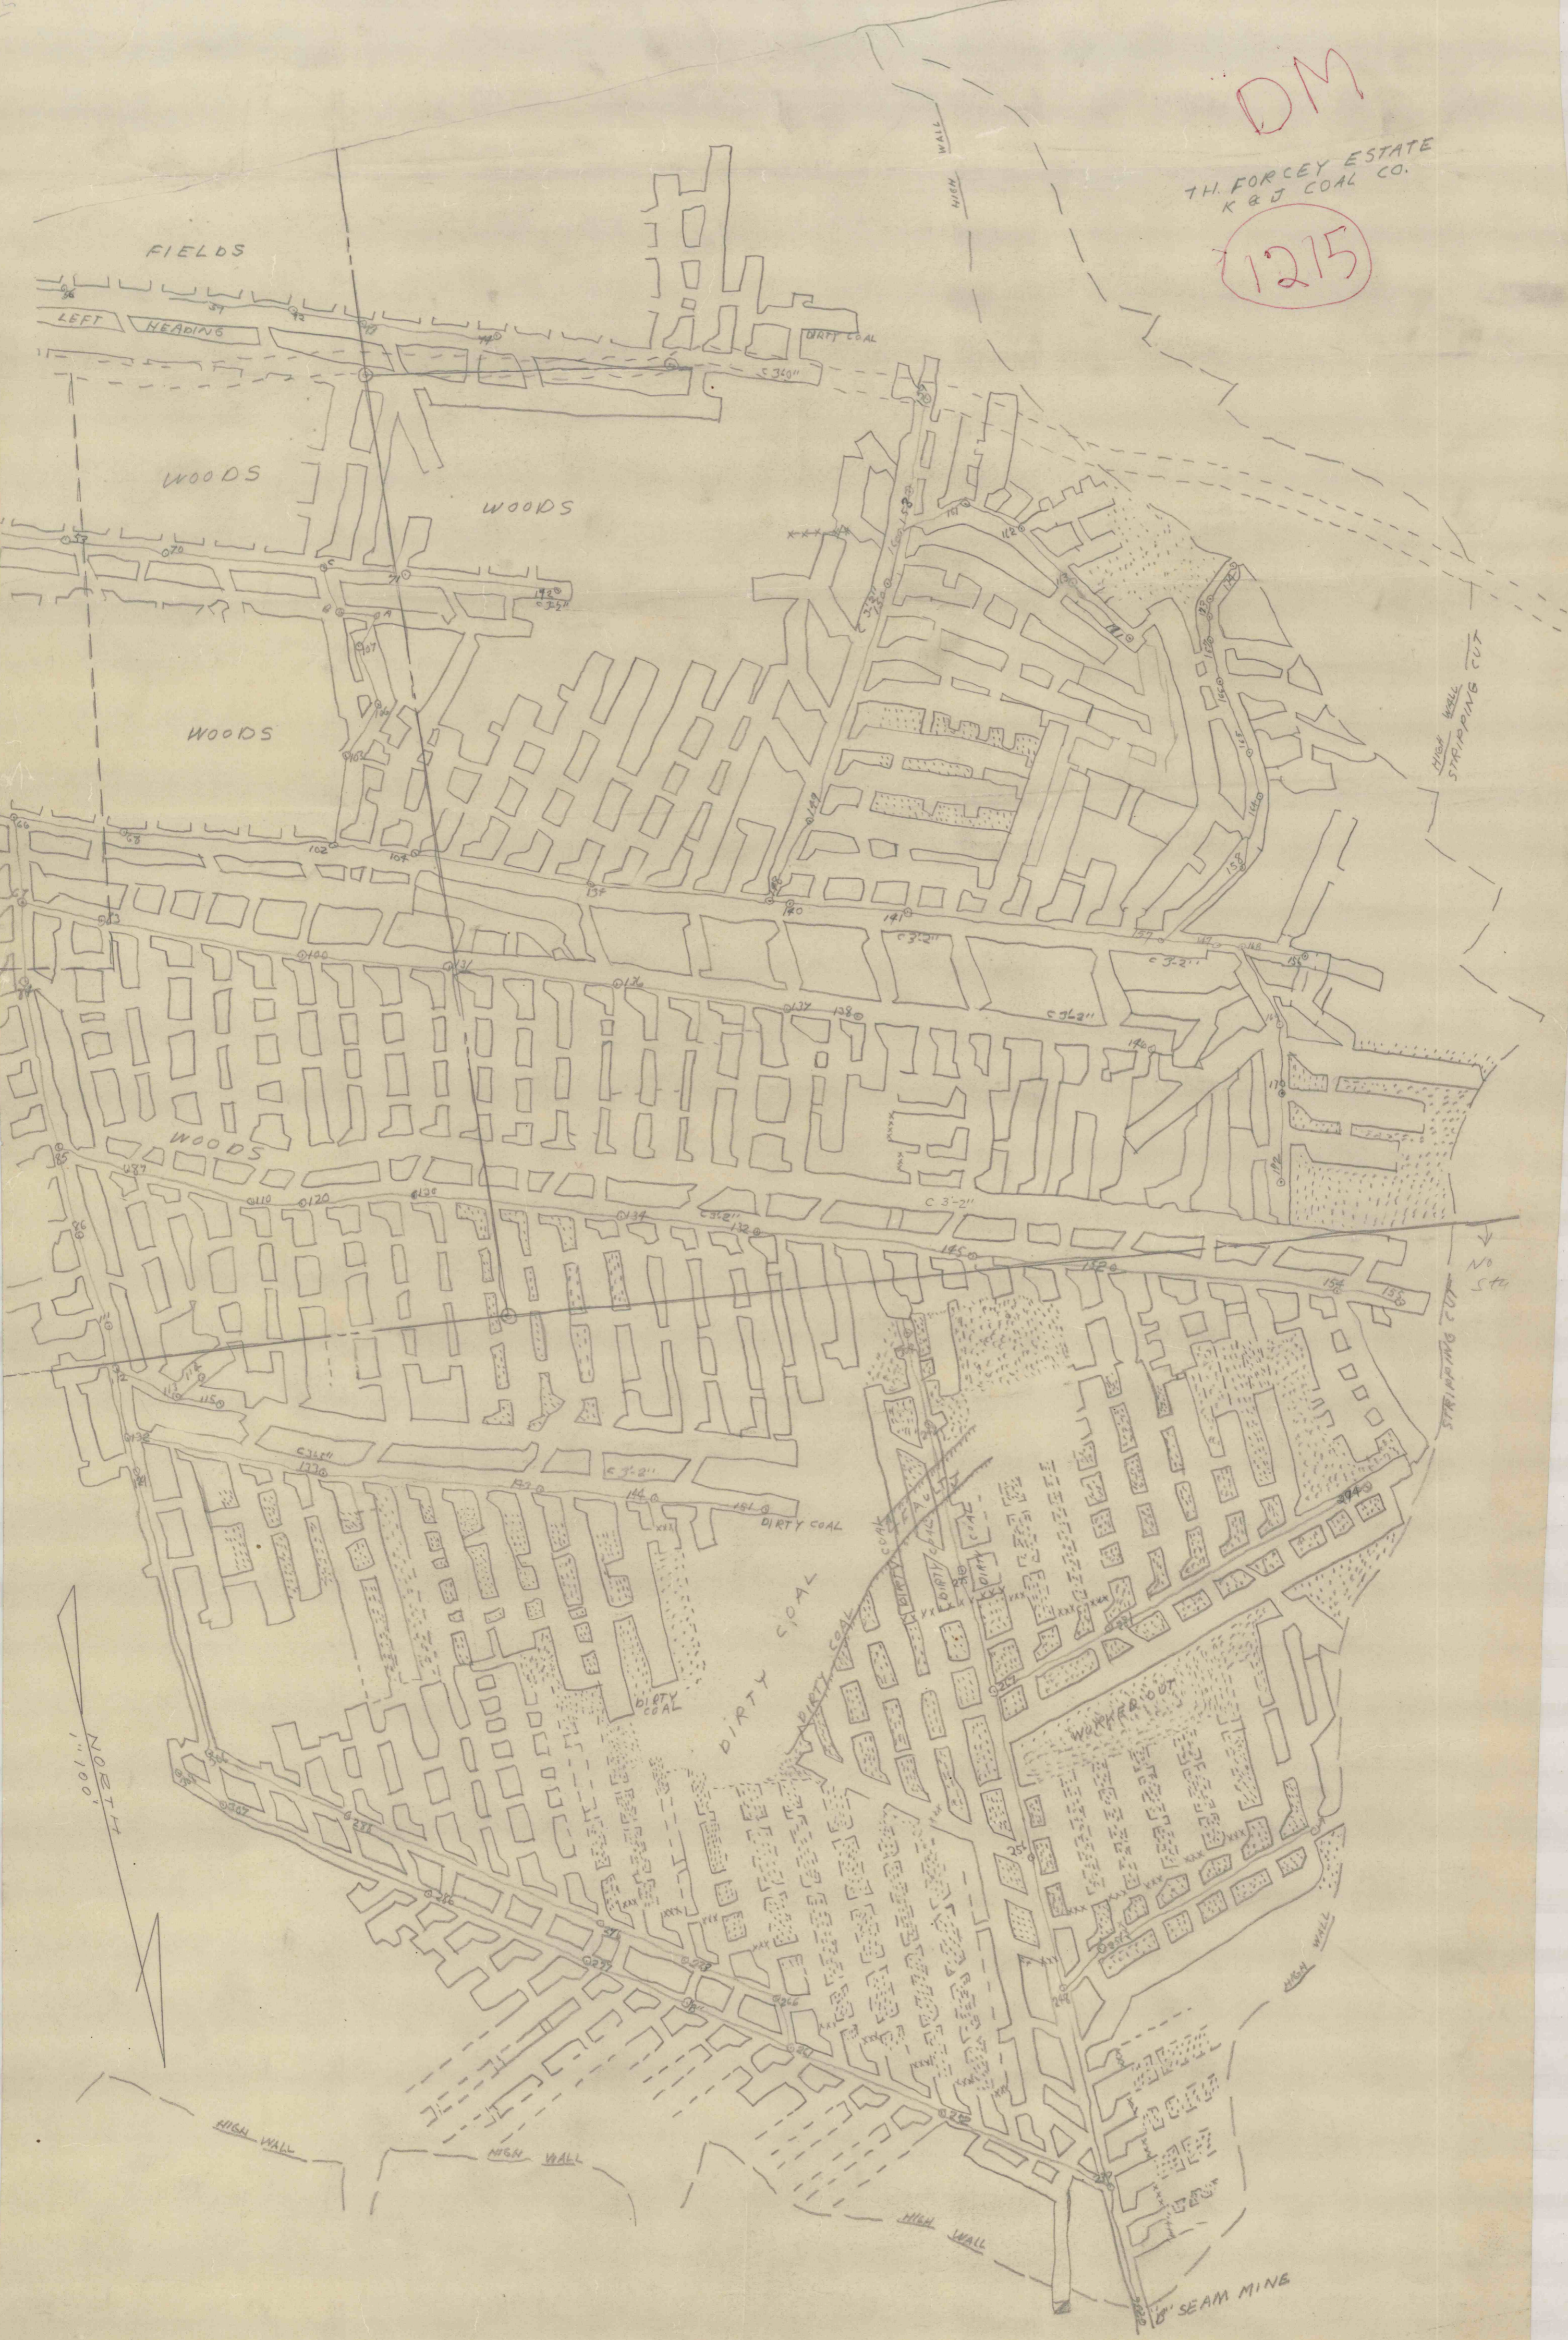

3196

3196