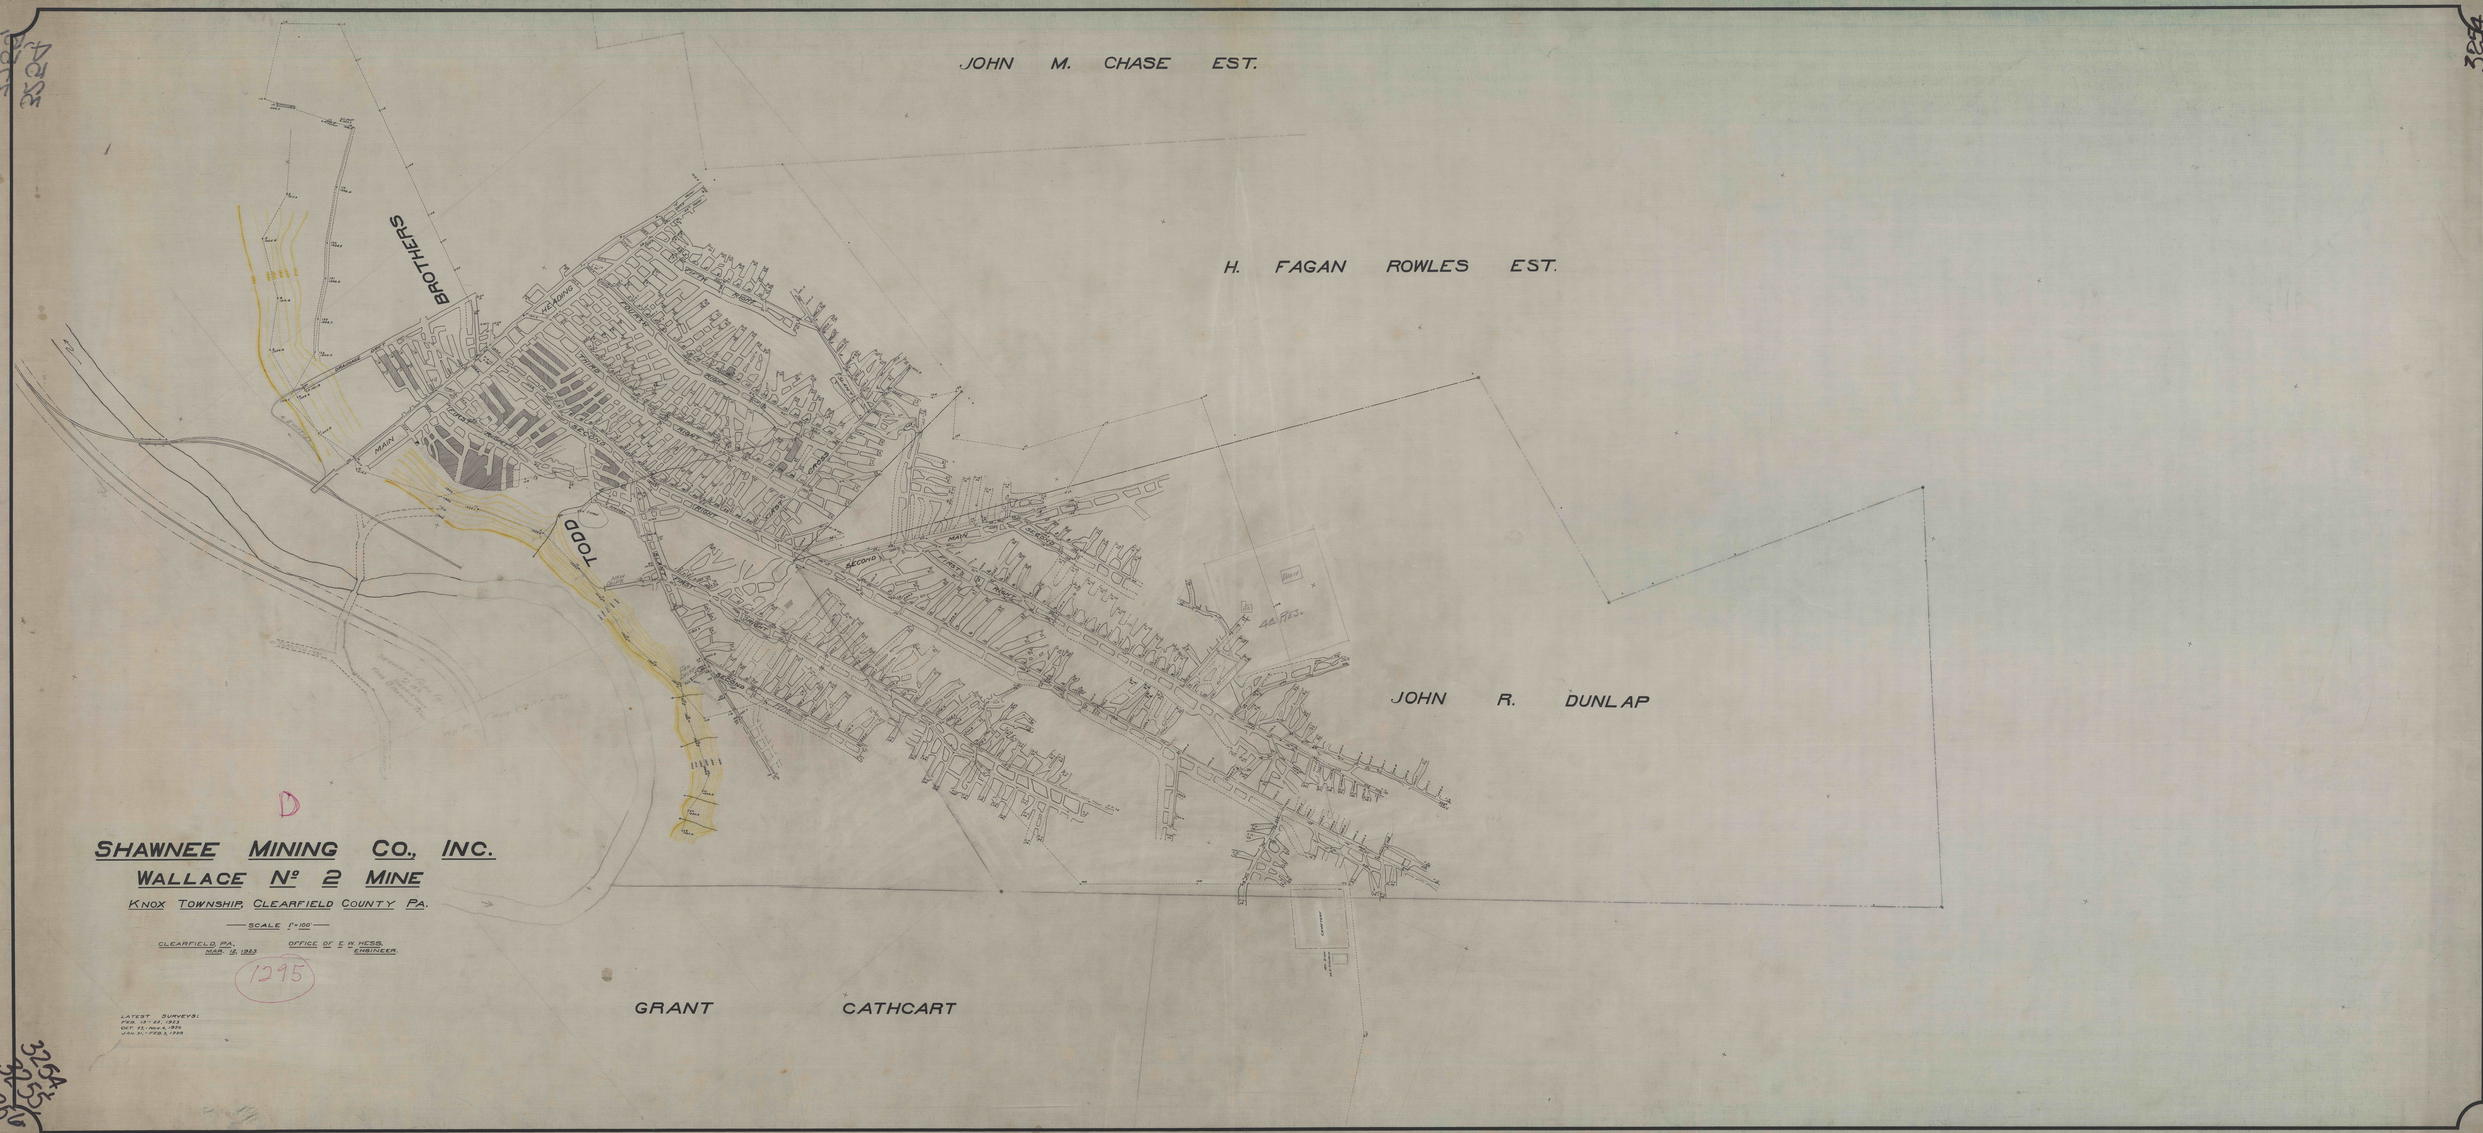
JOHN M. CHASE EST.
H. FAGAN ROWLES EST.
JOHN R. DUNLAP
GRANT CATHCART
BROTHERS
TODD
MAIN
SECOND
SHAWNEE MINING CO., INC.
WALLACE Nº 2 MINE
KNOX TOWNSHIP, CLEARFIELD COUNTY PA.
SCALE 1"=100'
CLEARFIELD PA.
OFFICE OF E. W. HESS,
ENGINEER.
1295
LATEST SURVEYS:
FEB. 13-27, 1913
OCT. 15-NOV. 4, 1918
JAN. 21-FEB. 3, 1919
3254
3255
3256