


4952


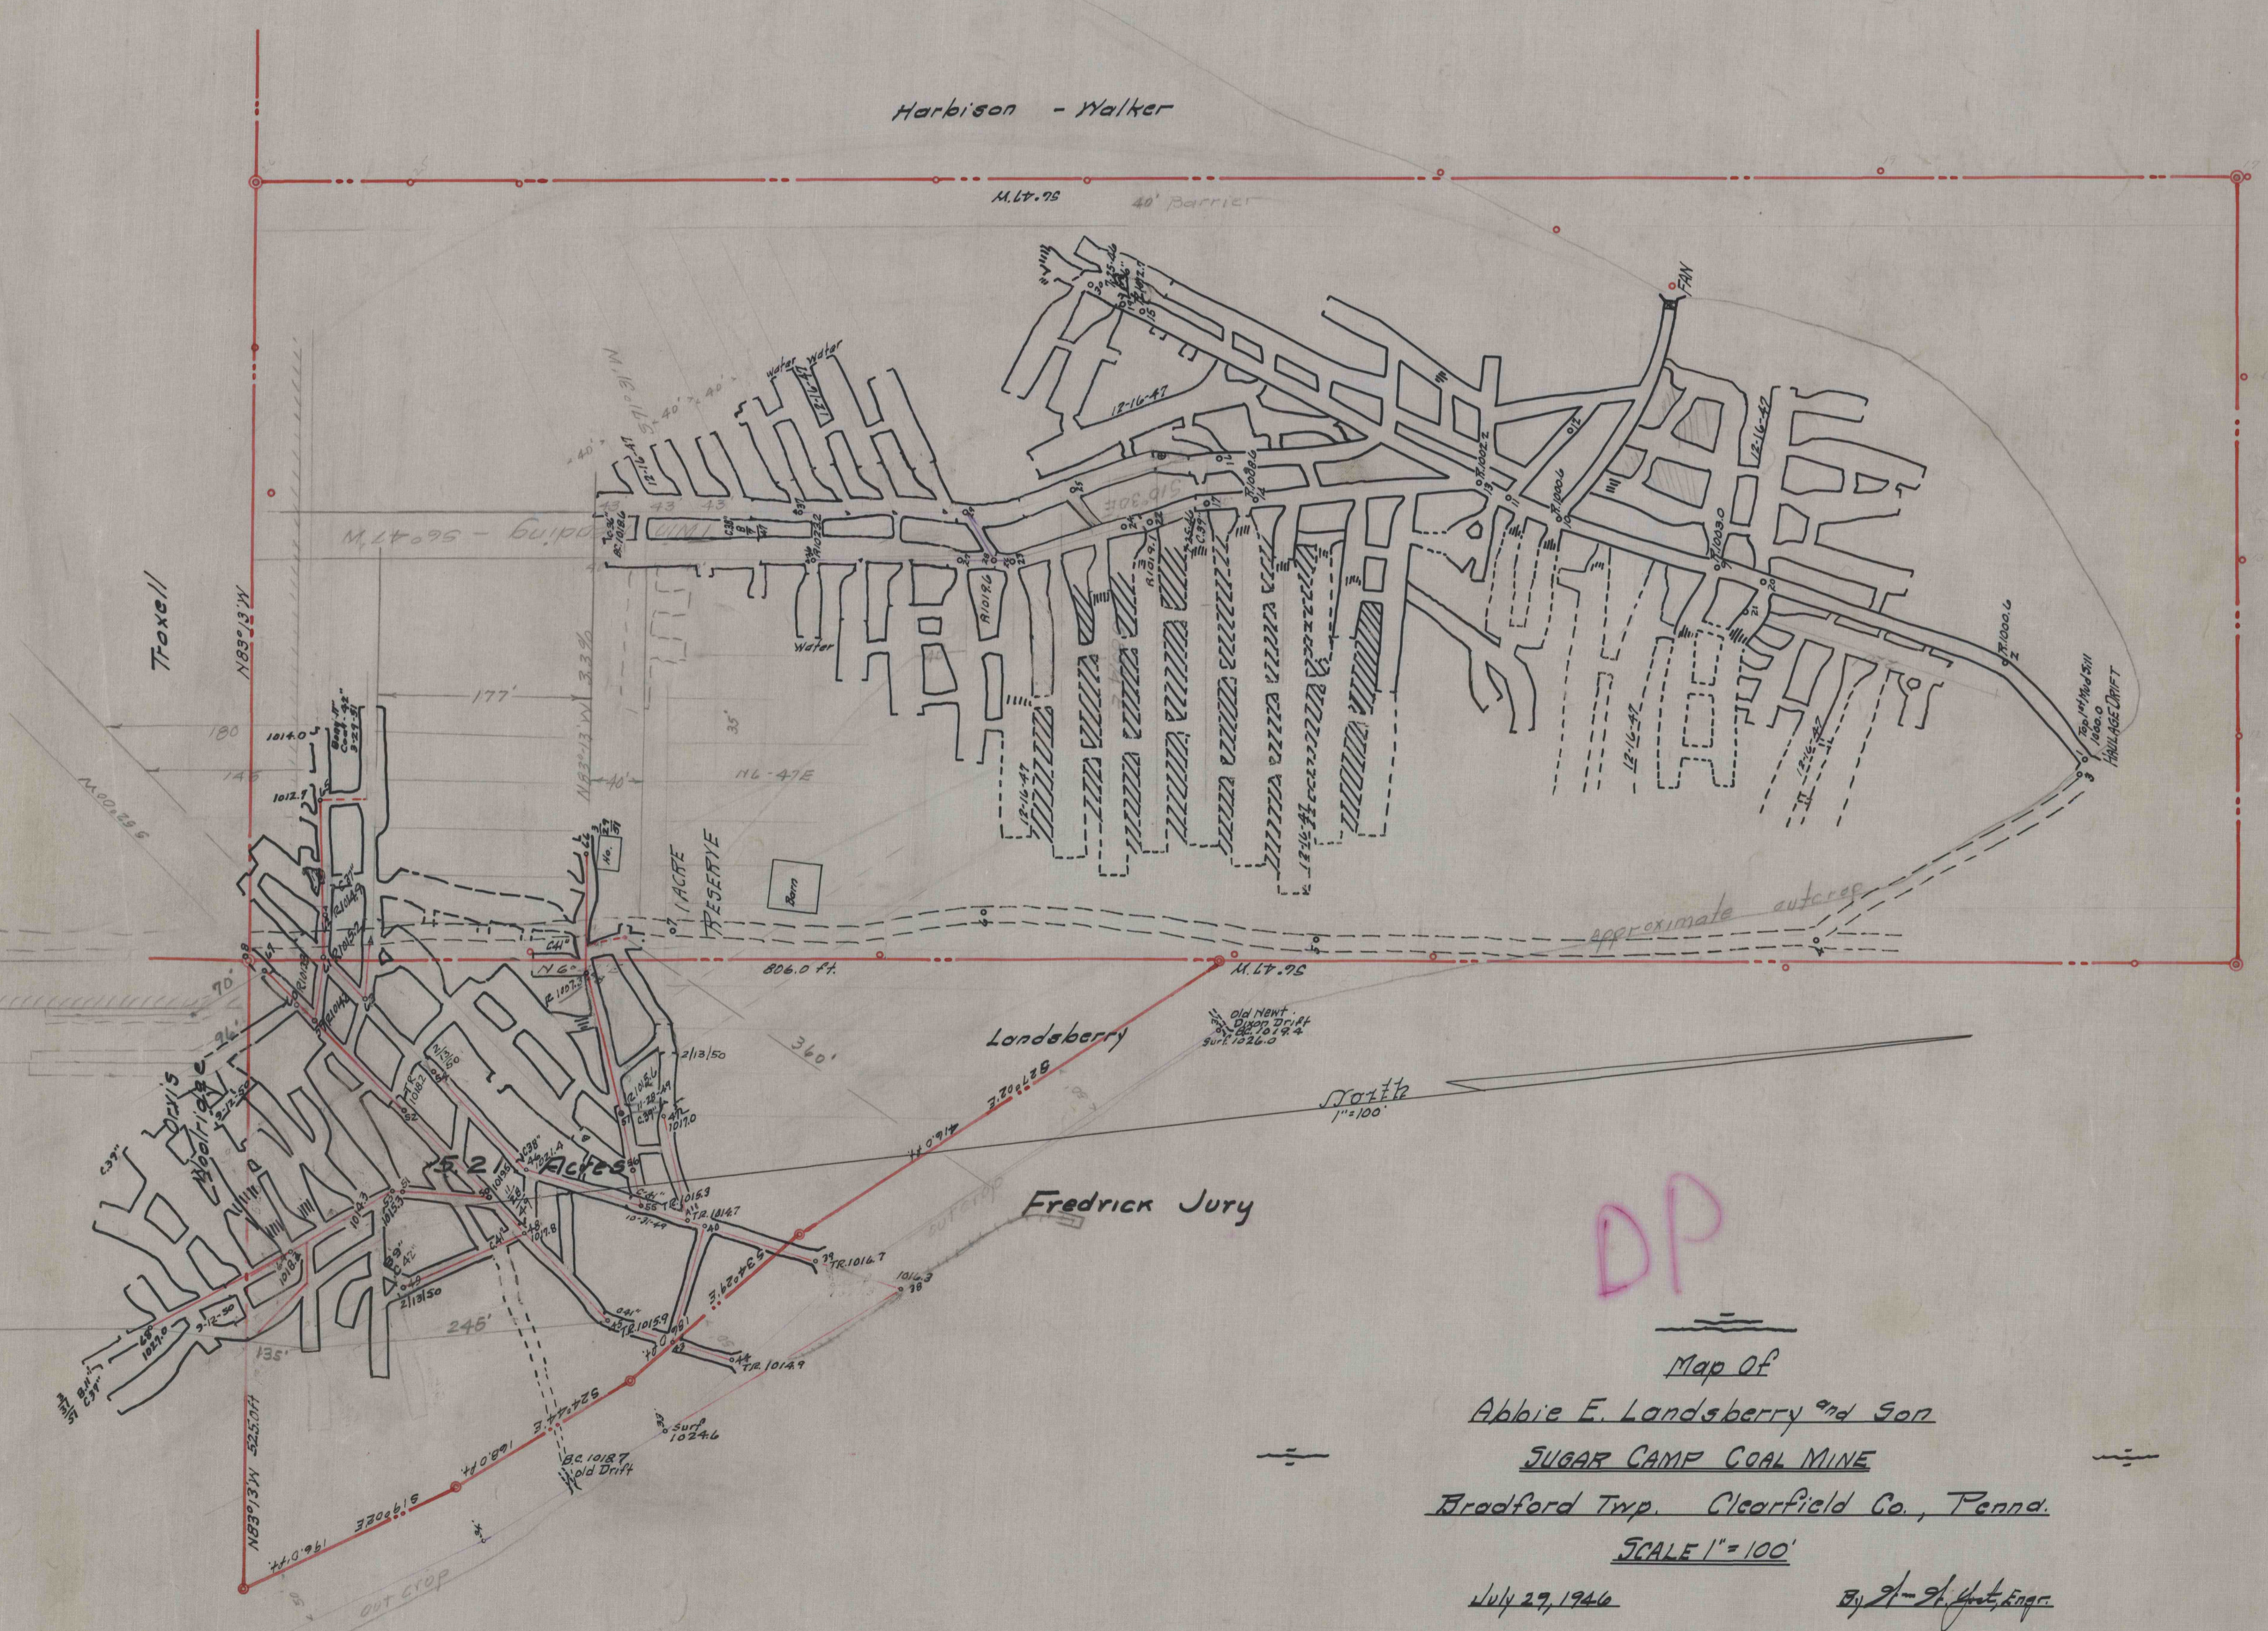

DP

Map of  
 Abbie E. Landsberry and Son  
 SUGAR CAMP COAL MINE  
 Bradford Twp. Clearfield Co., Penna.  
 SCALE 1" = 100'  
 By J. J. [Signature]  
 No. 263 P. 101 -  
 File 1209

1209

3274

