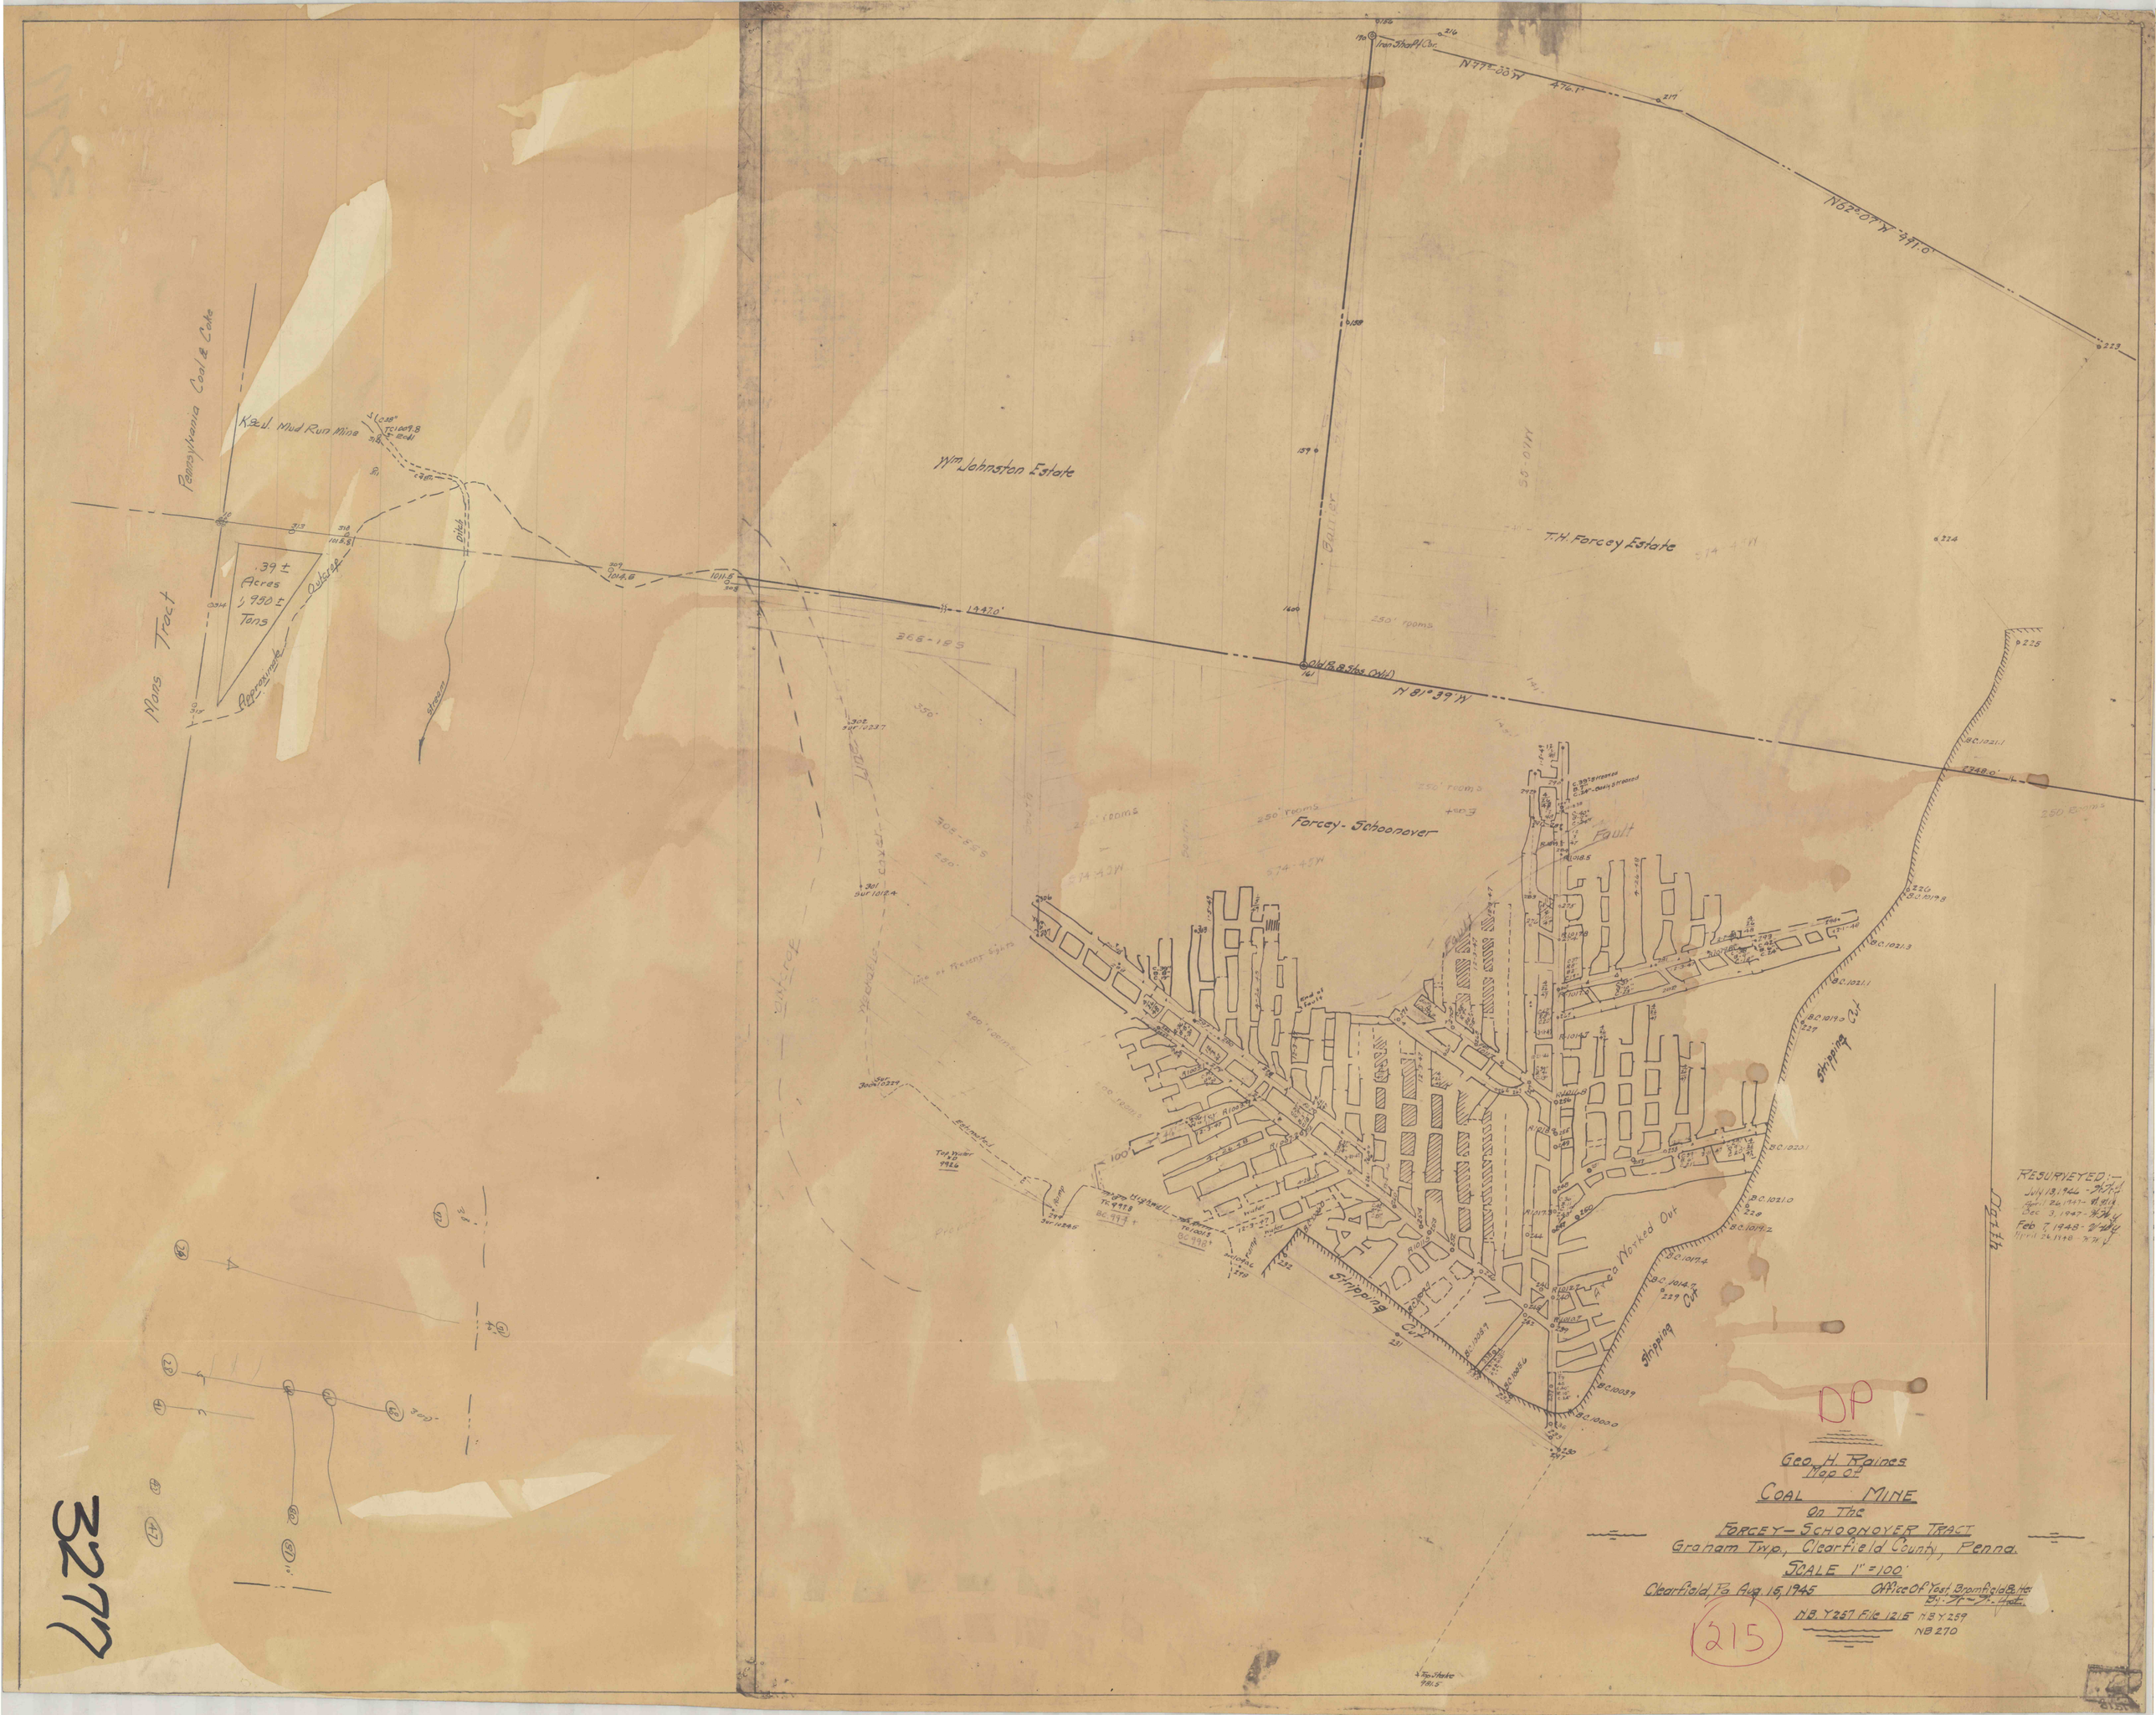

Pennsylvania Coal & Coke
K.&J. Mud Run Mine
Mons Tract
.39 ± Acres
1,950 ± Tons
Approximate Outcrop
Ditch
Stream
Wm Johnston Estate
T.H. Forcey Estate
Barrier
N 77°-00' W 476.1'
N 62°-07' W 491.0'
N 81°39' W
1447.0'
Old R.R. Stos. (Wit)
Forcey-Schoonover
Fault
Stripping Cut
Area Worked Out
Stripping Cut
Stripping Cut
Depth
RESURVEYED:-
July 13, 1946 - W.H.Y.
April 26, 1947 - W.H.Y.
Dec 3, 1947 - W.H.Y.
Feb 7, 1948 - W.H.Y.
April 26, 1948 - W.H.Y.
DP
Geo. H. Raines
Map of
COAL MINE
On The
FORCEY-SCHOONOVER TRACT
Graham Twp., Clearfield County, Penna.
SCALE 1" = 100'
Clearfield, Pa. Aug. 15, 1945
Office Of Yost, Bromfield & Hess
By: H. - H. Yost.
N.B. Y257 File 1215
N.B. Y259
NB 270
215
3277