


PENNSYLVANIA STATE FOREST

2652.0'

PENNSYLVANIA STATE FOREST

Top vein

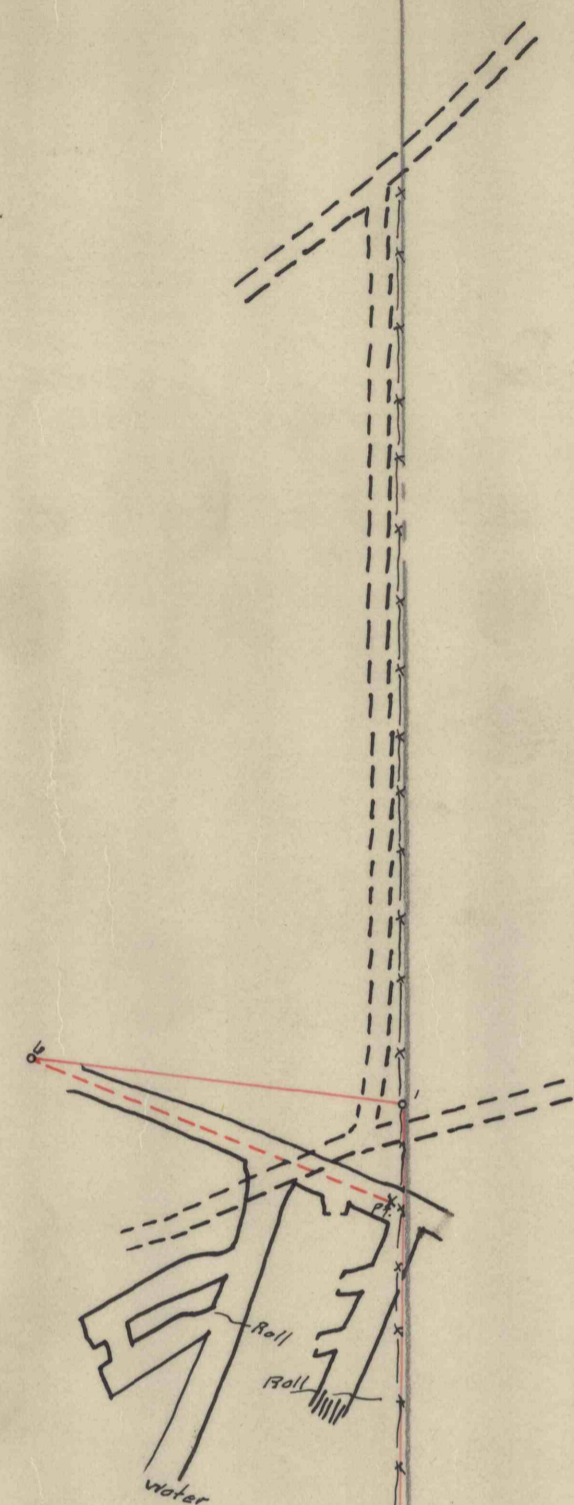

Now or Formerly
MRS MURPHY

Field

Now or Formerly
"BUD" GAINES

HARRY SMITH Map
Showing
MINING OPERATION ON THE ISRAEL CONWAY TRACT
KATHAUS TOWNSHIP CLEARFIELD COUNTY
SCALE 1"=100'
JANUARY 14, 1948
YOST BROMFIELD & HESS
CLEARFIELD PENNA.
NO. 212, BY SA. FILE-1267

1267

3293

3293