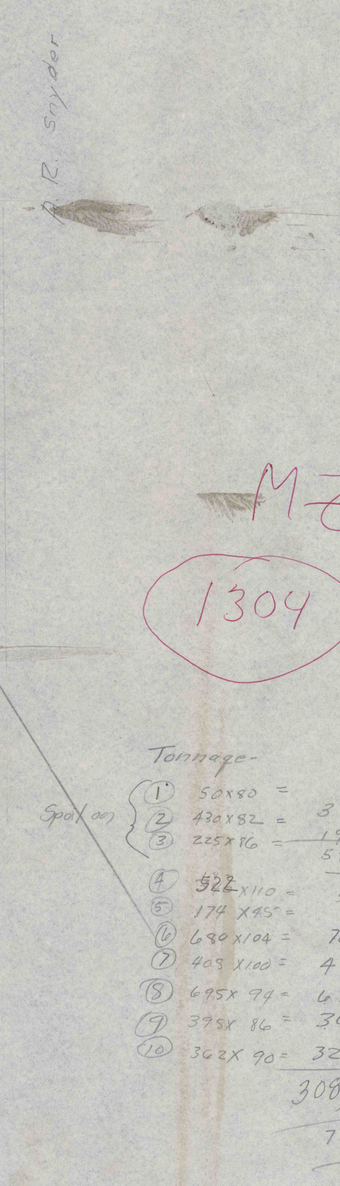

MZ

1304

3200 ONT

Tonnage-

Spoil on

(1)	50 x 80	=	4000
(2)	430 x 82	=	35260
(3)	225 x 86	=	19350
			58610 sq ft
(4)	~~522~~ x 110	=	57420
(5)	174 x 45	=	7830
(6)	680 x 104	=	70720
(7)	408 x 100	=	40800
(8)	695 x 94	=	65330
(9)	398 x 86	=	34228
(10)	362 x 90	=	32580
			308908 sq ft















