


T. H. Forcey Estate
(C. W. Beam Coal Lease)

P. B. Mens

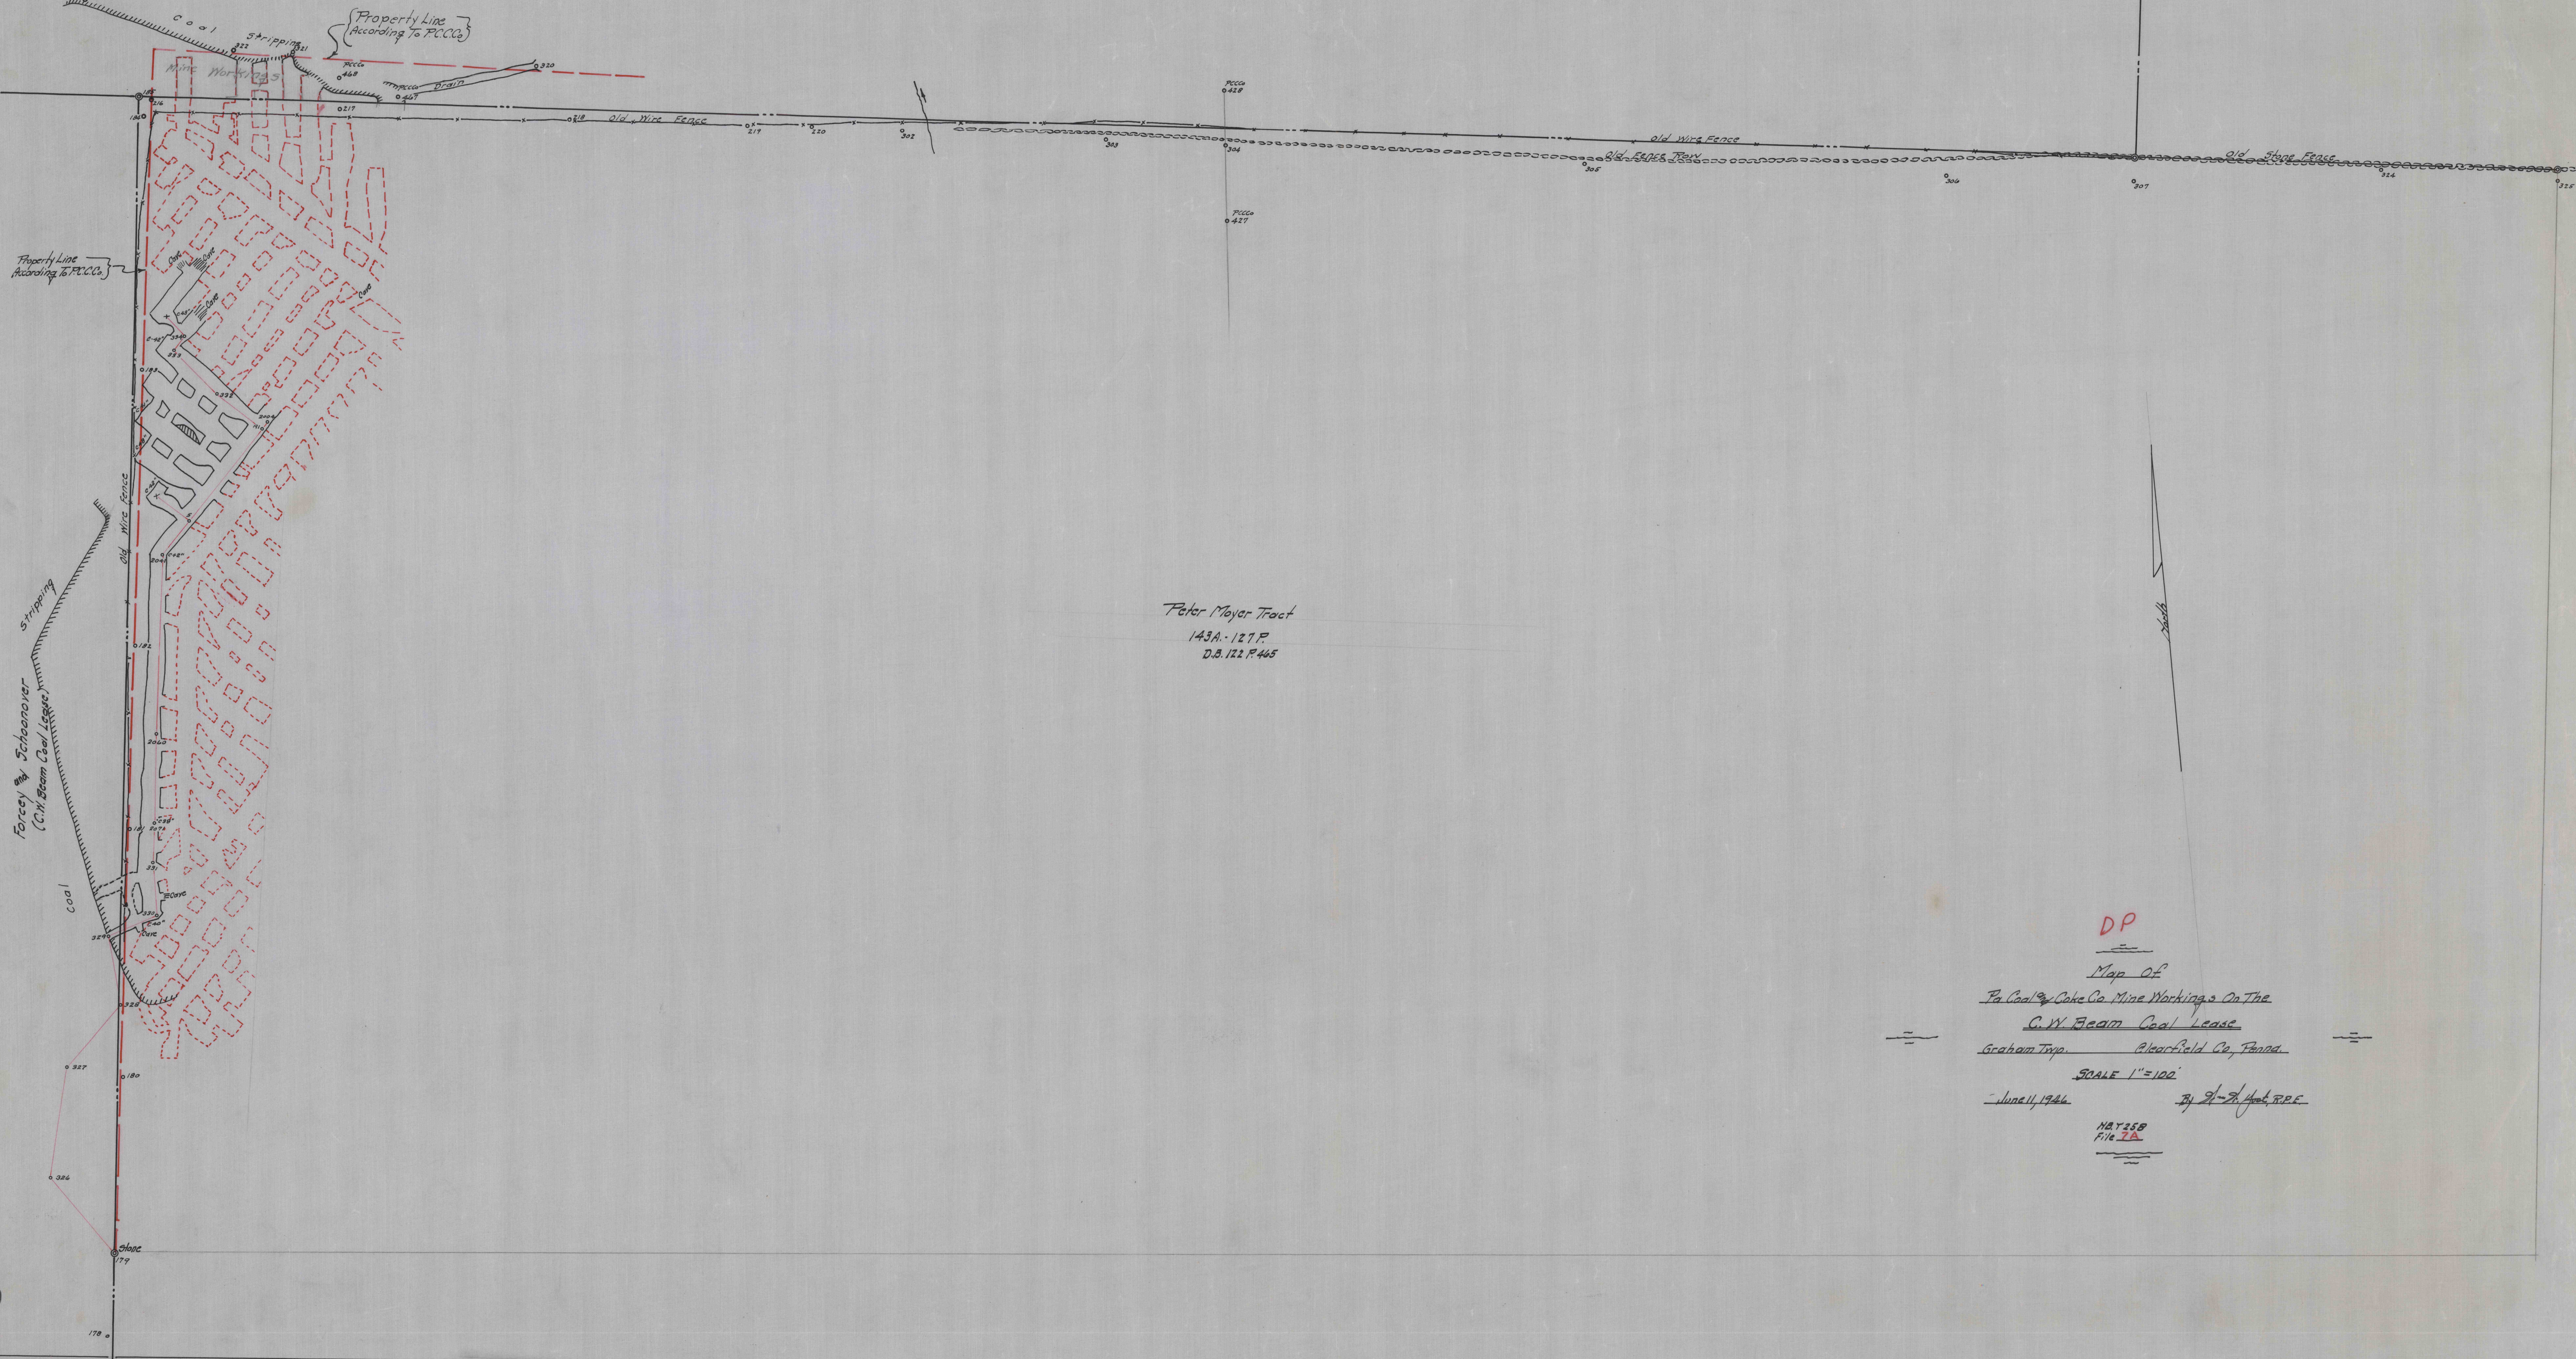

Peter Meyer Tract
143A-127P
D.B. 122 P 445

DP
 Map of
 Pa. Coal & Coke Co. Mine Workings on the
 C. W. Beam Coal Lease
 Graham Twp. Clearfield Co., Penna.
 SCALE 1"=100'
 June 11, 1946 By J. H. Hub. R.P.E.
 NAT 258
 File 2A

230

330