

3384

Eli Hono

488

WILLIAM JOHNSON ET AL.

ISAAC H. LEE.

LAND OF NEWTON LEE.

NEWTON LEE.

JOHN LEE.

NEWTON LEE'S HOUSE.

Drift No. 1.

Drift No. 1 1/2.

COAL OPERATION OF THE CLEARFIELD & CAMBRIA COAL & COKE CO.

Drift No. 2.

MAP OF A TRACT OF LAND

- OWNED BY -

NEWTON LEE.

BURNSIDE TWP., CLEARFIELD COUNTY, PENN.

SHOWING COAL OPERATIONS ON SAME BY THE

CLEARFIELD AND CAMBRIA COAL & COKE CO.,

- SCALE 1"=100' -



CLEARFIELD, PA.
JULY 10. 03.

SURVEYED BEGIN 1898.
DEC. 9-10. 1898.

E. M. NEWS
ENGINEER.

769

14.3 A3

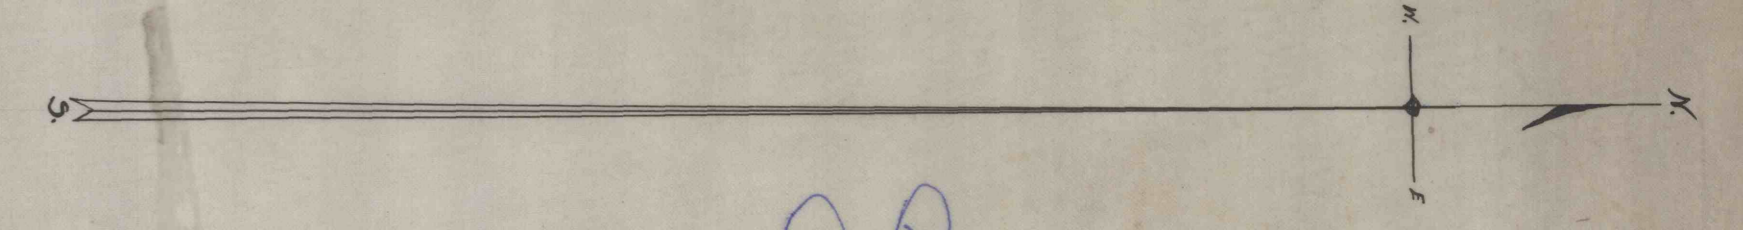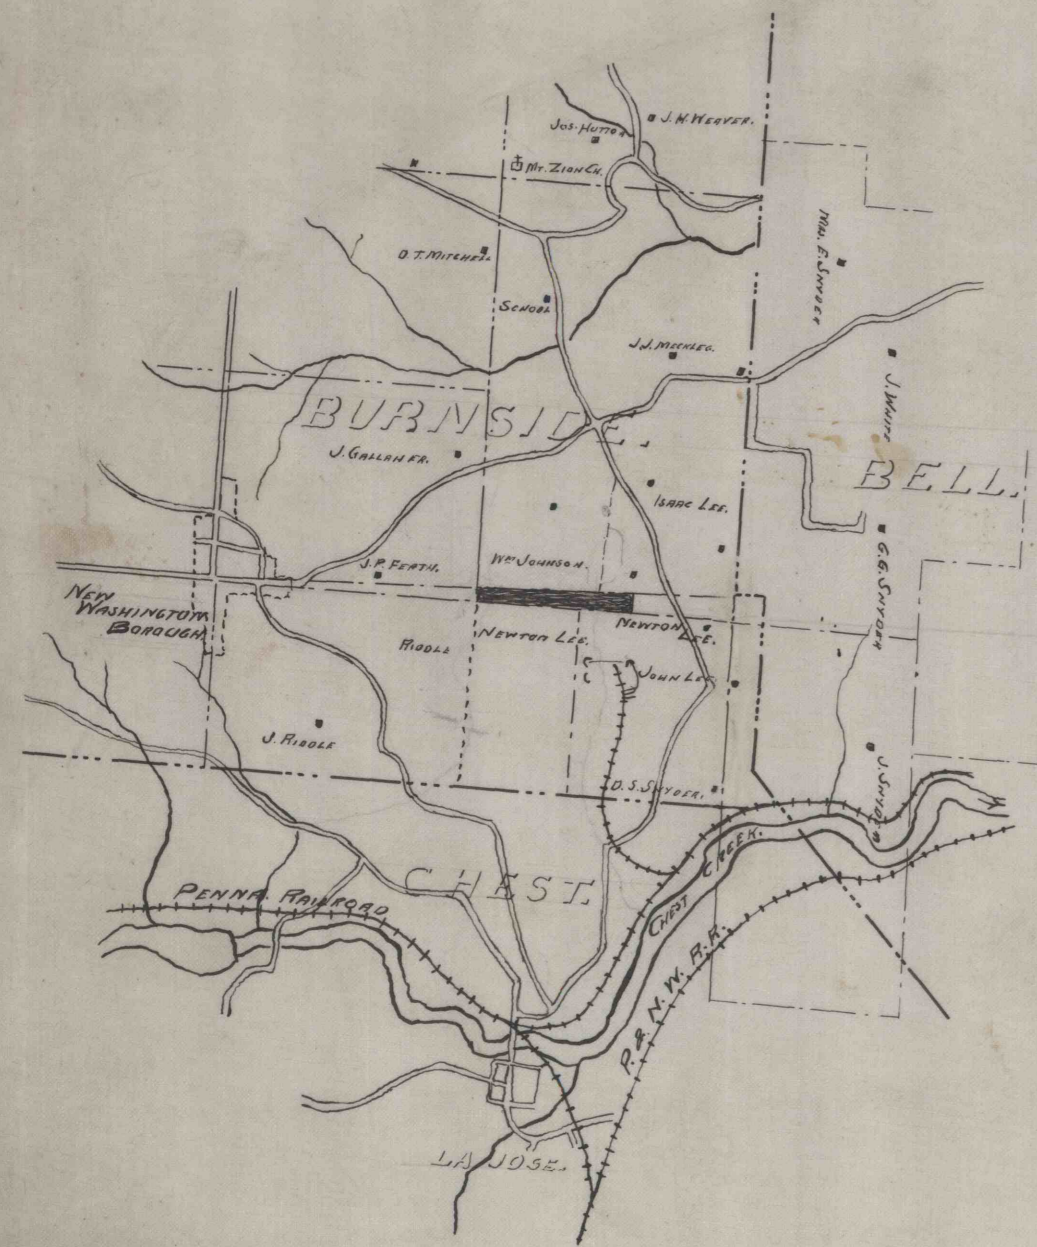

DP