


3391

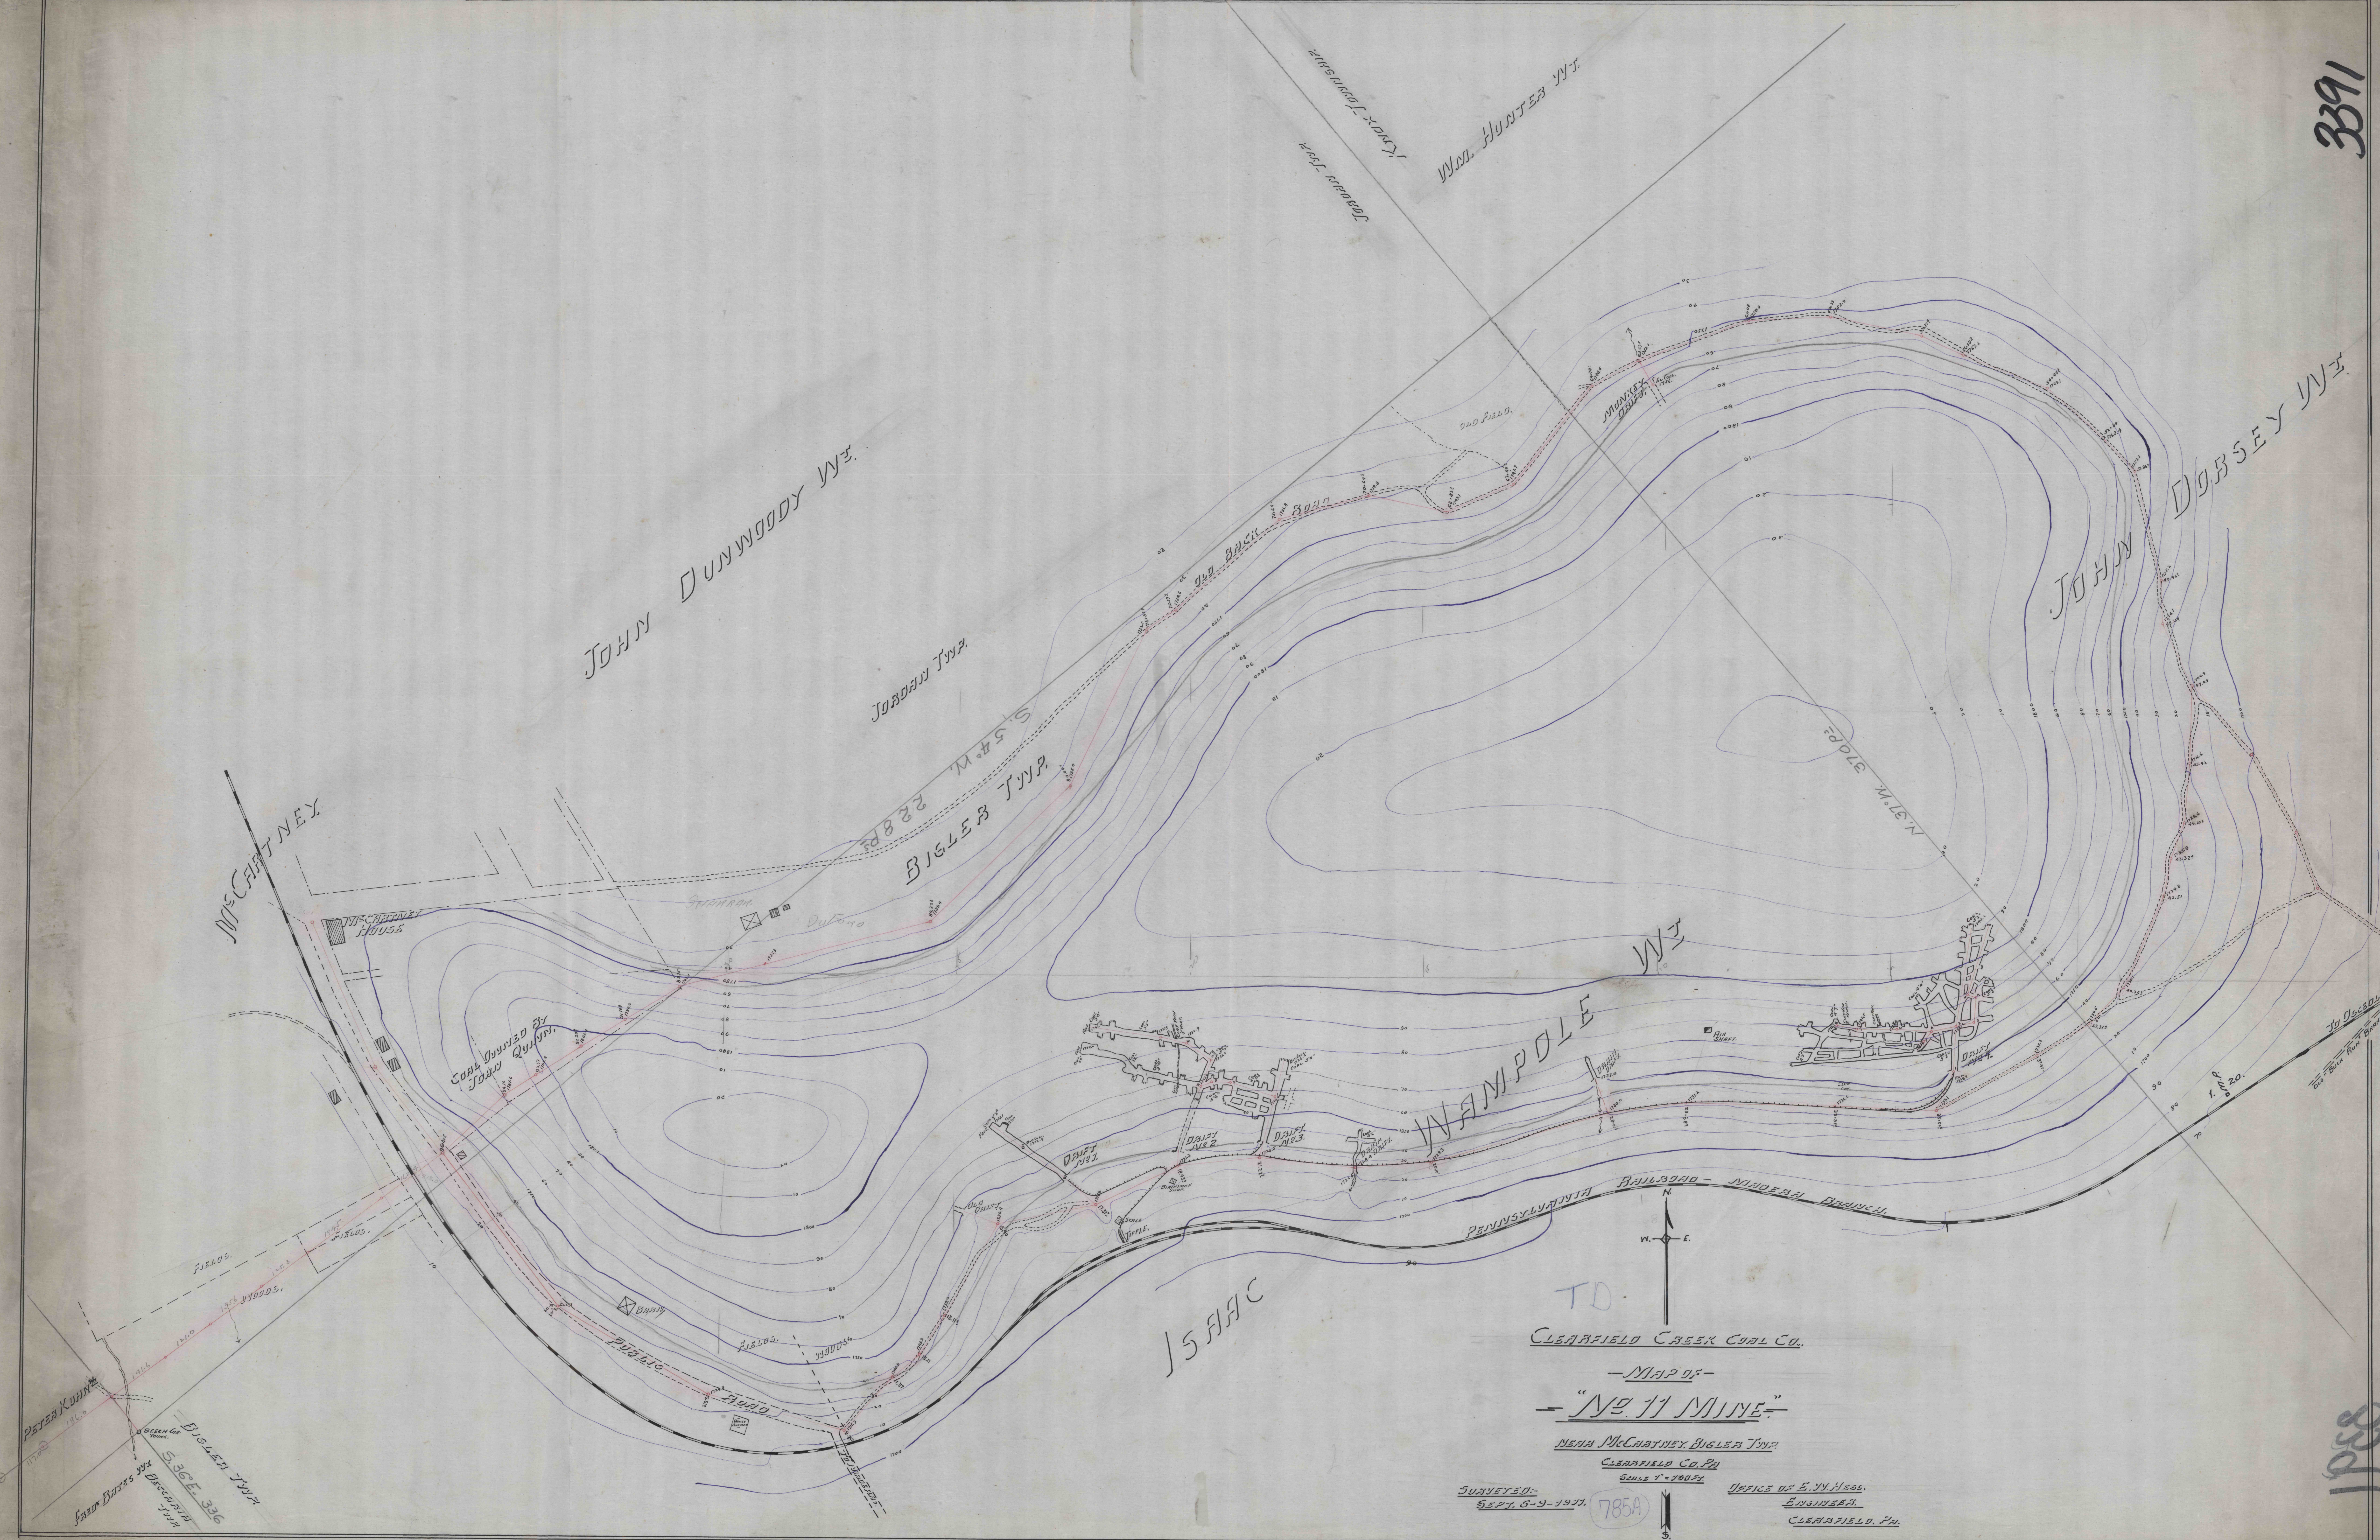

1831