


537

231

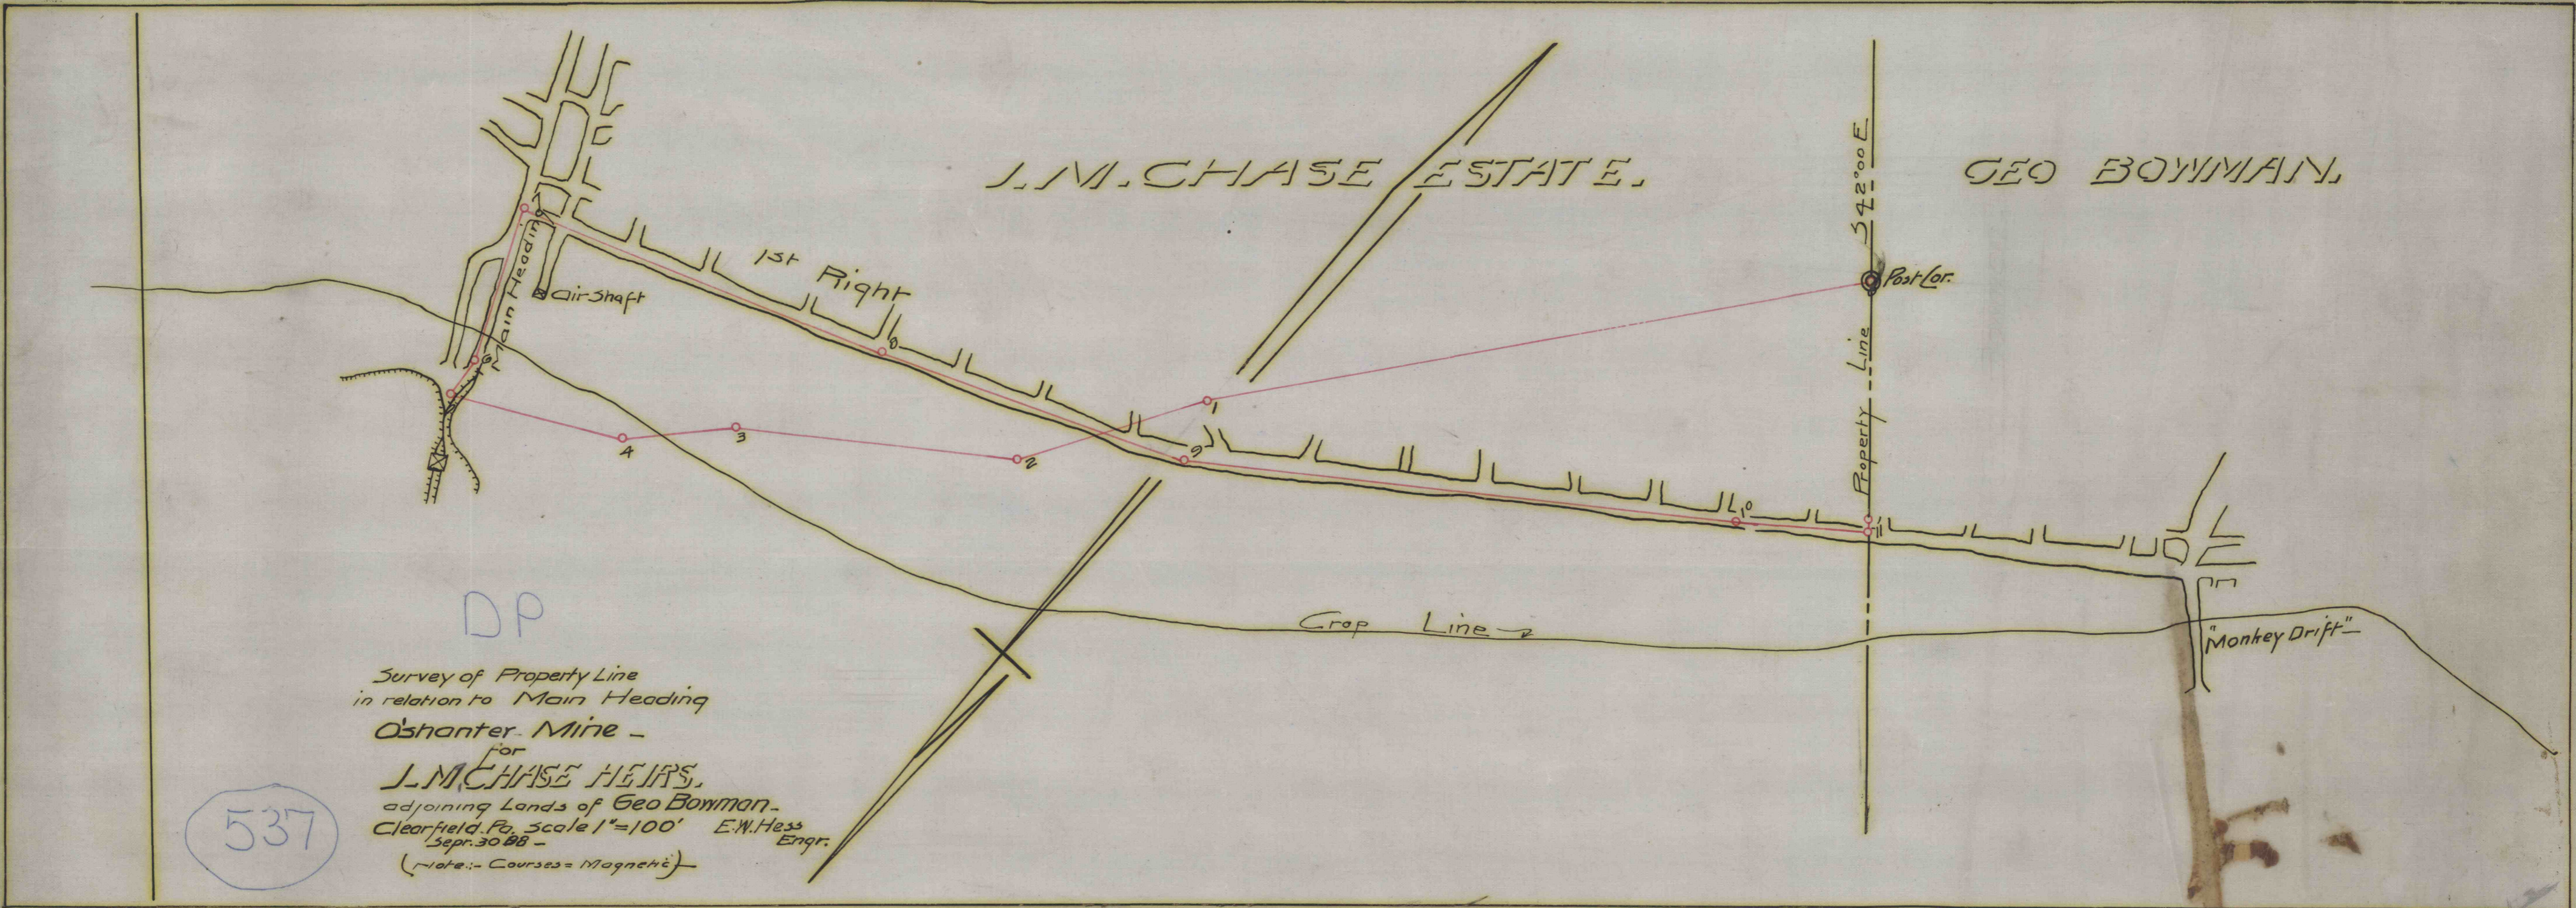

DP

Survey of Property Line  
 in relation to Main Heading  
 Oshanter Mine -

for  
**J.M. CHASE HEIRS.**  
 adjoining Lands of Geo Bowman -  
 Clearfield Pa. Scale 1"=100' E.W. Hess  
 Engr. Sept. 30 88 -  
 (Note: - Courses = Magnetic)

537

5393

537