


JOSHUA SMITH
137 A²

JOHN WHITMER
367 A²

JOSHUA HAINES
329 A²

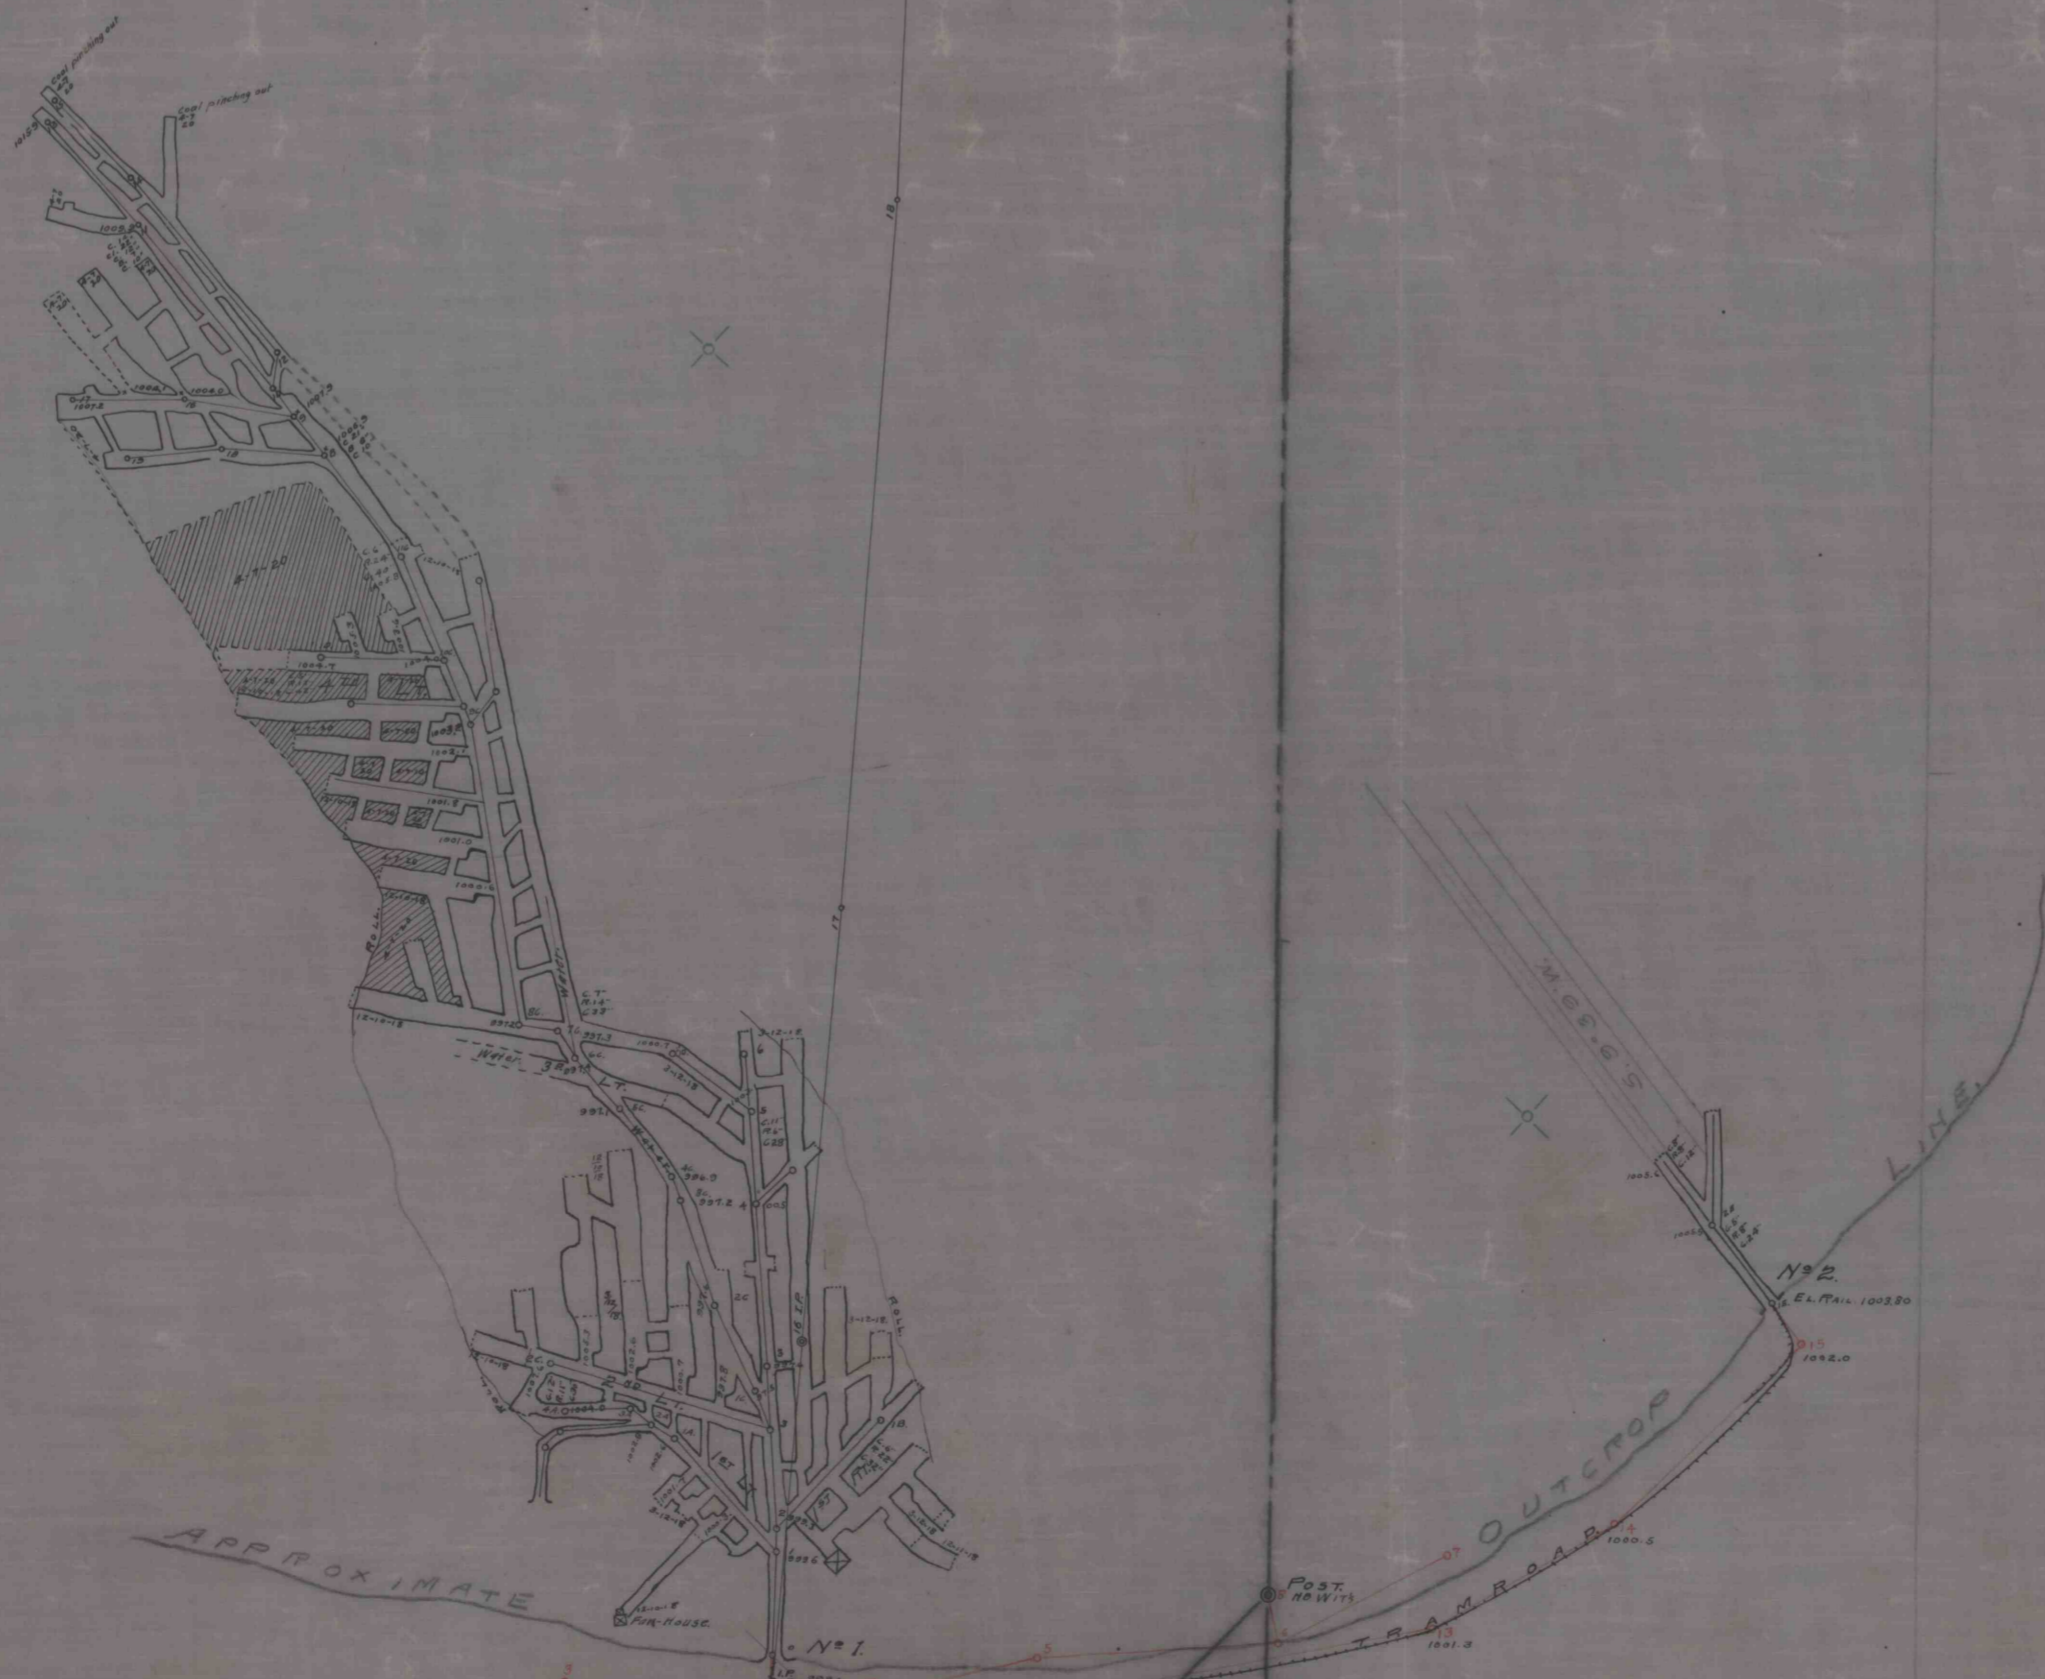

GLENBROOK COLLIERIES CO.,
MAP OF MINES
NEAR IRVONA, CLEARFIELD CO., PA.

SCALE 1100'

CLEARFIELD PA
DEC-28-1918

OFFICE OF EWHESS
ENGINEER

SURVEYED MAR-13-1918
RE-SURVEYED DEC-10-1918
SURVEYED APR-11-1920

758

3228

