


3474

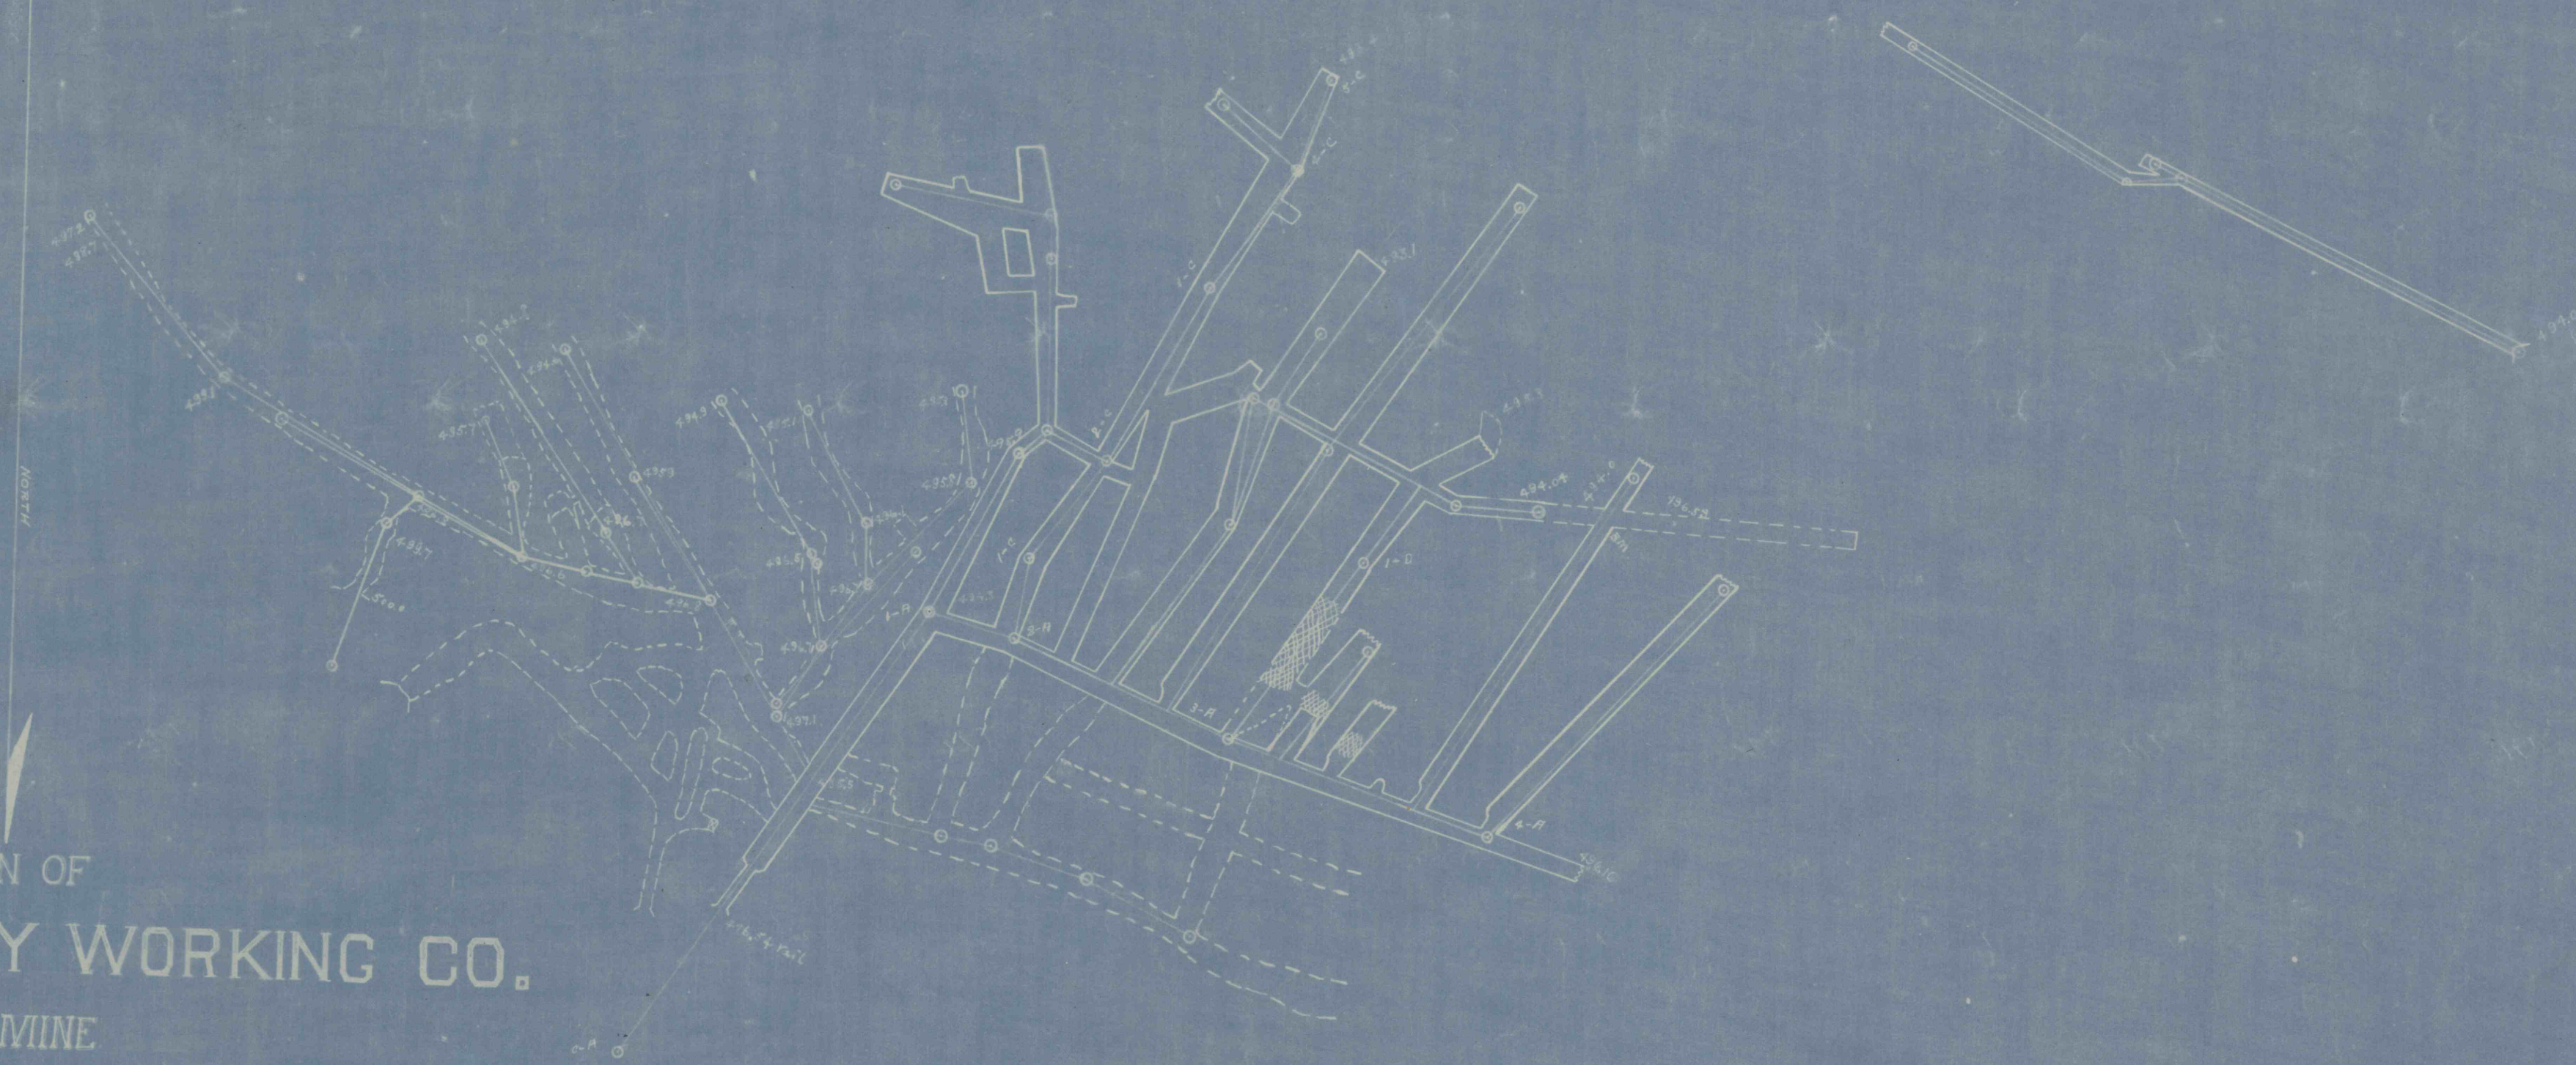

D

PLAN OF
CLEARFIELD CLAY WORKING CO.
CLAY MINE

CLEARFIELD, PA. SURVEYED MAR. 1902.

SCALE - 1" = 100 FT.

G. B. Alexander, Engr.

794