


PASSMORE ESTATE

MILES MEASE ESTATE

JOHN M. CHASE

MILES MEASE ESTATE

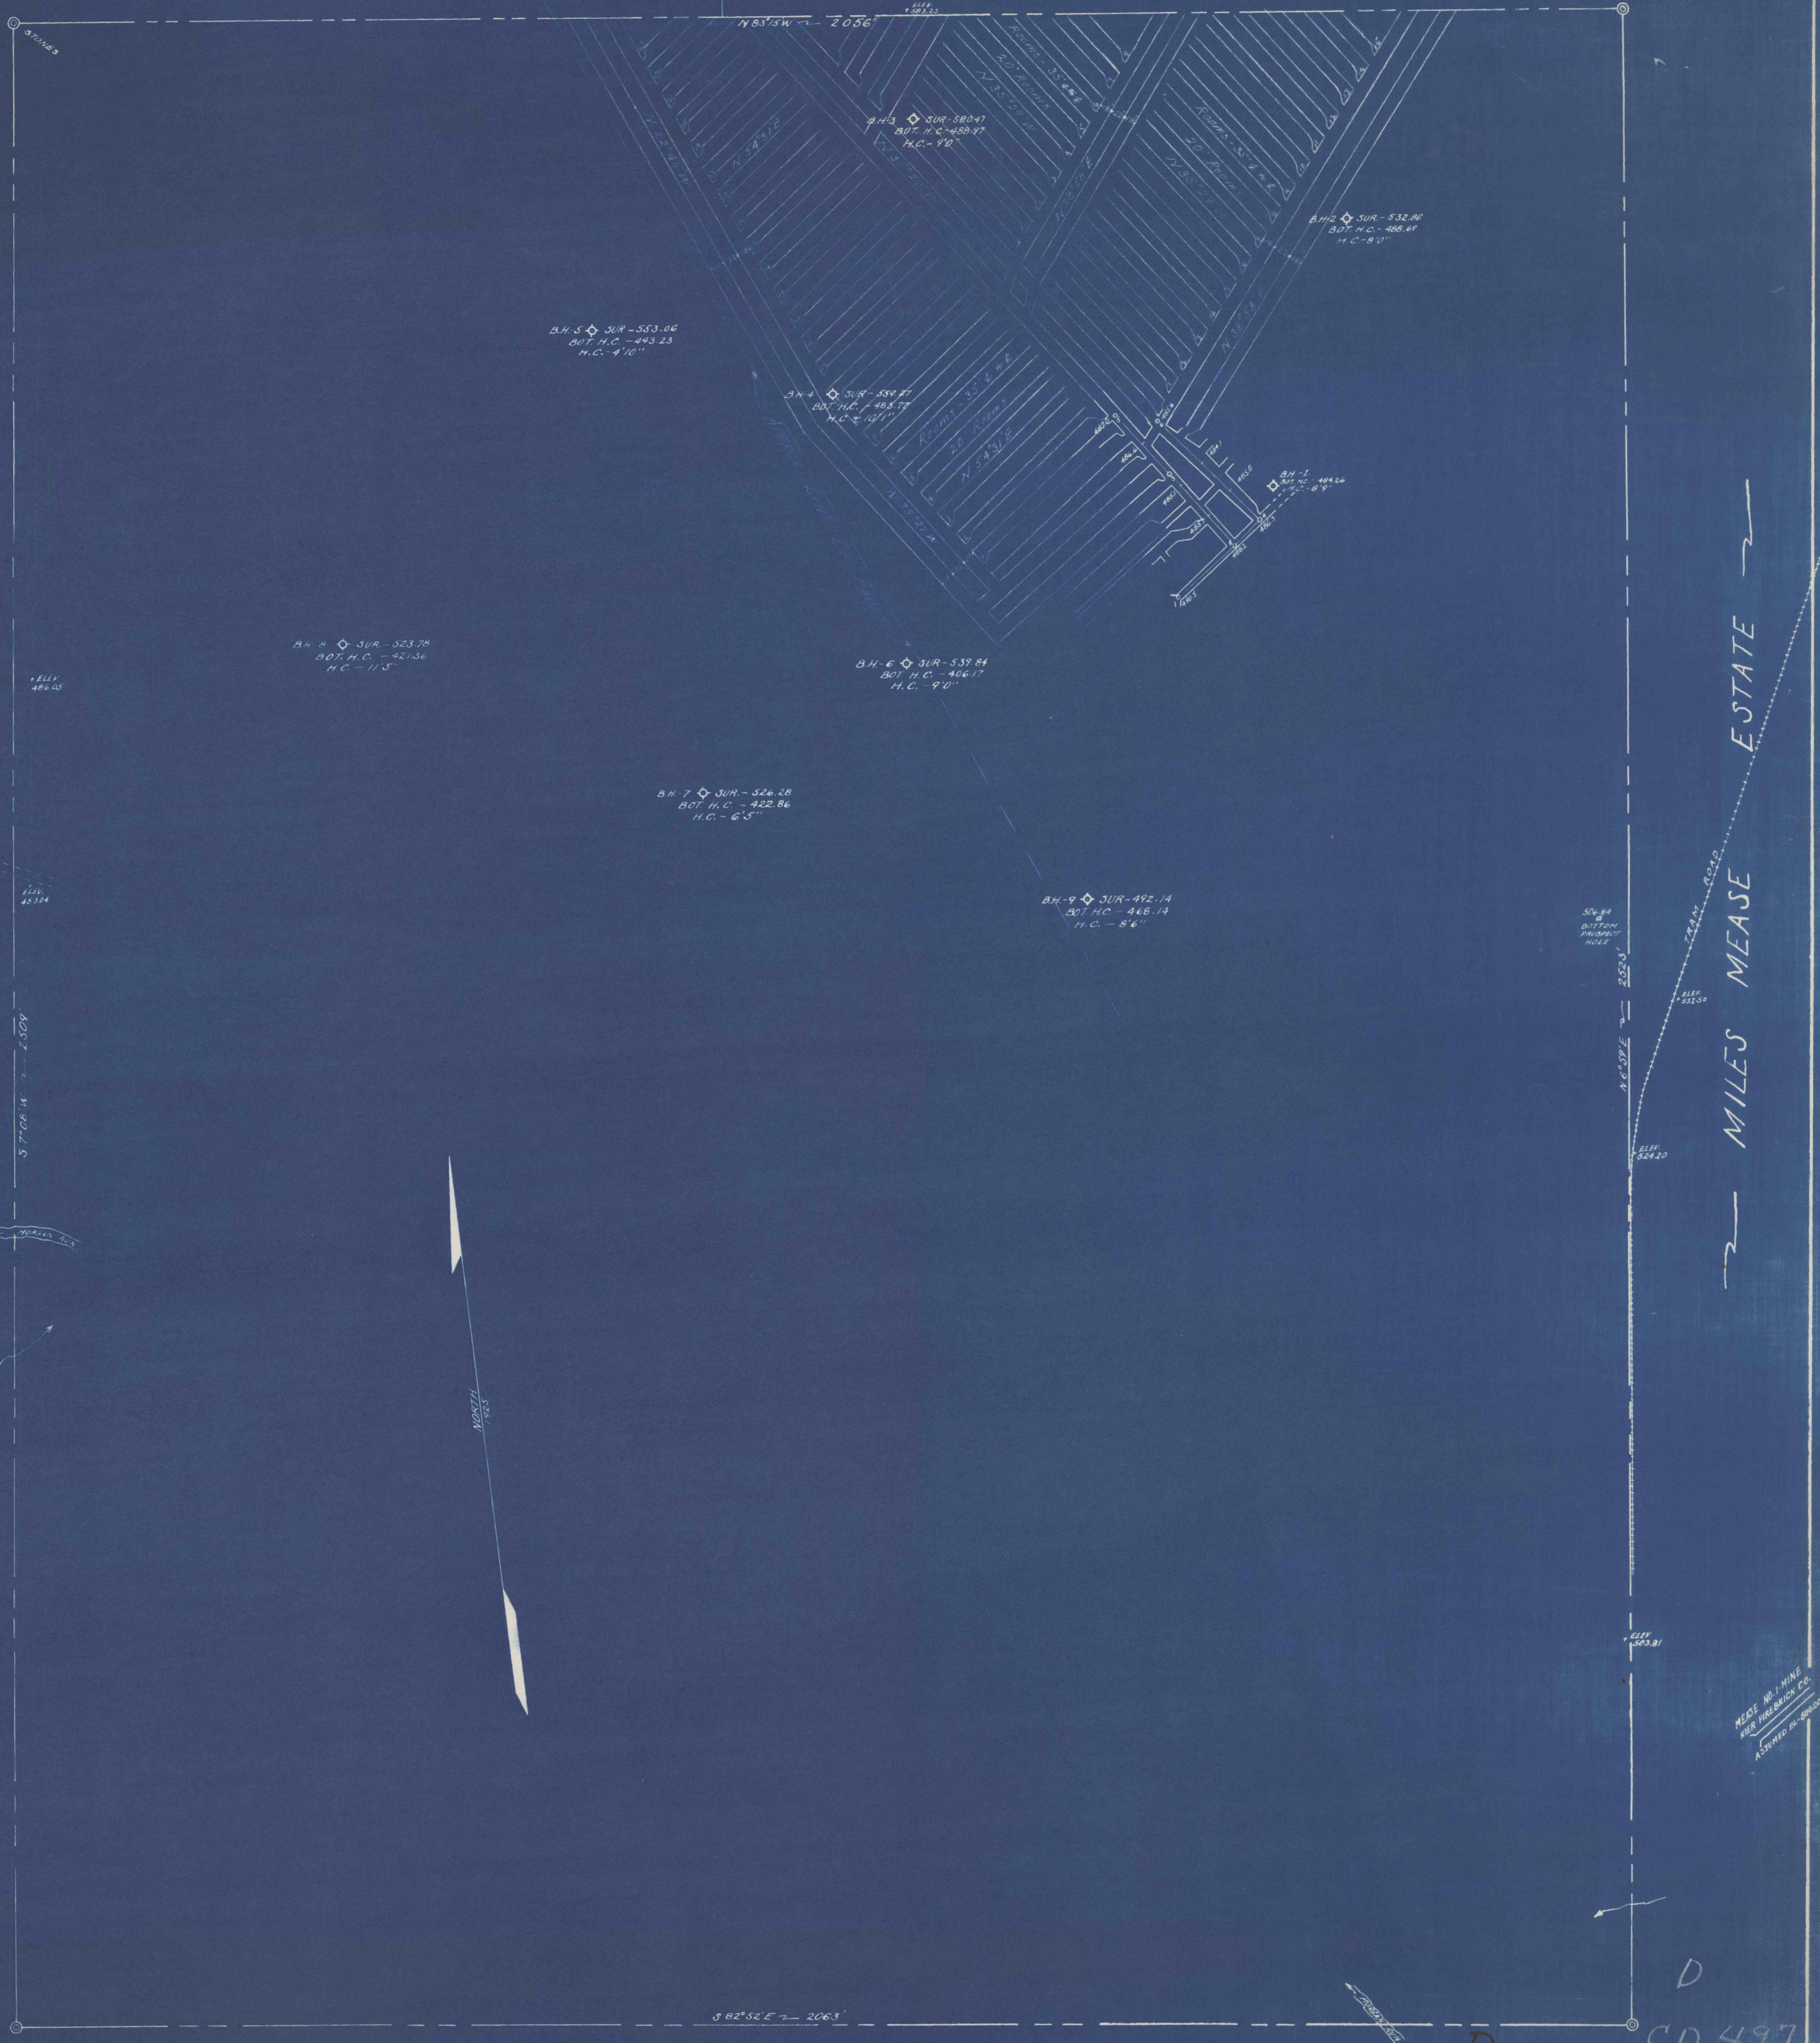

HAGERTY LANDS

MAP OF **C.D. 497**
PARDEE CLAY MINE
 OPERATED BY
OSCEOLA SILICA & FIRE-BRICK CO.
 OSCEOLA MILLS PENNSYLVANIA.
 SCALE 1" = 100' - OCTOBER 30, 1941 - J. H. W. [unclear] ENG.

3476

MINE NO. 1 - MINE
 RIER FIRE-CLAY CO.
 ASSIGNED NO. 59600