


C.B. CORFITT

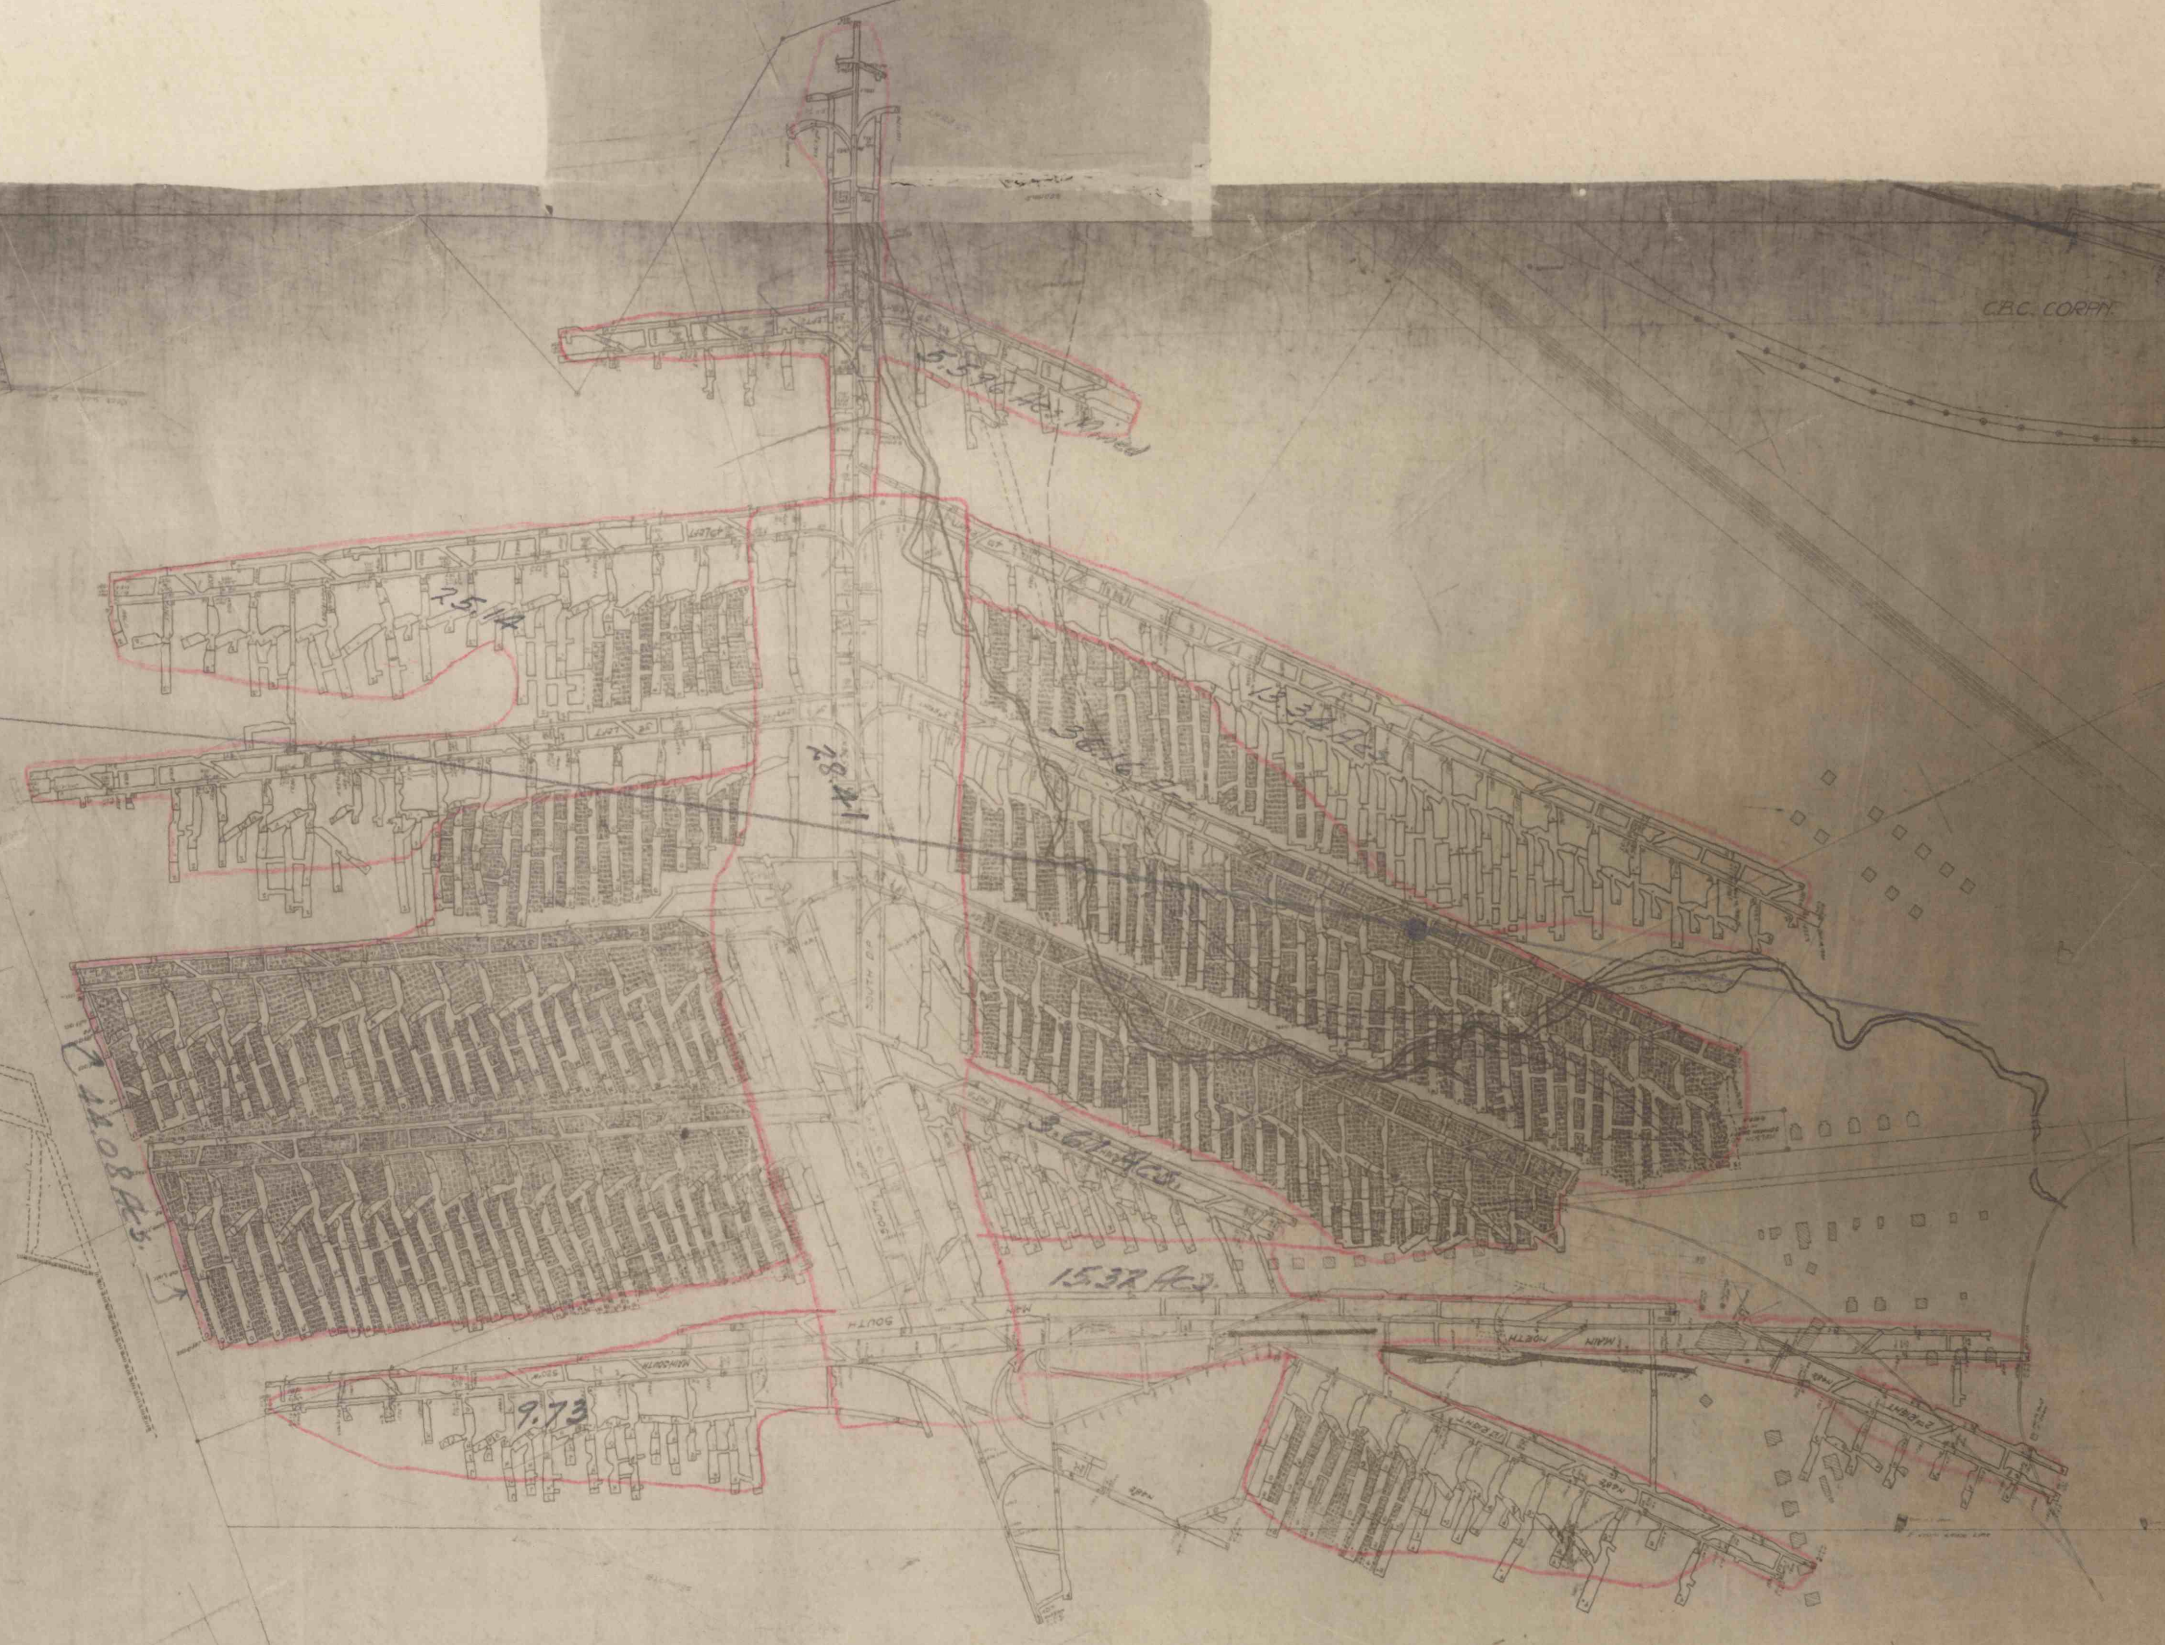

MAP OF THE  
**SONMAN SHAFT**  
 WORKINGS ON C PRIME SEAM  
 OPERATED BY THE  
 SONMAN SHAFT COAL CO.  
 ON LANDS OF THE  
 CAMBRIA MINING  
 AND MANUFACTURING CO.  
 AT SONMAN CAMBRIA CO. PA.

SCALE 1 IN = 100 FT  
 ALTOONA PA.

NO.	DESCRIPTION	DATE
1		
2		
