


3569

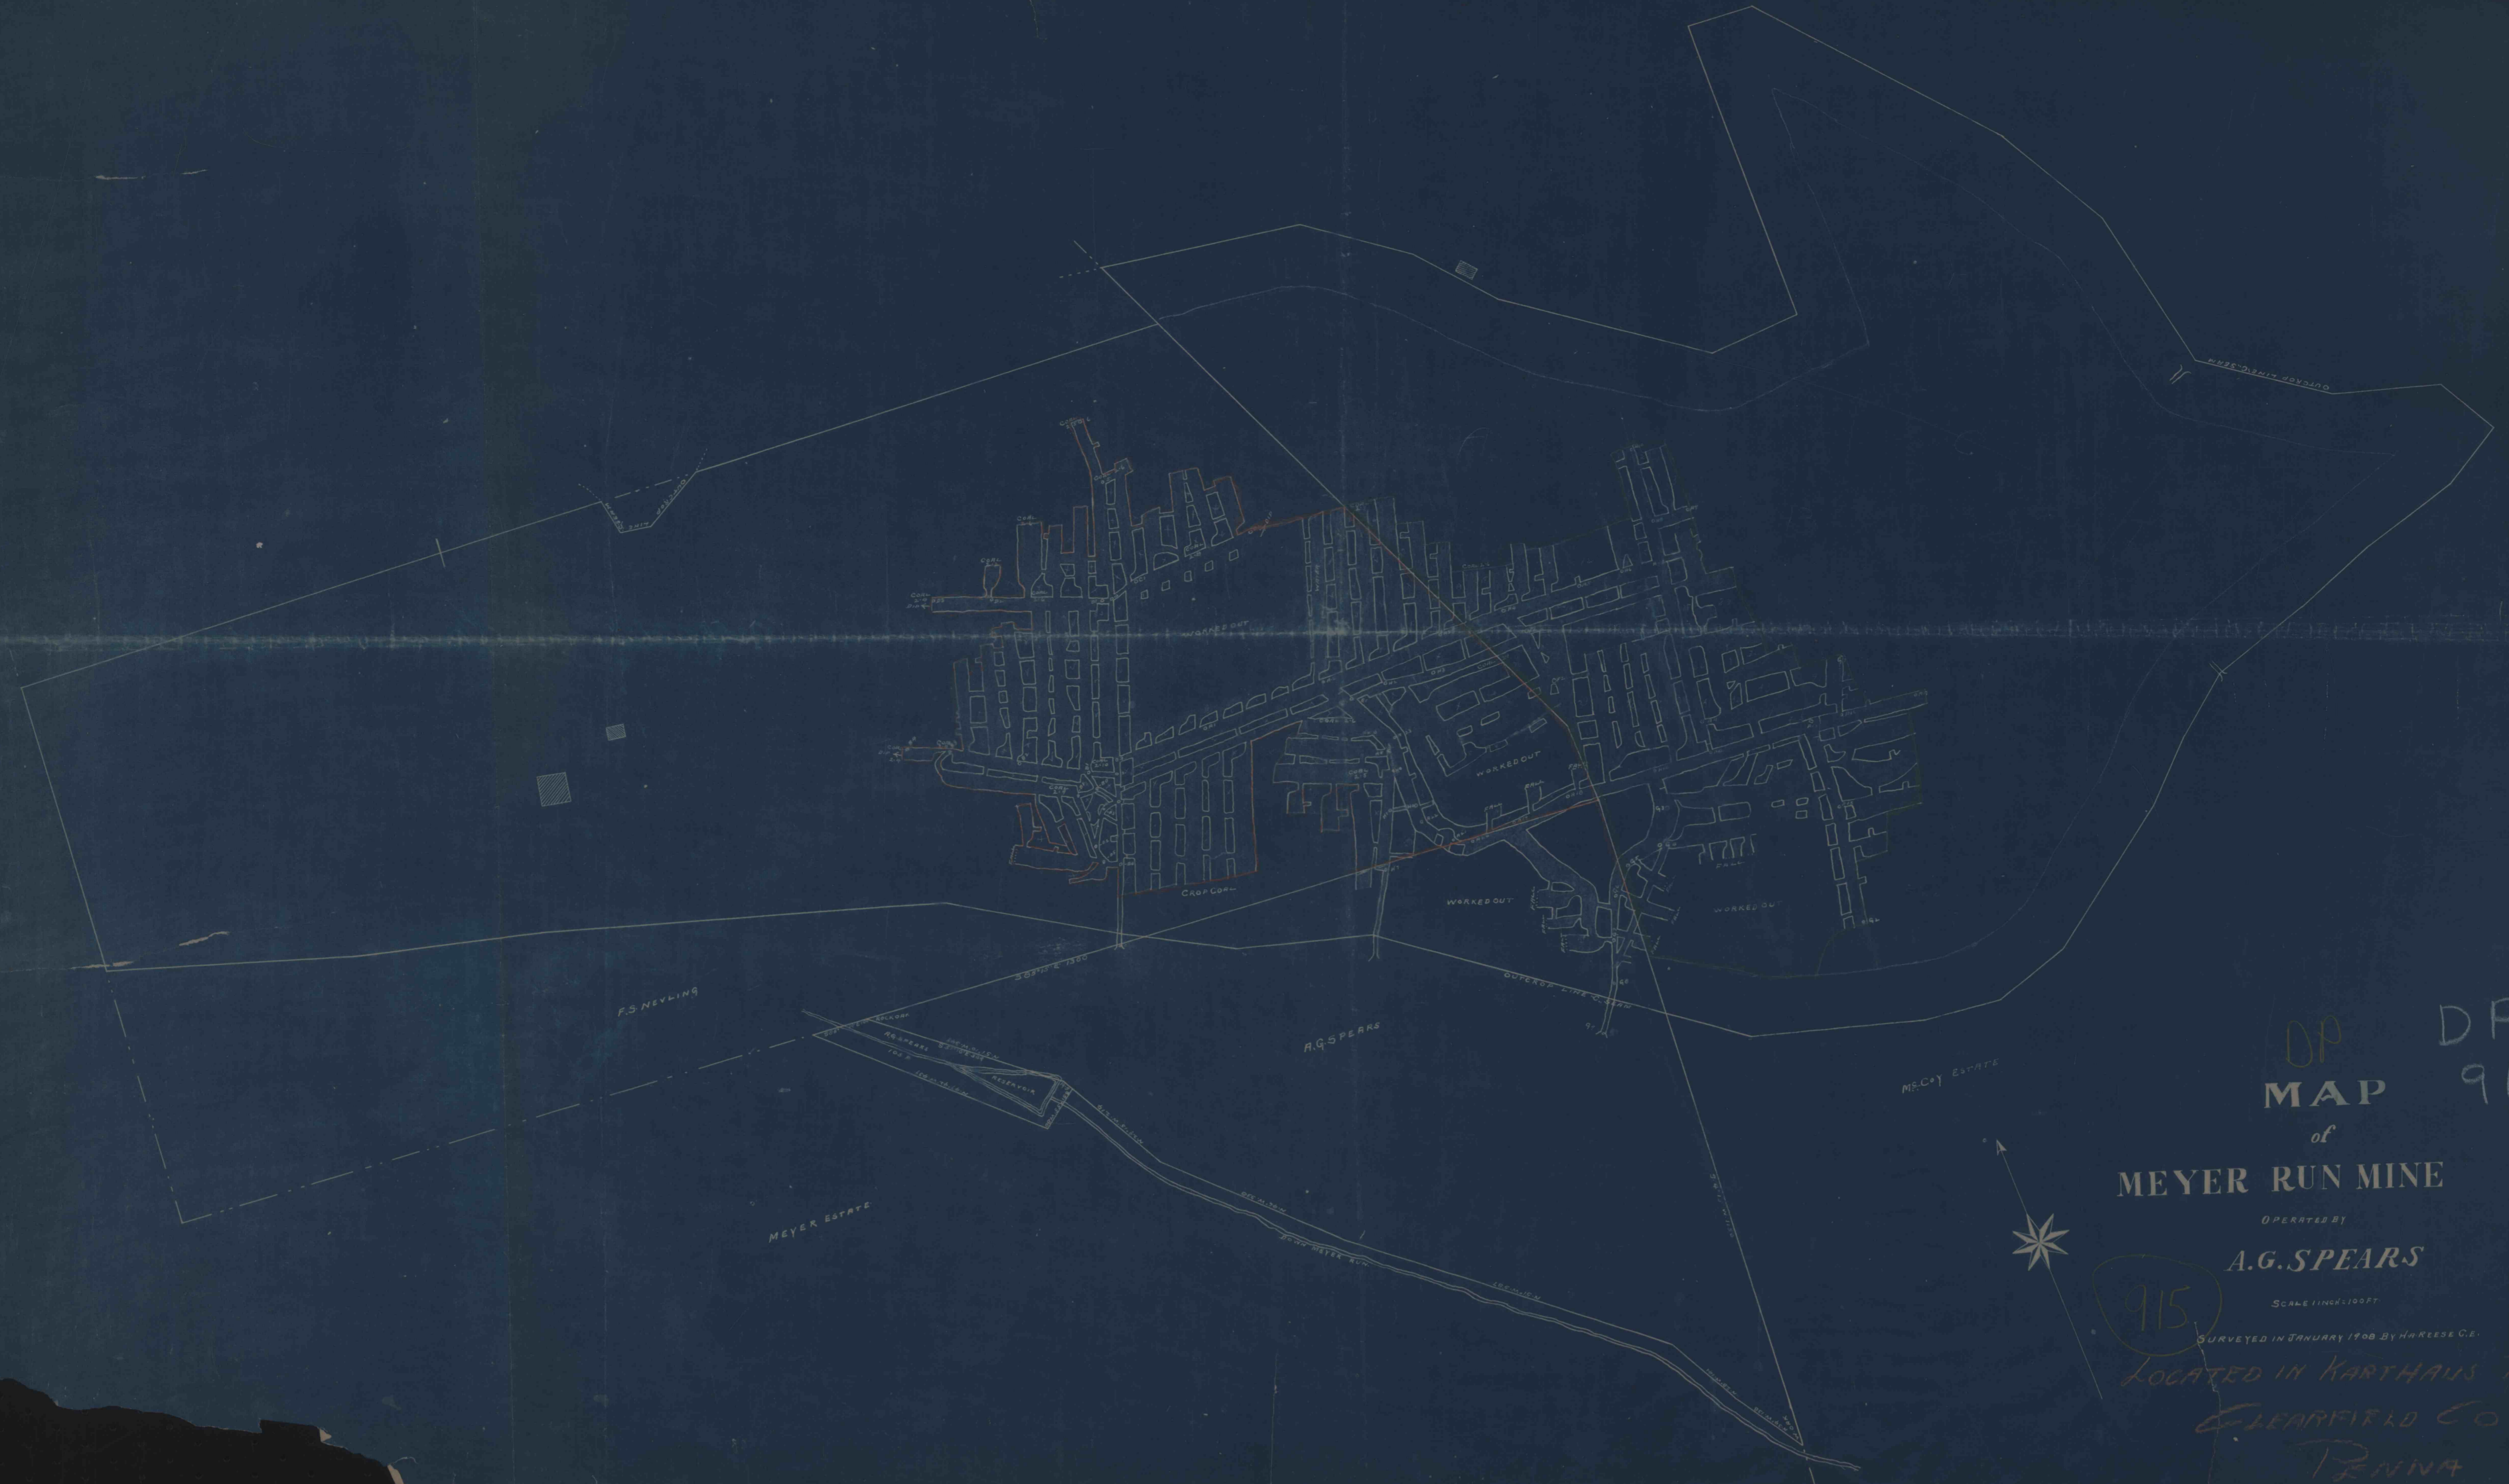

OP DP  
 MAP 915

**MEYER RUN MINE**

OPERATED BY

**A.G. SPEARS**

SCALE 1 INCH = 100 FT

SURVEYED IN JANUARY 1908 BY H. REESE C.E.

915  
 LOCATED IN KARTHANS TWP  
 CLEARFIELD CO  
 PENNA  
