


362

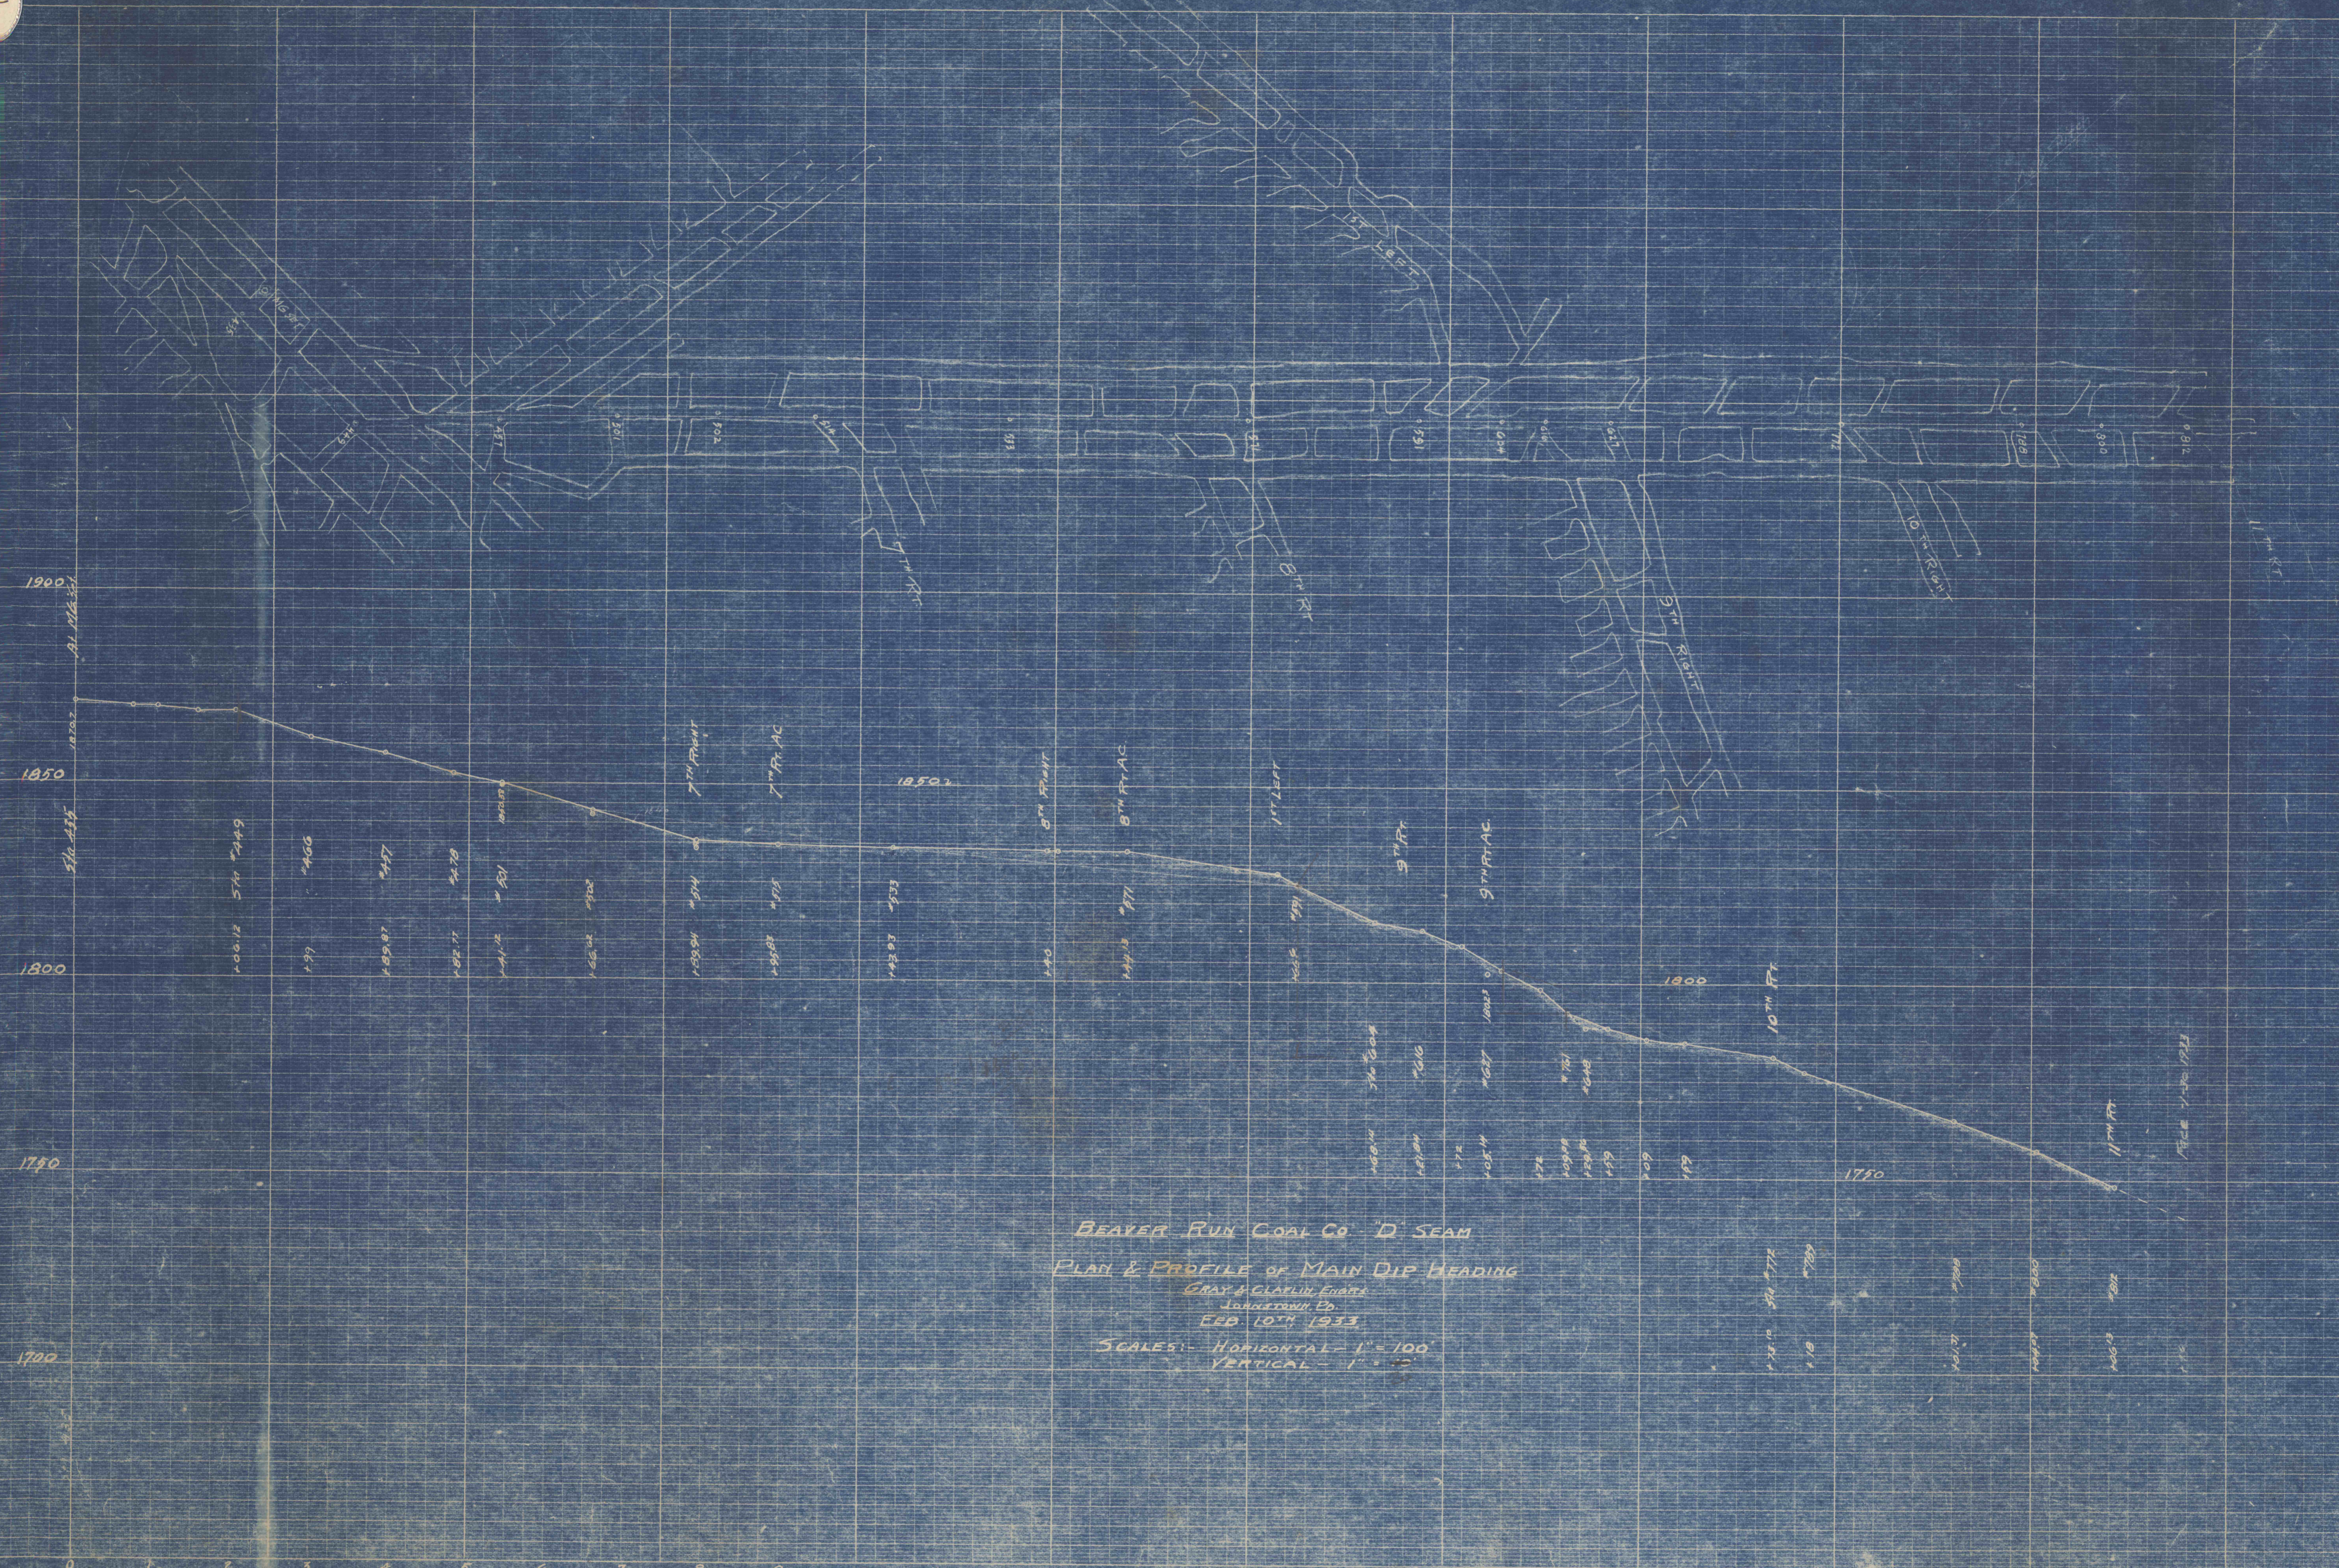

BEAVER RUN COAL CO. D SEAM
 PLAN & PROFILE OF MAIN DIP HEADING
 FEB. 10th 1933.
 SCALES: HORIZONTAL - 1" = 100'
 VERTICAL - 1" = 20'