



This print revised by prints of 9/13/35

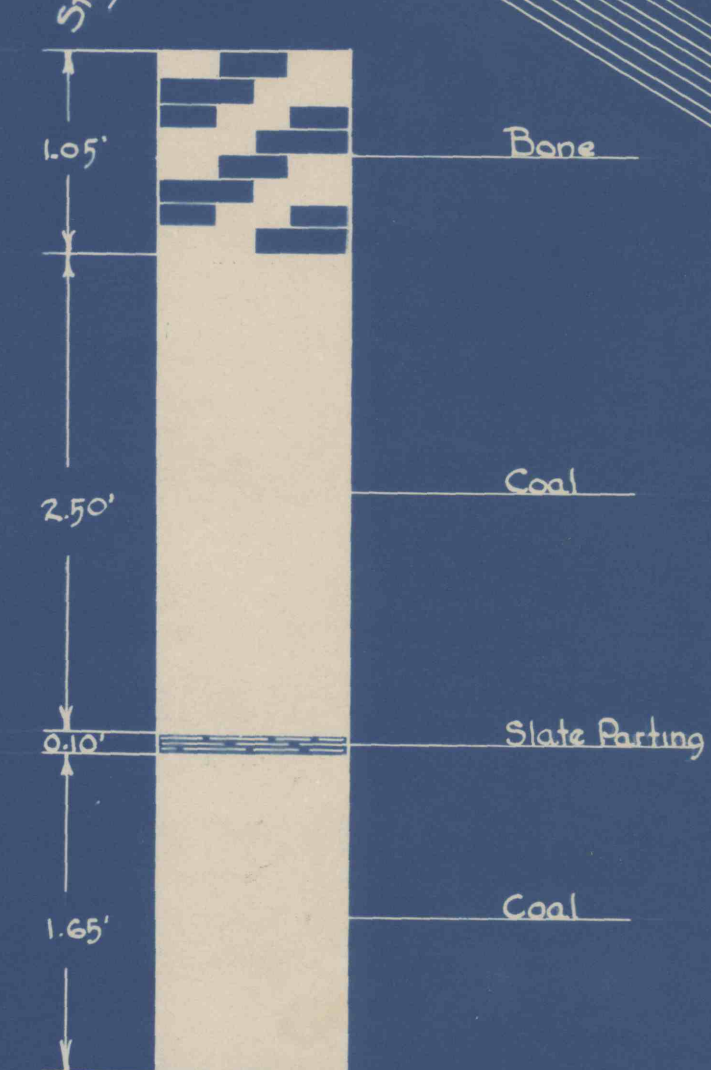

Average Section of "E" Seam Coal.
Scale - 1" = 1'

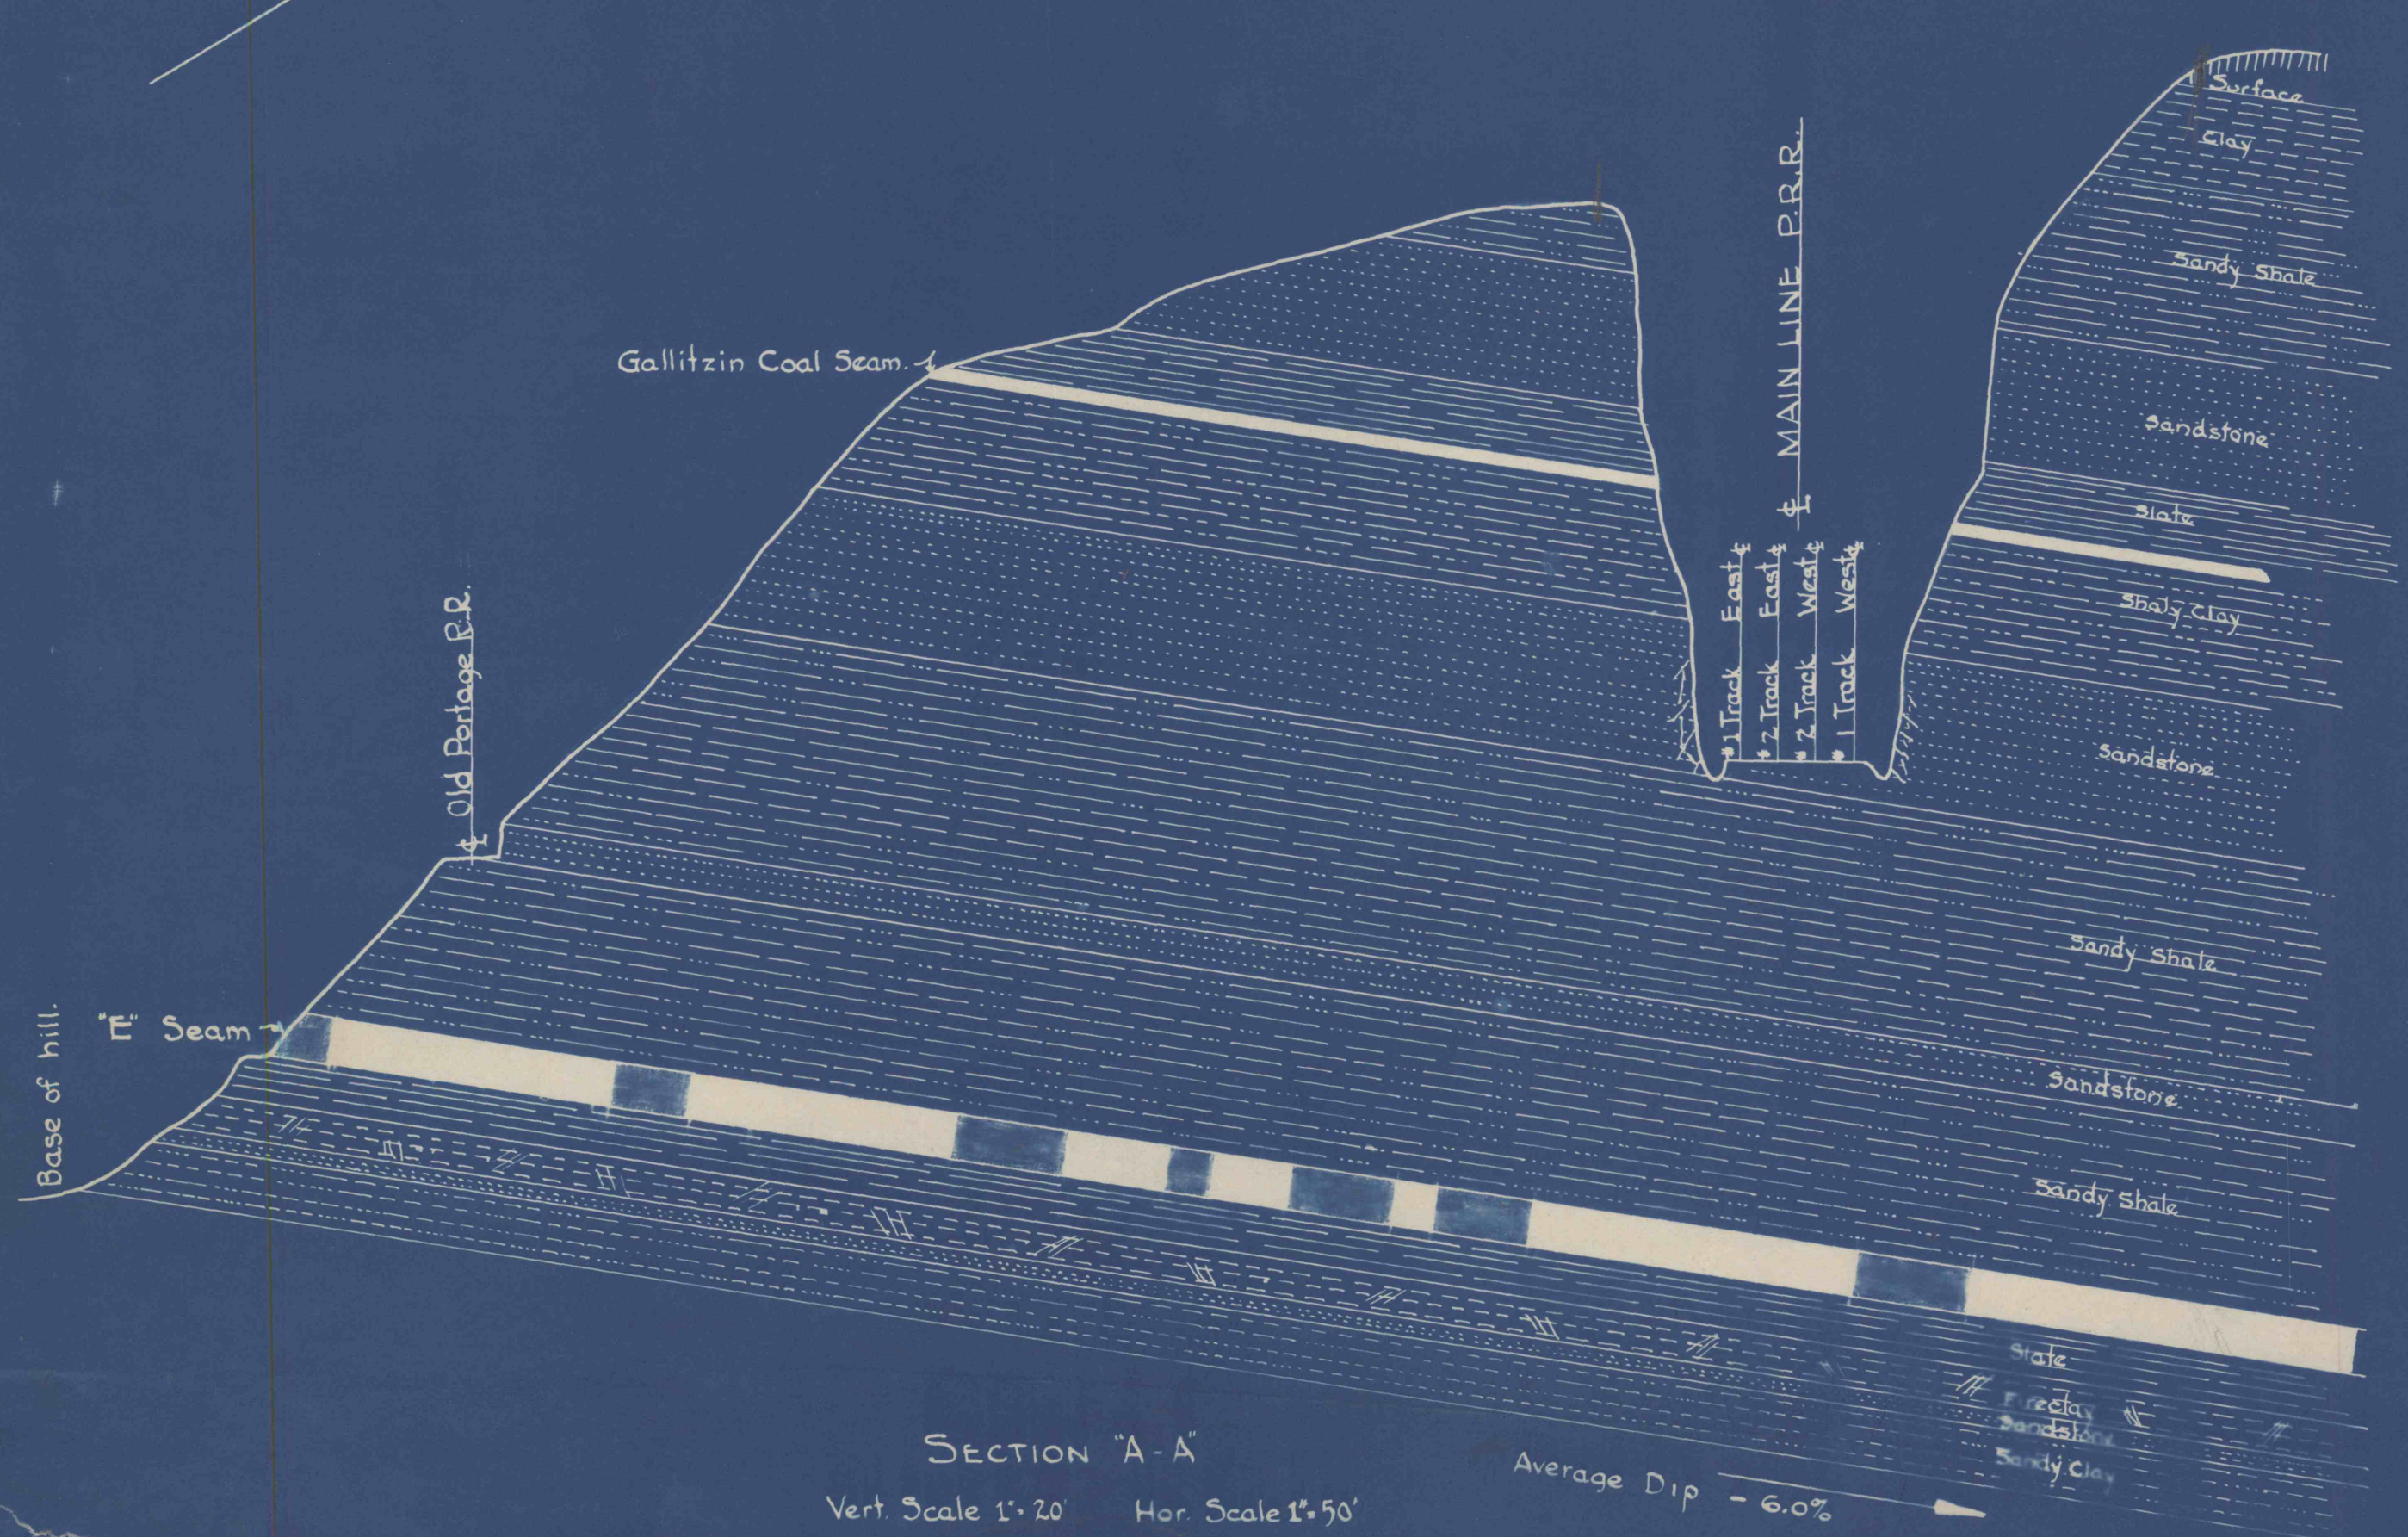

SECTION "A-A"
Vert. Scale 1" = 20' Hor. Scale 1" = 50'
Average Dip - 6.0%

PENNSYLVANIA RAILROAD-MAIN LINE
MINE WORKINGS
AURANDT & LEAP COAL CO.
WITH RELATION TO
PENNSYLVANIA RAILROAD TRACKS
NEAR CASSANDRA, PA.

Scale 1" = 100' Andrew B. Crichton
Mining Engineer
Johnstown, Pa.

