


Elk Fire Brick Co.
J.D. Ramsey, Pres.
St. Marys Pa.
Survey of
FIRE CLAY MINES
at
DAGUSCAHONDA
Elk Co, Penna.
Scale 1" = 100'

DuBois Pa. Office of
Dec 14, 1917 E.W. Hess, Eng.

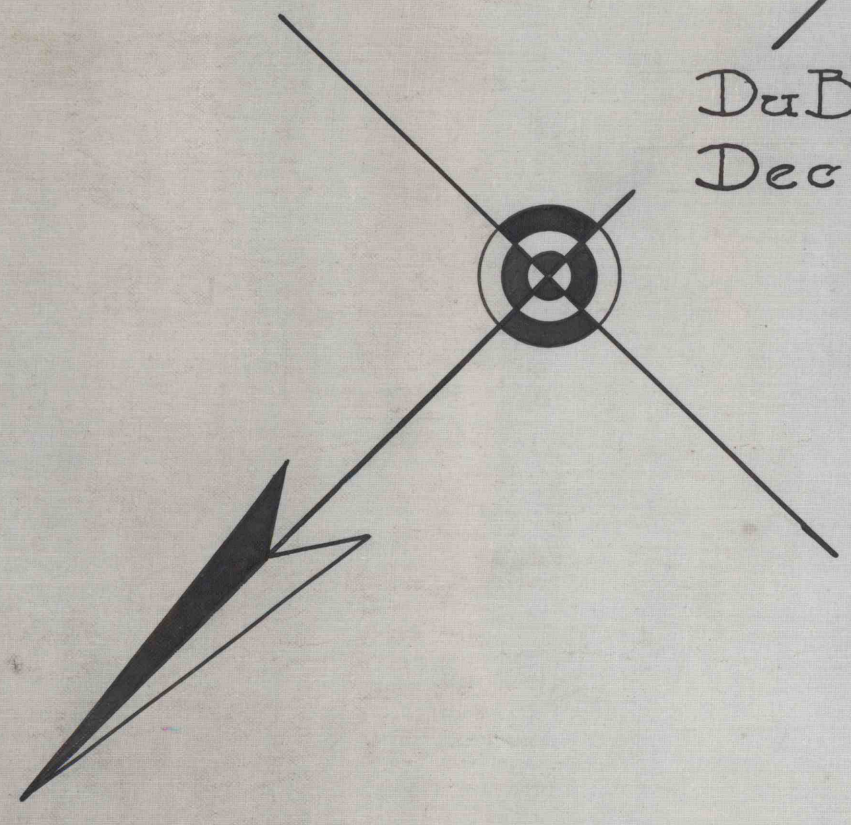

WARRANT 4404
Property line by C.J. Schaub & Shaffer
WARRANT 4395
Approximate Out-Crop of Upper Vein

ELK FIRE BRICK COMPANY
CLAY AND SHALE

DARK CLAY MINE

LIGHT CLAY MINE

