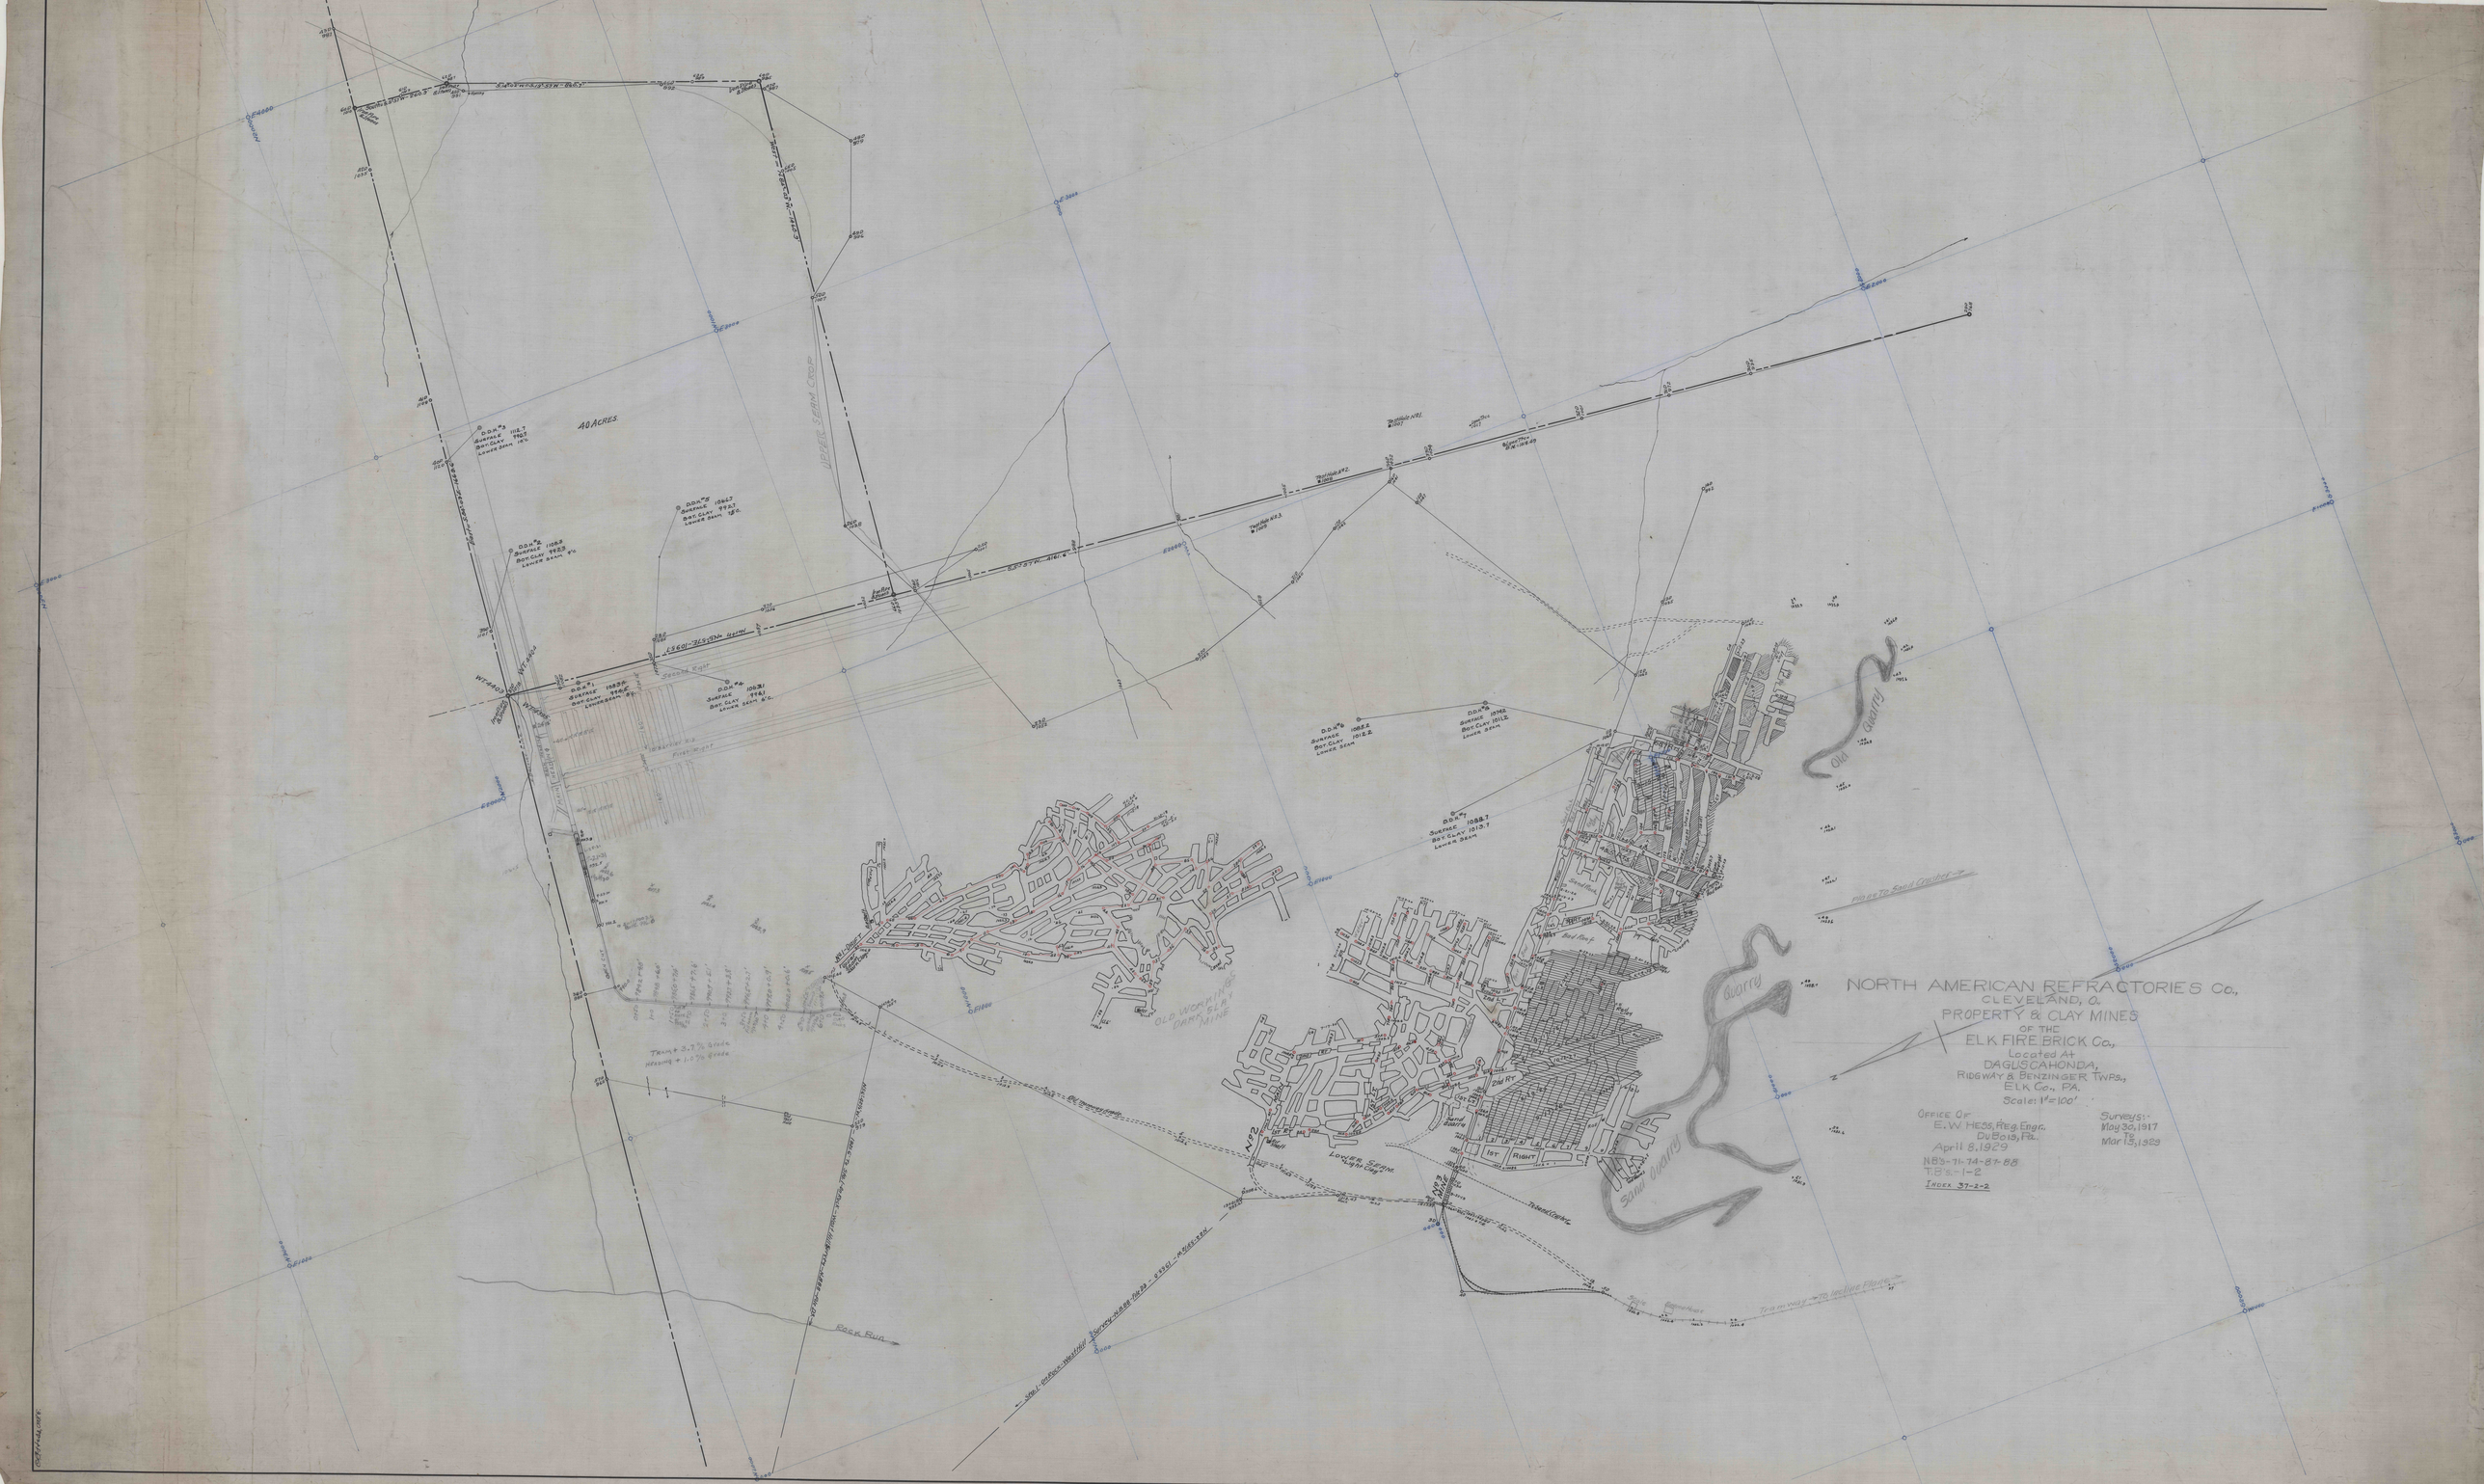
NORTH AMERICAN REFRACTORIES Co.,
CLEVELAND, O.
PROPERTY & CLAY MINES
OF THE
ELK FIRE BRICK Co.,
Located At
DAGUSCAHONDA,
RIDGWAY & BENZINGER TWPS.,
ELK Co., PA.
Scale: 1" = 100'
OFFICE OF
E. W. HESS, Reg. Engr.
DuBois, Pa.
April 8, 1929
NB3-71-74-87-88
T.B's-1-2
INDEX 37-2-2
Surveys:-
May 30, 1917
To
Mar 15, 1928
40 ACRES
UPPER SEAM CROP
OLD WORKINGS
DARK FLAT
MINE
Old Quarry
Old Quarry
Old Quarry
Slate Quarry
Tramway To Incline Plane
Pipe To Sand Crusher
Tramway 3.7% Grade
Hoisting 1.0% Grade
Lower Spring
Water Cap
Tipple
Bed Rock
Old Pit
Sand Quarry
1st
Right
Second Right
First Right
Back Run
Elk Run