


CAL AMON

3700

WEAVER and BETTS

WEAVER and BETTS

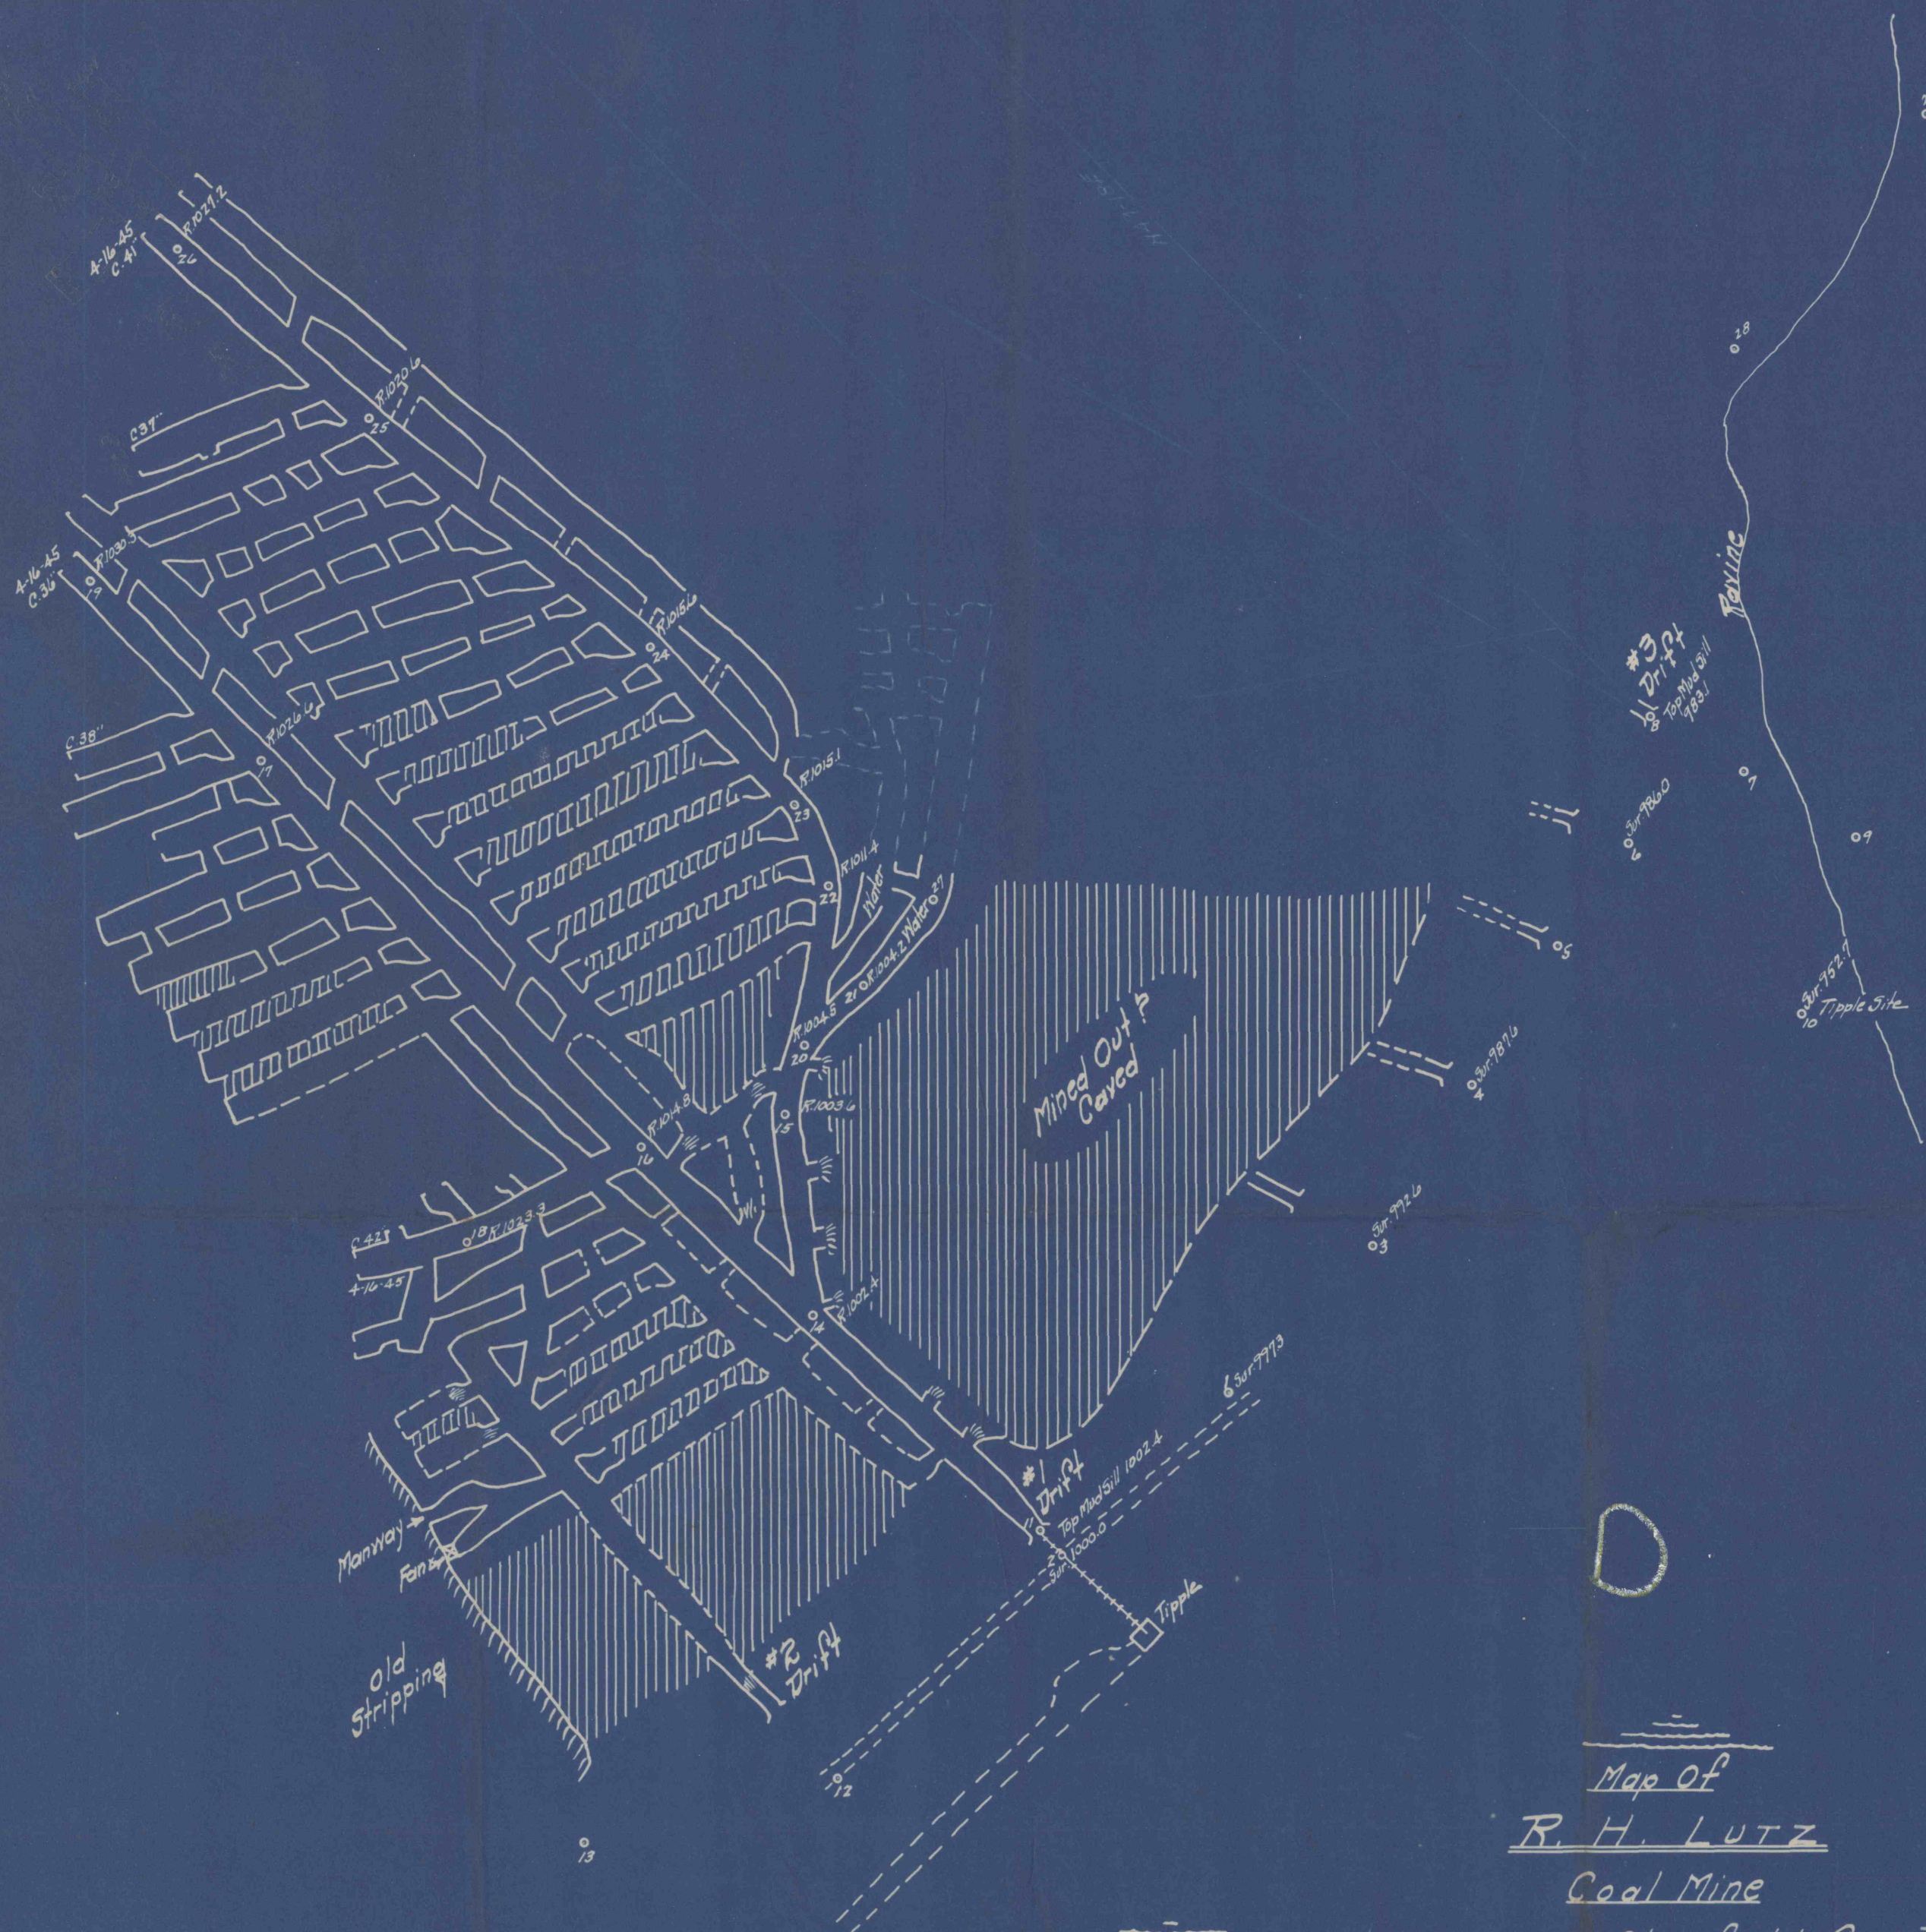

A. B. SHAW Est.

Map of  
R. H. LUTZ  
Coal Mine

Goshen Twp., Clearfield Co., Penna.

SCALE 1 in = 100 ft

April 24, 1945

By A. H. Lutz Reg. Engr. 5513

Note:-  
Datum Assumed

1188A

1188A  
File 1188A