
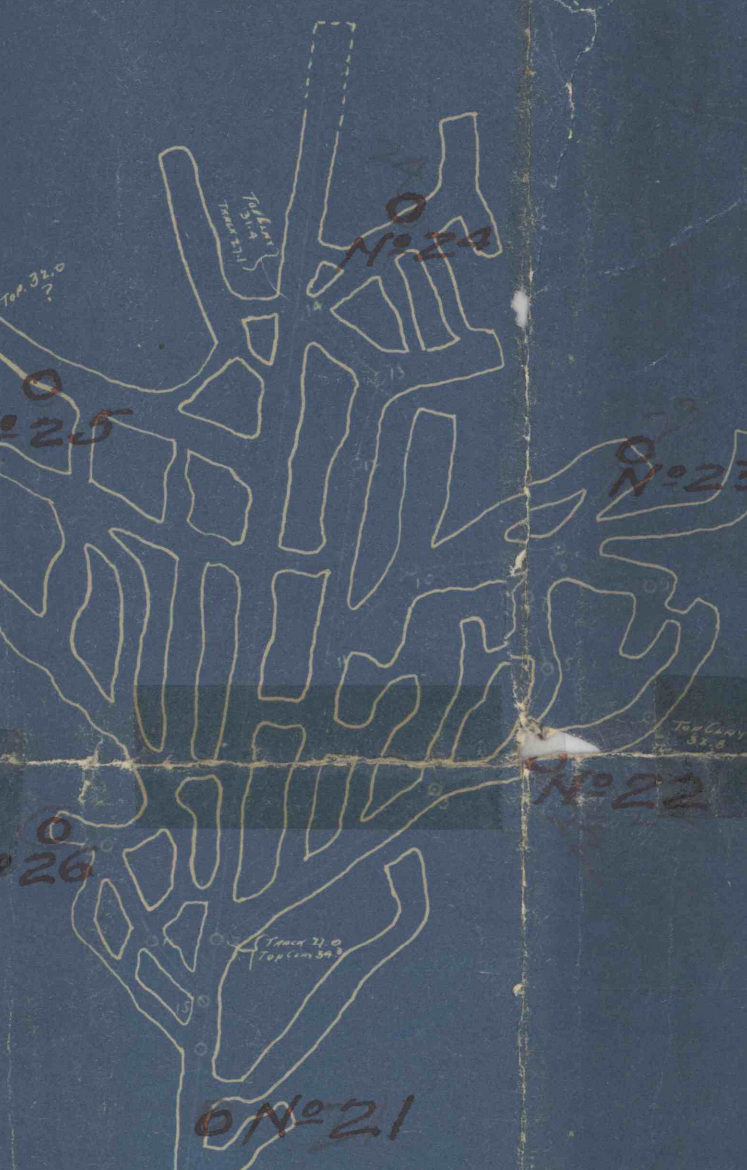


3719

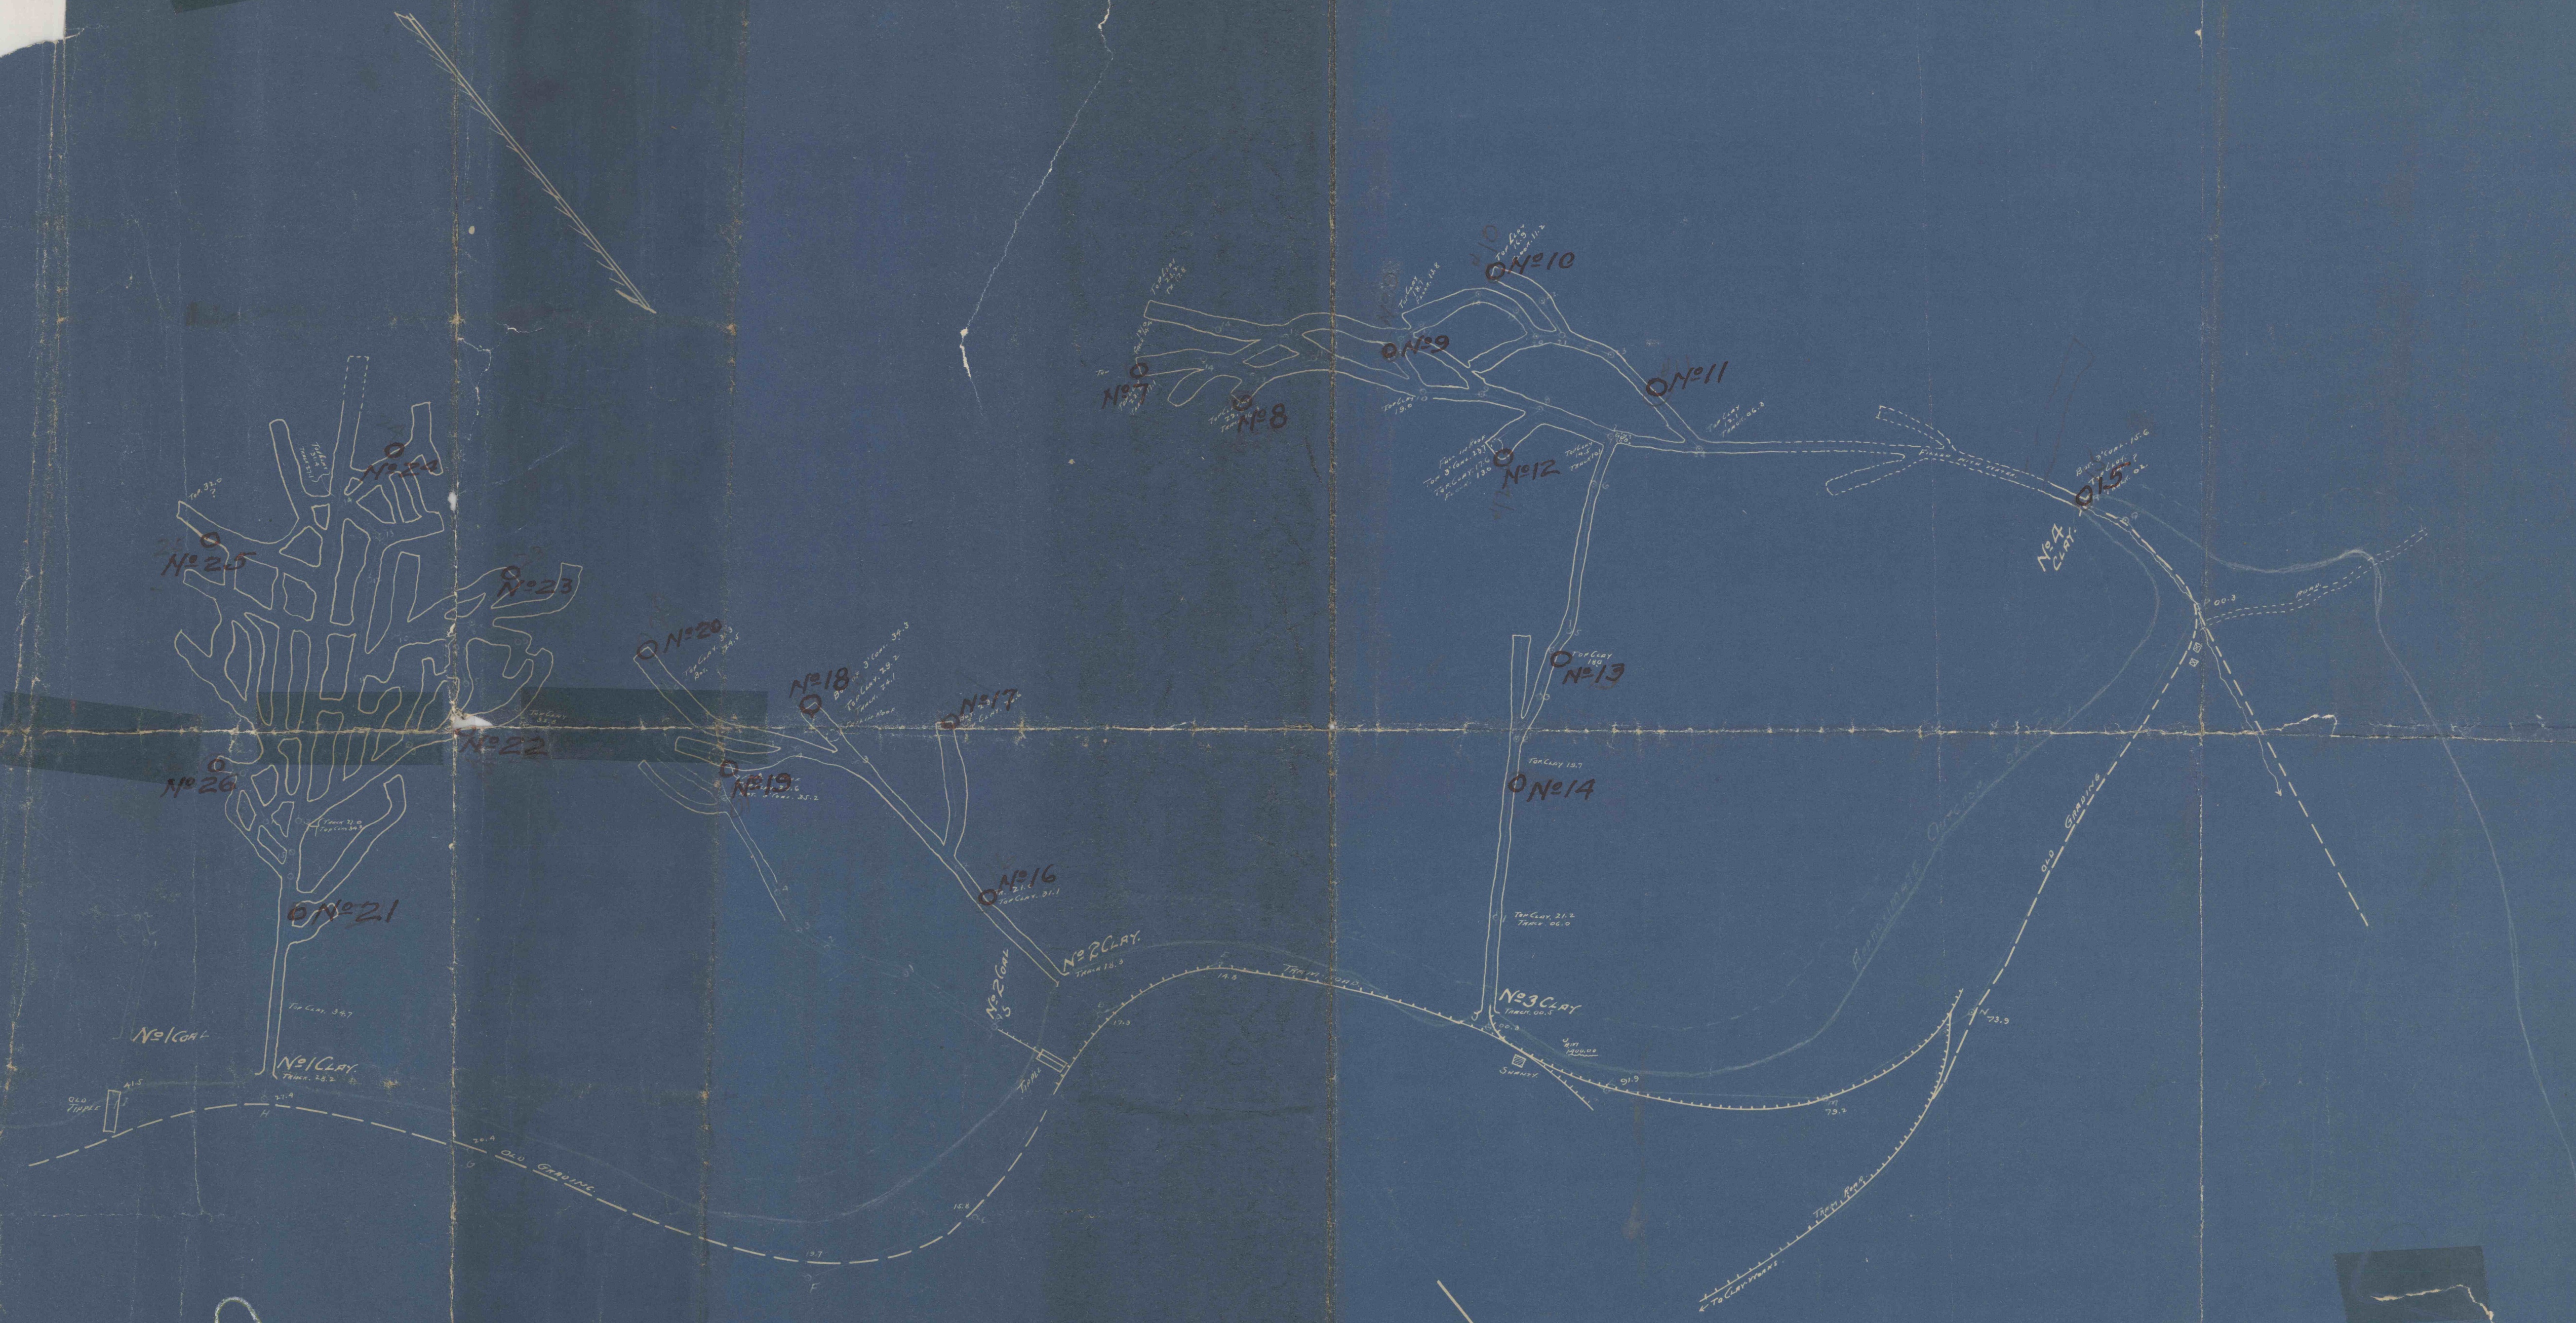

D
 SCALE 1=100' 833

NOTE: ELEVATION OF B.M. AT No. 3 CLAY (1400.00) IS BY BAROMETER FROM BARO (67200). OPENED LEAVE. FROM AROUND LEVELING FROM THIS B.M.