


PENNA

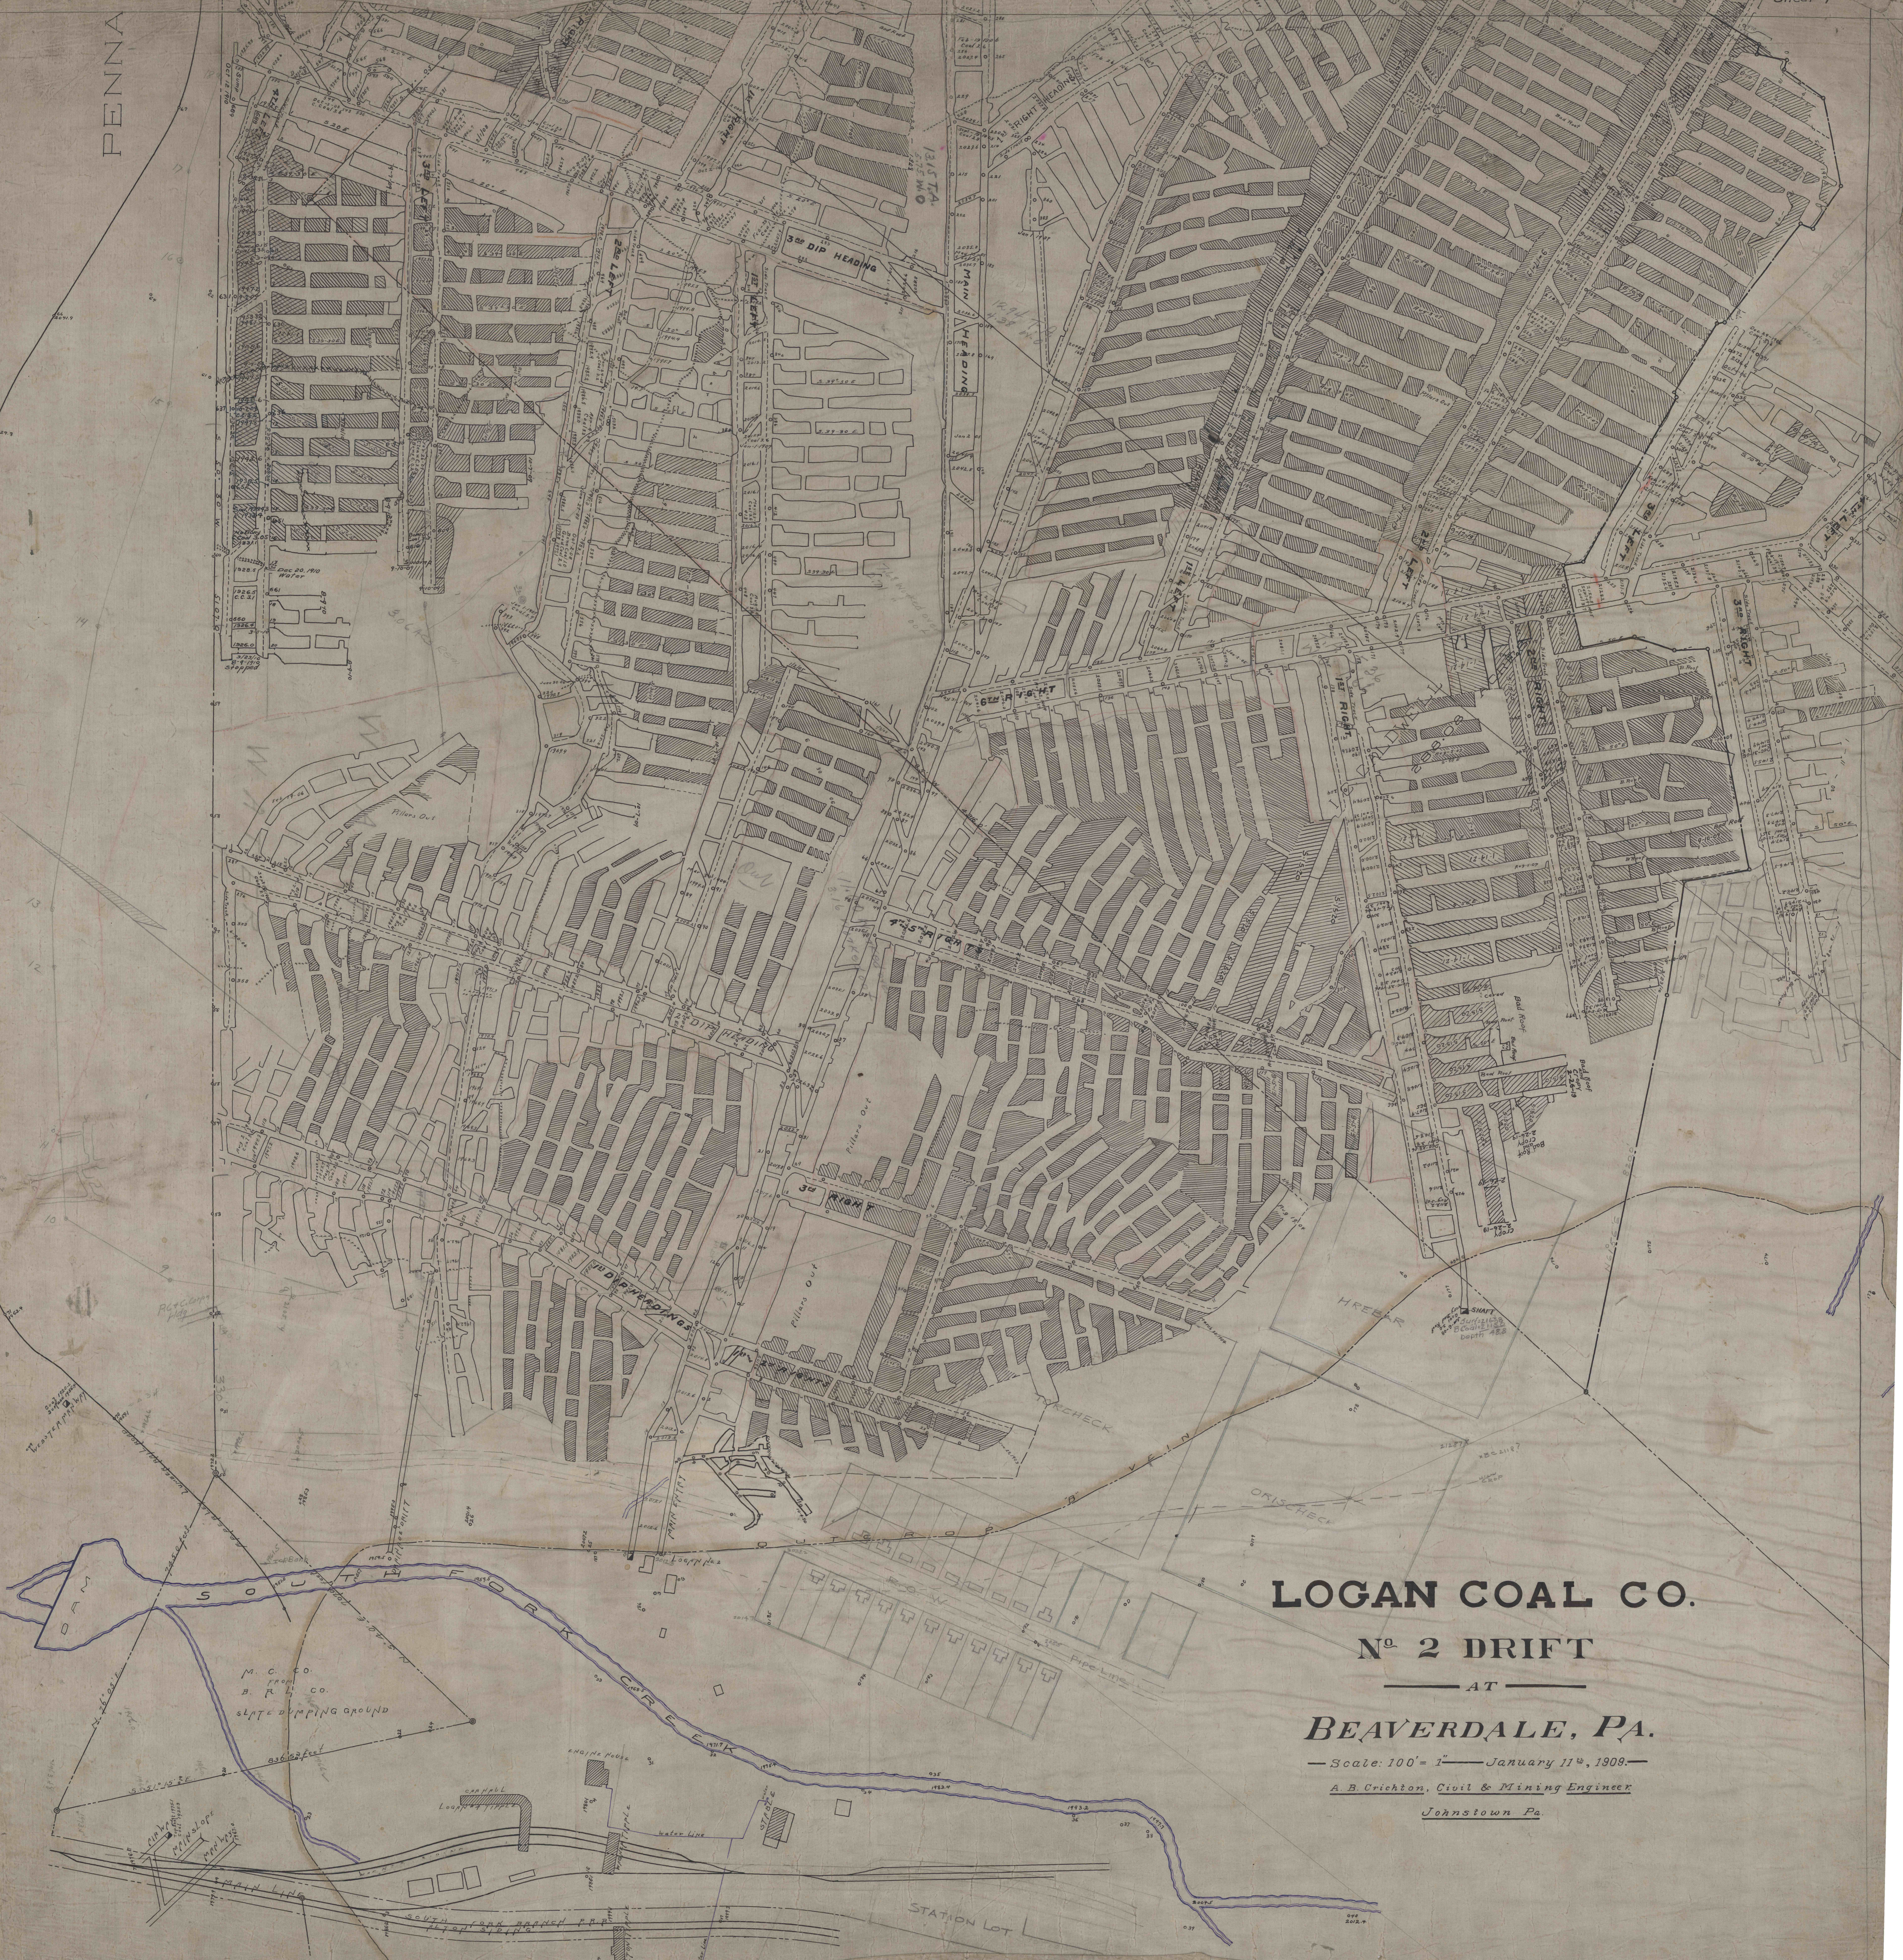

LOGAN COAL CO.

NO 2 DRIFT

— AT —

BEAVERDALE, PA.

— Scale: 100' = 1" — January 11th, 1909. —

A. B. Crichton, Civil & Mining Engineer

Johnstown Pa.