3968

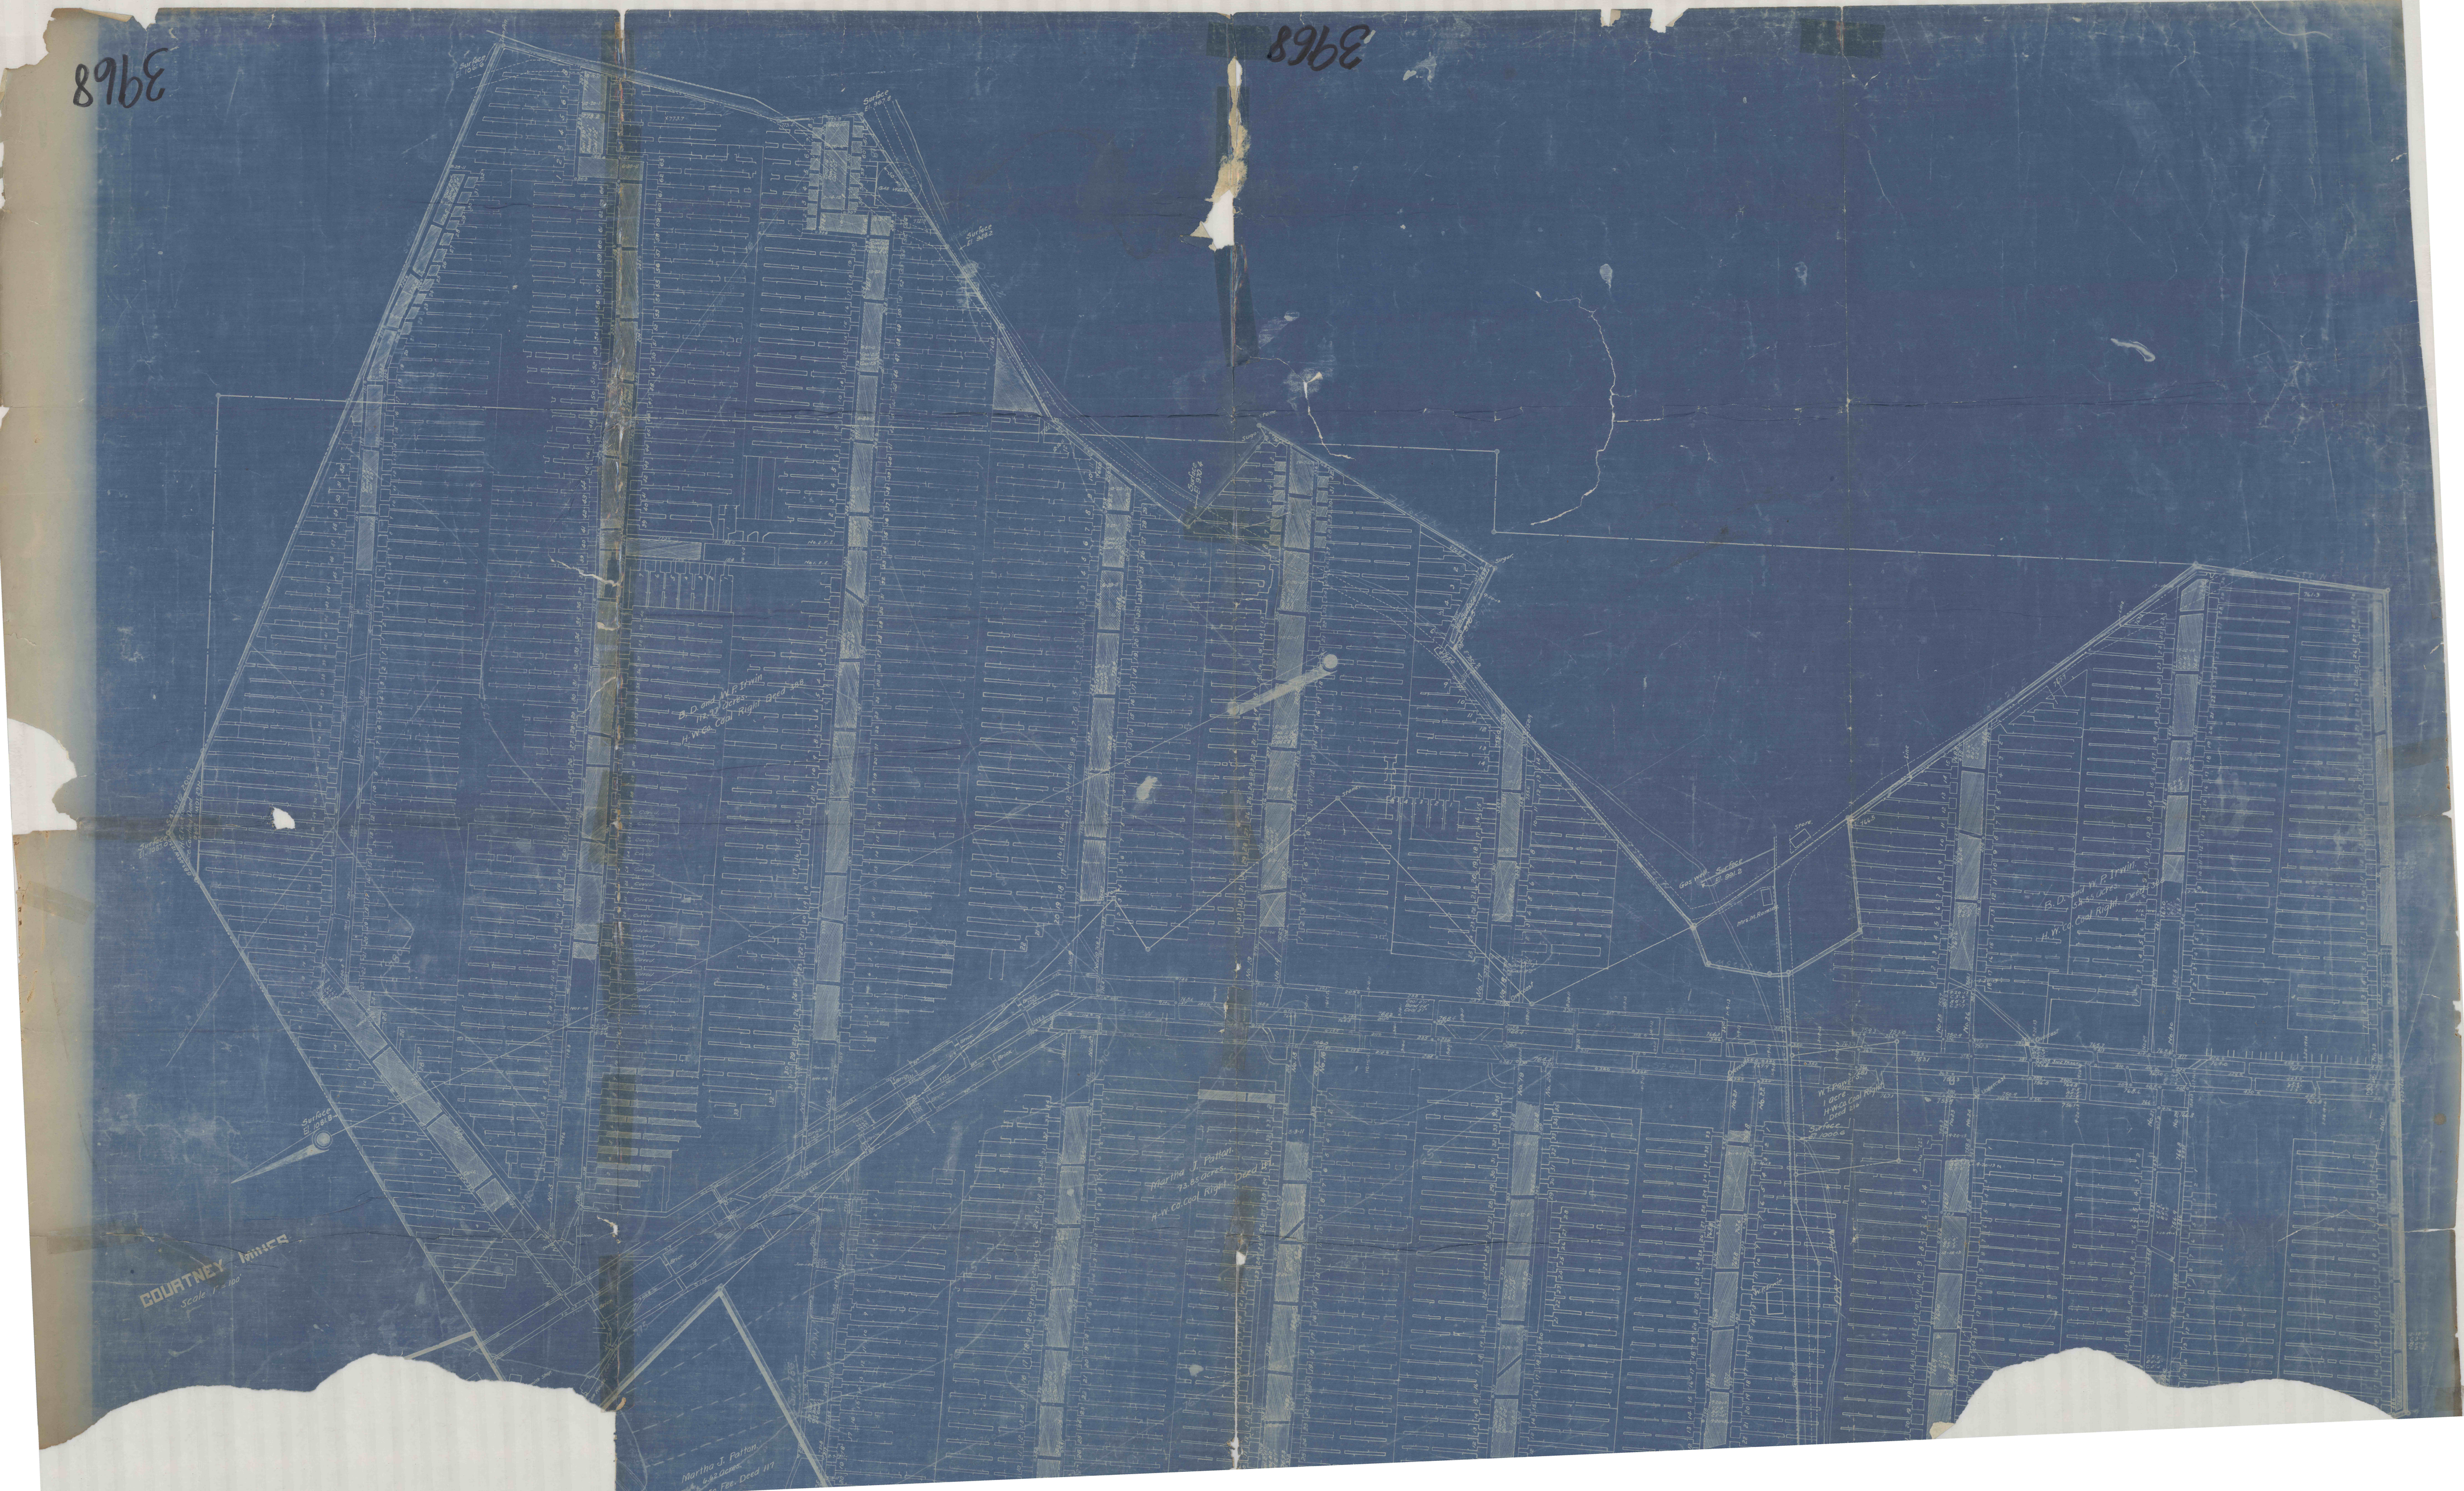
COURTNEY MINES
Scale 1" = 100'
Surface 1.0000 A
Surface 1.0000 A
Martha J. Patton
23.85 Acres
H.A. Co. Coal Right Deed 117
Martha J. Patton
6.92 Acres
H.A. Co. Coal Right Deed 117
B. D. and M. E. Irwin
11.25 Acres
H.W. Co. Coal Right Deed 128
W. T. Davis
1.00 Acre
H.W. Co. Coal Right Deed 128
Surface 1.0000 A
Gas Well Surface 1.0000 A
Pipe Line Right
B. D. and M. E. Irwin
H.W. Co. Coal Right Deed 128

3968