


1865  
3987

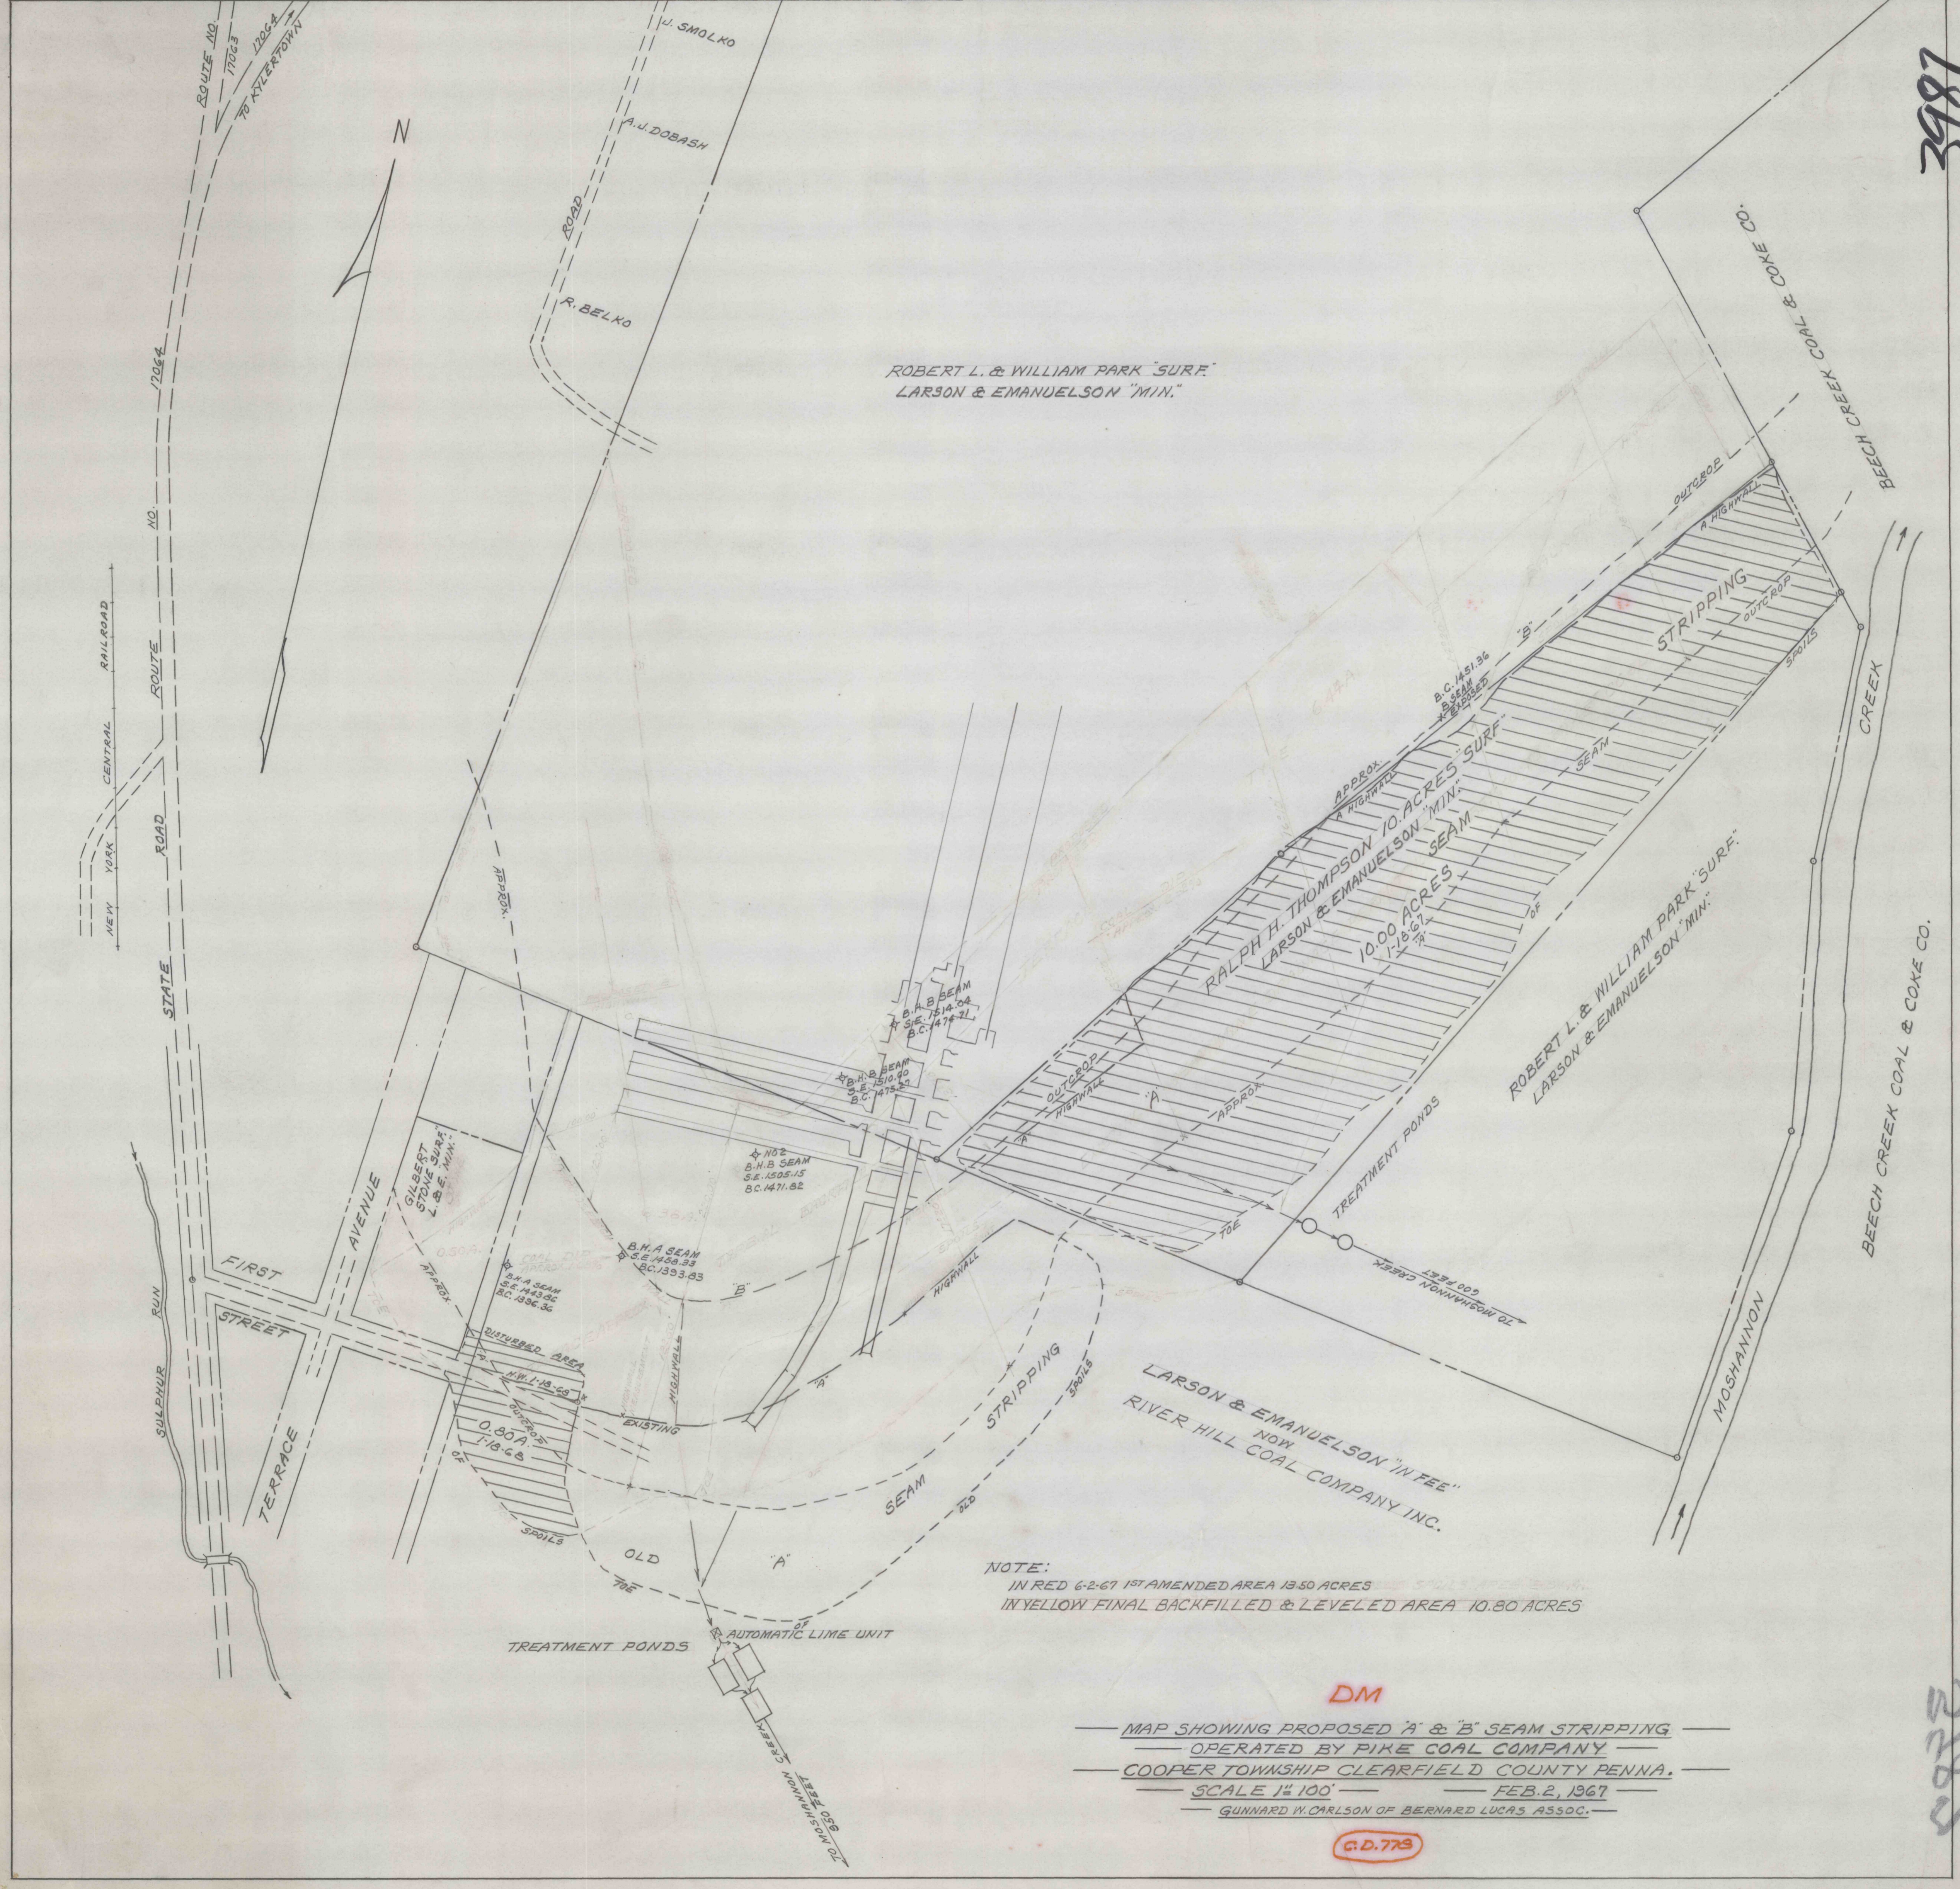

NOTE:  
 IN RED 6-2-67 1ST AMENDED AREA 13.50 ACRES  
 IN YELLOW FINAL BACKFILLED & LEVELED AREA 10.80 ACRES

DM

— MAP SHOWING PROPOSED 'A' & 'B' SEAM STRIPPING —  
 — OPERATED BY PIKE COAL COMPANY —  
 — COOPER TOWNSHIP CLEARFIELD COUNTY PENNA. —  
 — SCALE 1" = 100' — FEB. 2, 1967 —  
 — GUNNARD W. CARLSON OF BERNARD LUCAS ASSOC. —

C.D. 779

2787