


PEOF

4039

N  
Scale 1" = 100'

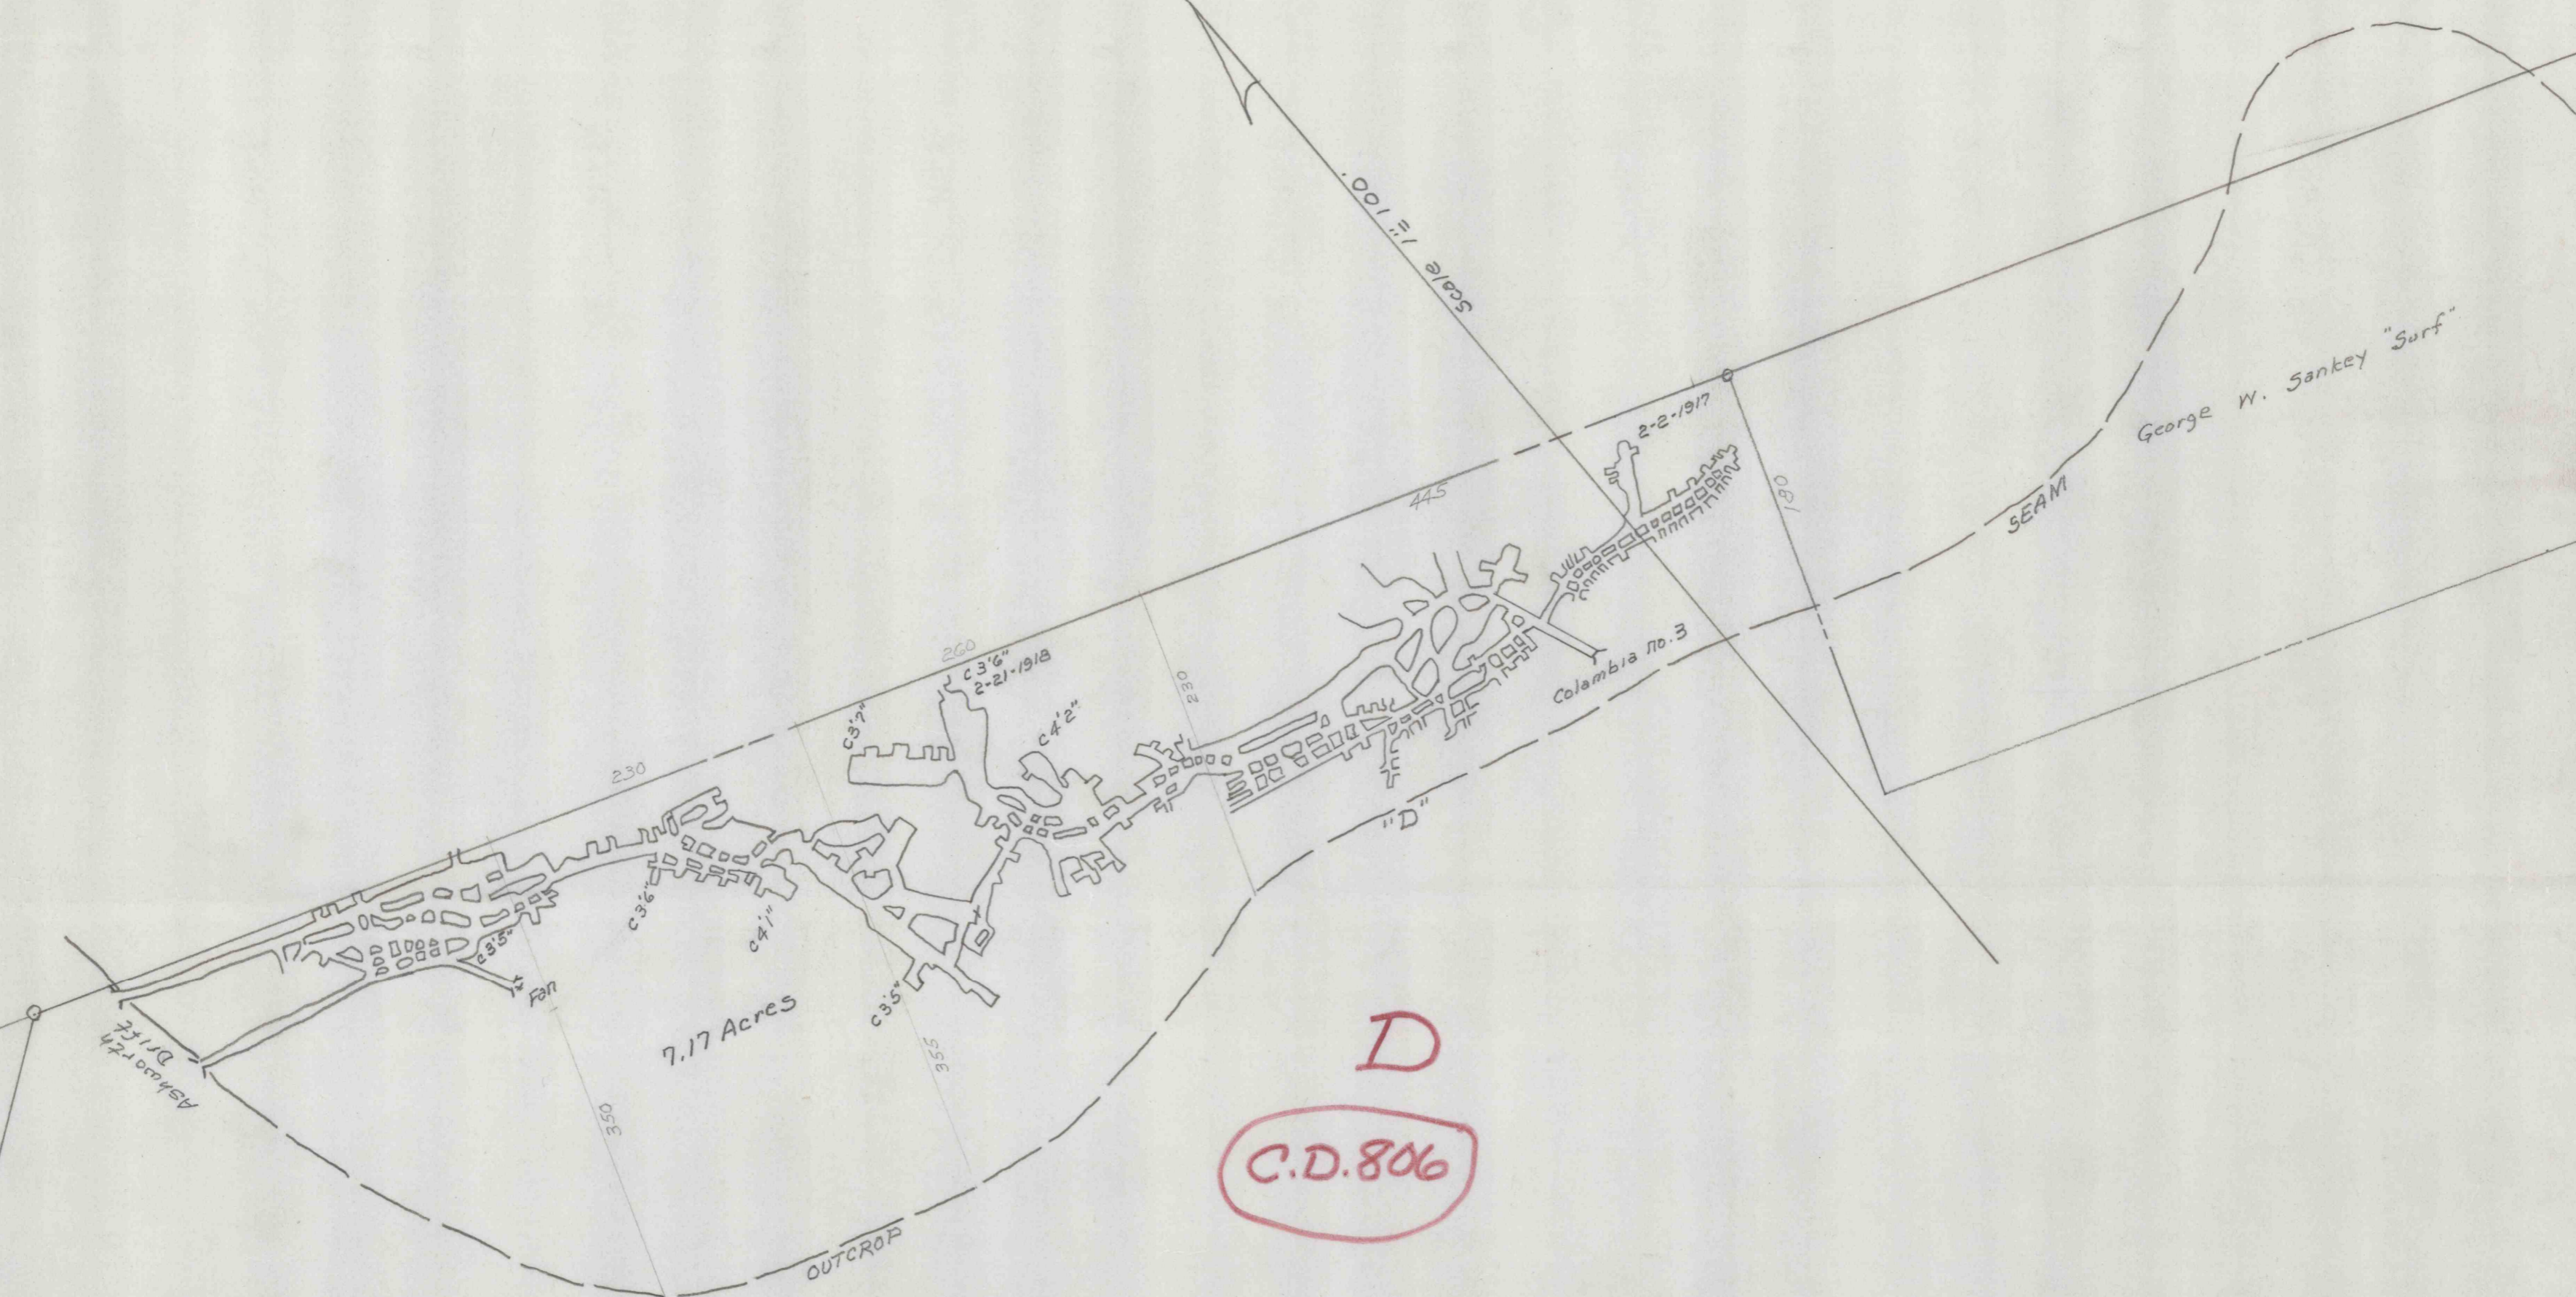

D  
C.D.806