

SURFACE
 NEW SHAWMUT MINING CO - MINERALS ST. MARYS PA.
~~PIETRO MICALE COAL CO - OPERATING CO BYRNEDALE PA.~~
 HAND COAL CO - OPERATORS R.O.I WEEDVILLE, PA.

SHEET 1 of 1

Hard Coal Company.
 Caledonia #13
 Weedville, Pennsylvania.
 Jay Township, Elk County.
 scale 1"=100 feet.
 Survey date JAN. 1, 1969


CONTEMPLATED MINING 61-69th 12-1-69
 SUPPORT AREA NONE
 PROTECTED AREAS NONE
 MINING COMPLETED

No 13 Drift CALEDONIA HOLLOW
 SCALE 1"=100 FT.


SURVEY-OF		
APRIL - 1 - 1949	BY	R.R.B.
APRIL - 24 - 1950	"	" " "
MAY - 8 - 1951	"	" " "
NOV - 17 - 1952	"	" " "
JAN - 15 - 1955	"	L. Burch
MAY - 1 - 1957	"	" " "
MAR - 26 - 1960	"	" " "
JAN - 15 - 1962	"	" " "
DEC - 7 - 1964	"	" " "
JAN 1, 1969	"	" " "

D
 C.D.803

R.R. Brown, ENGR. BYRNEDALE PA.

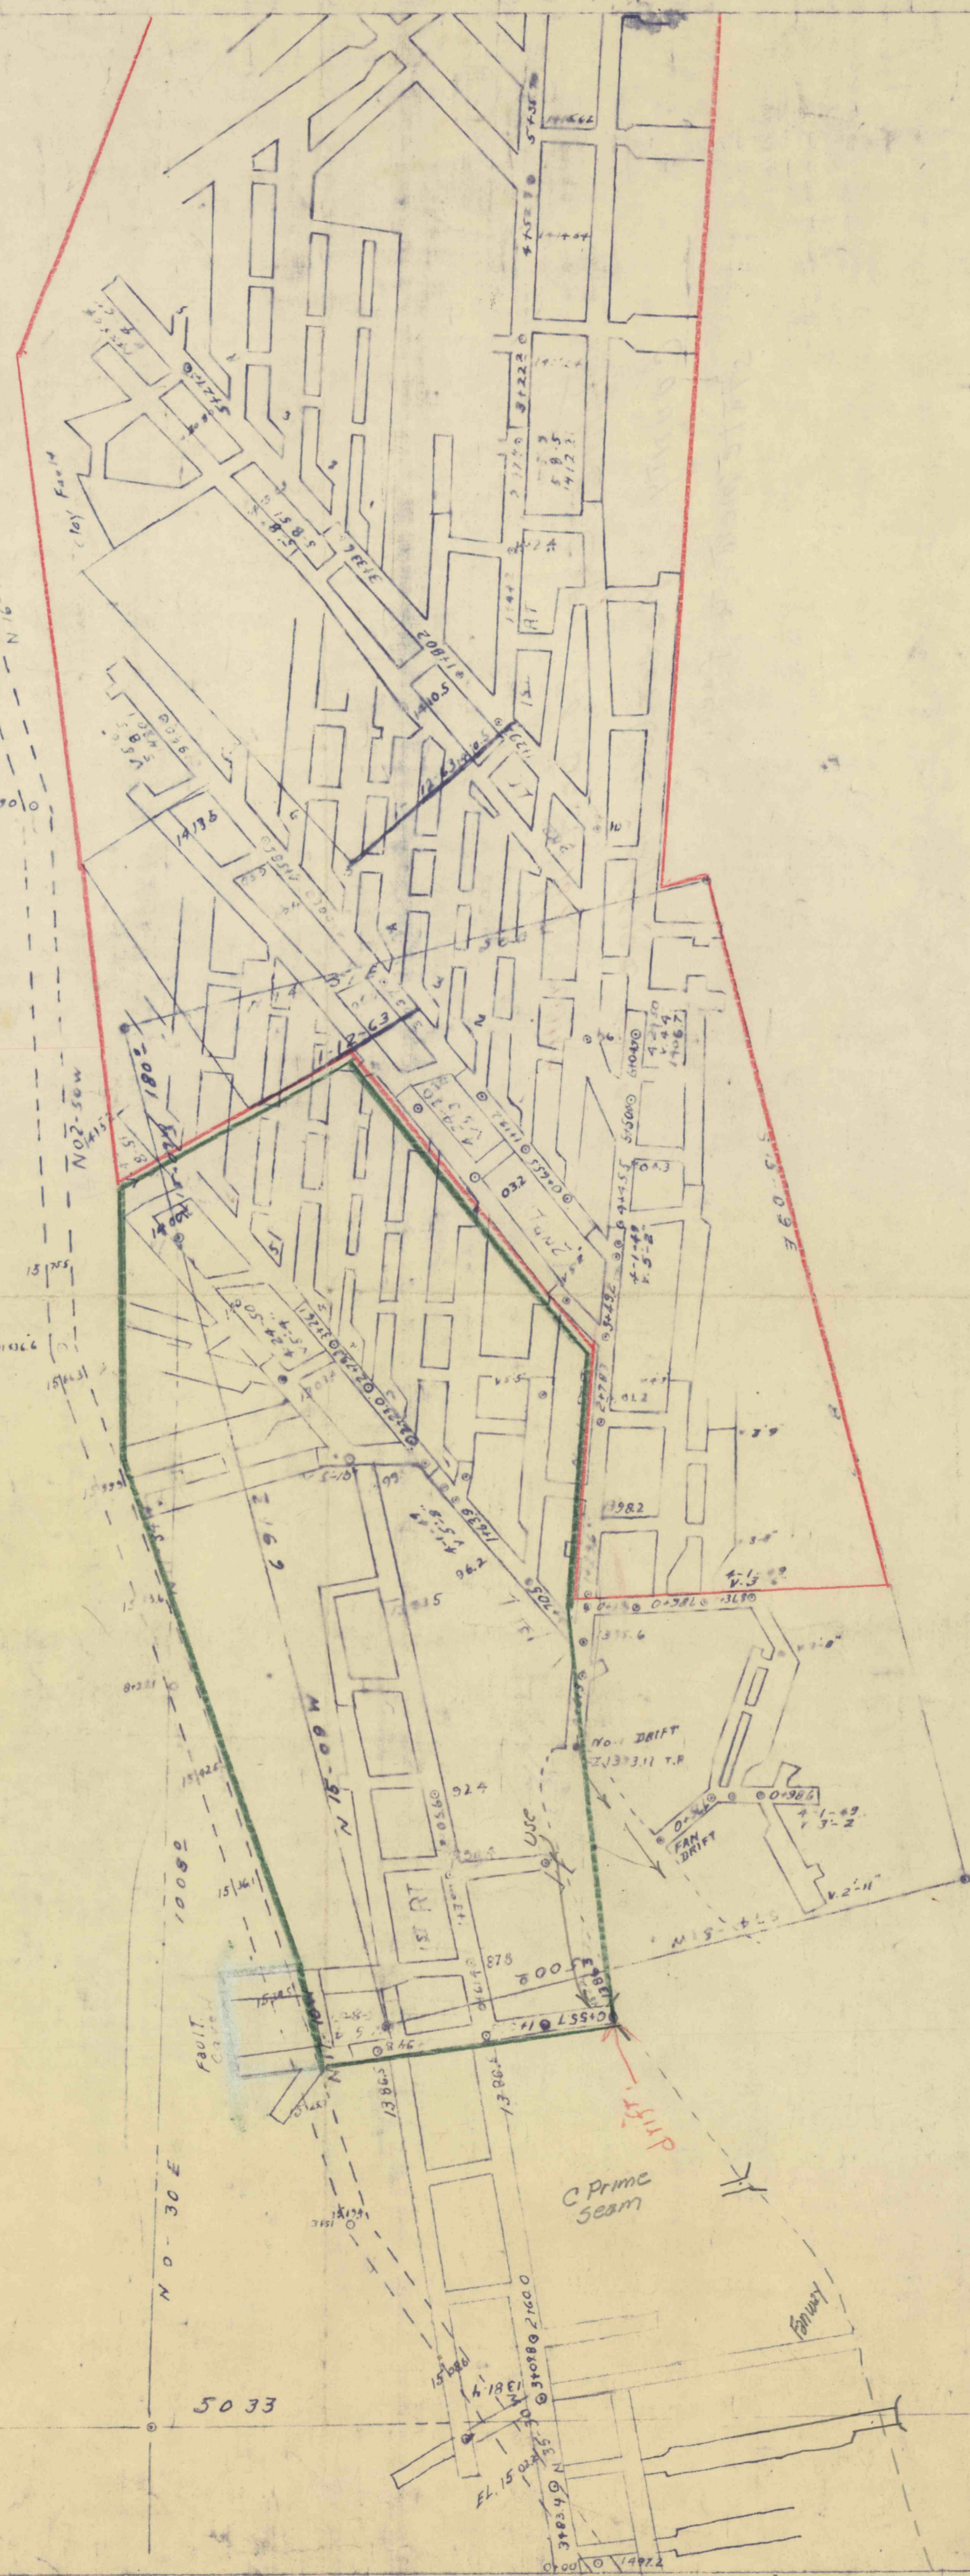

Micale Hand Coal Co.
 267 mo 23 old water permit No.

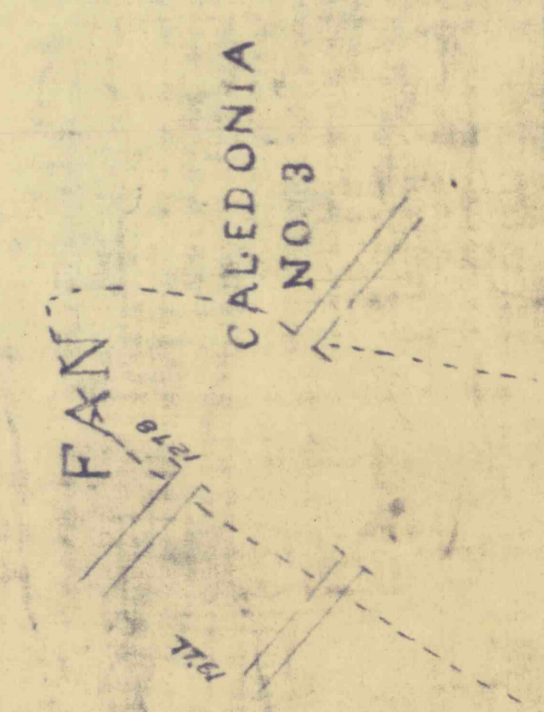

4960