


CARL ECKLUND

C. JOHNSON

DAN L. SPINGOLA

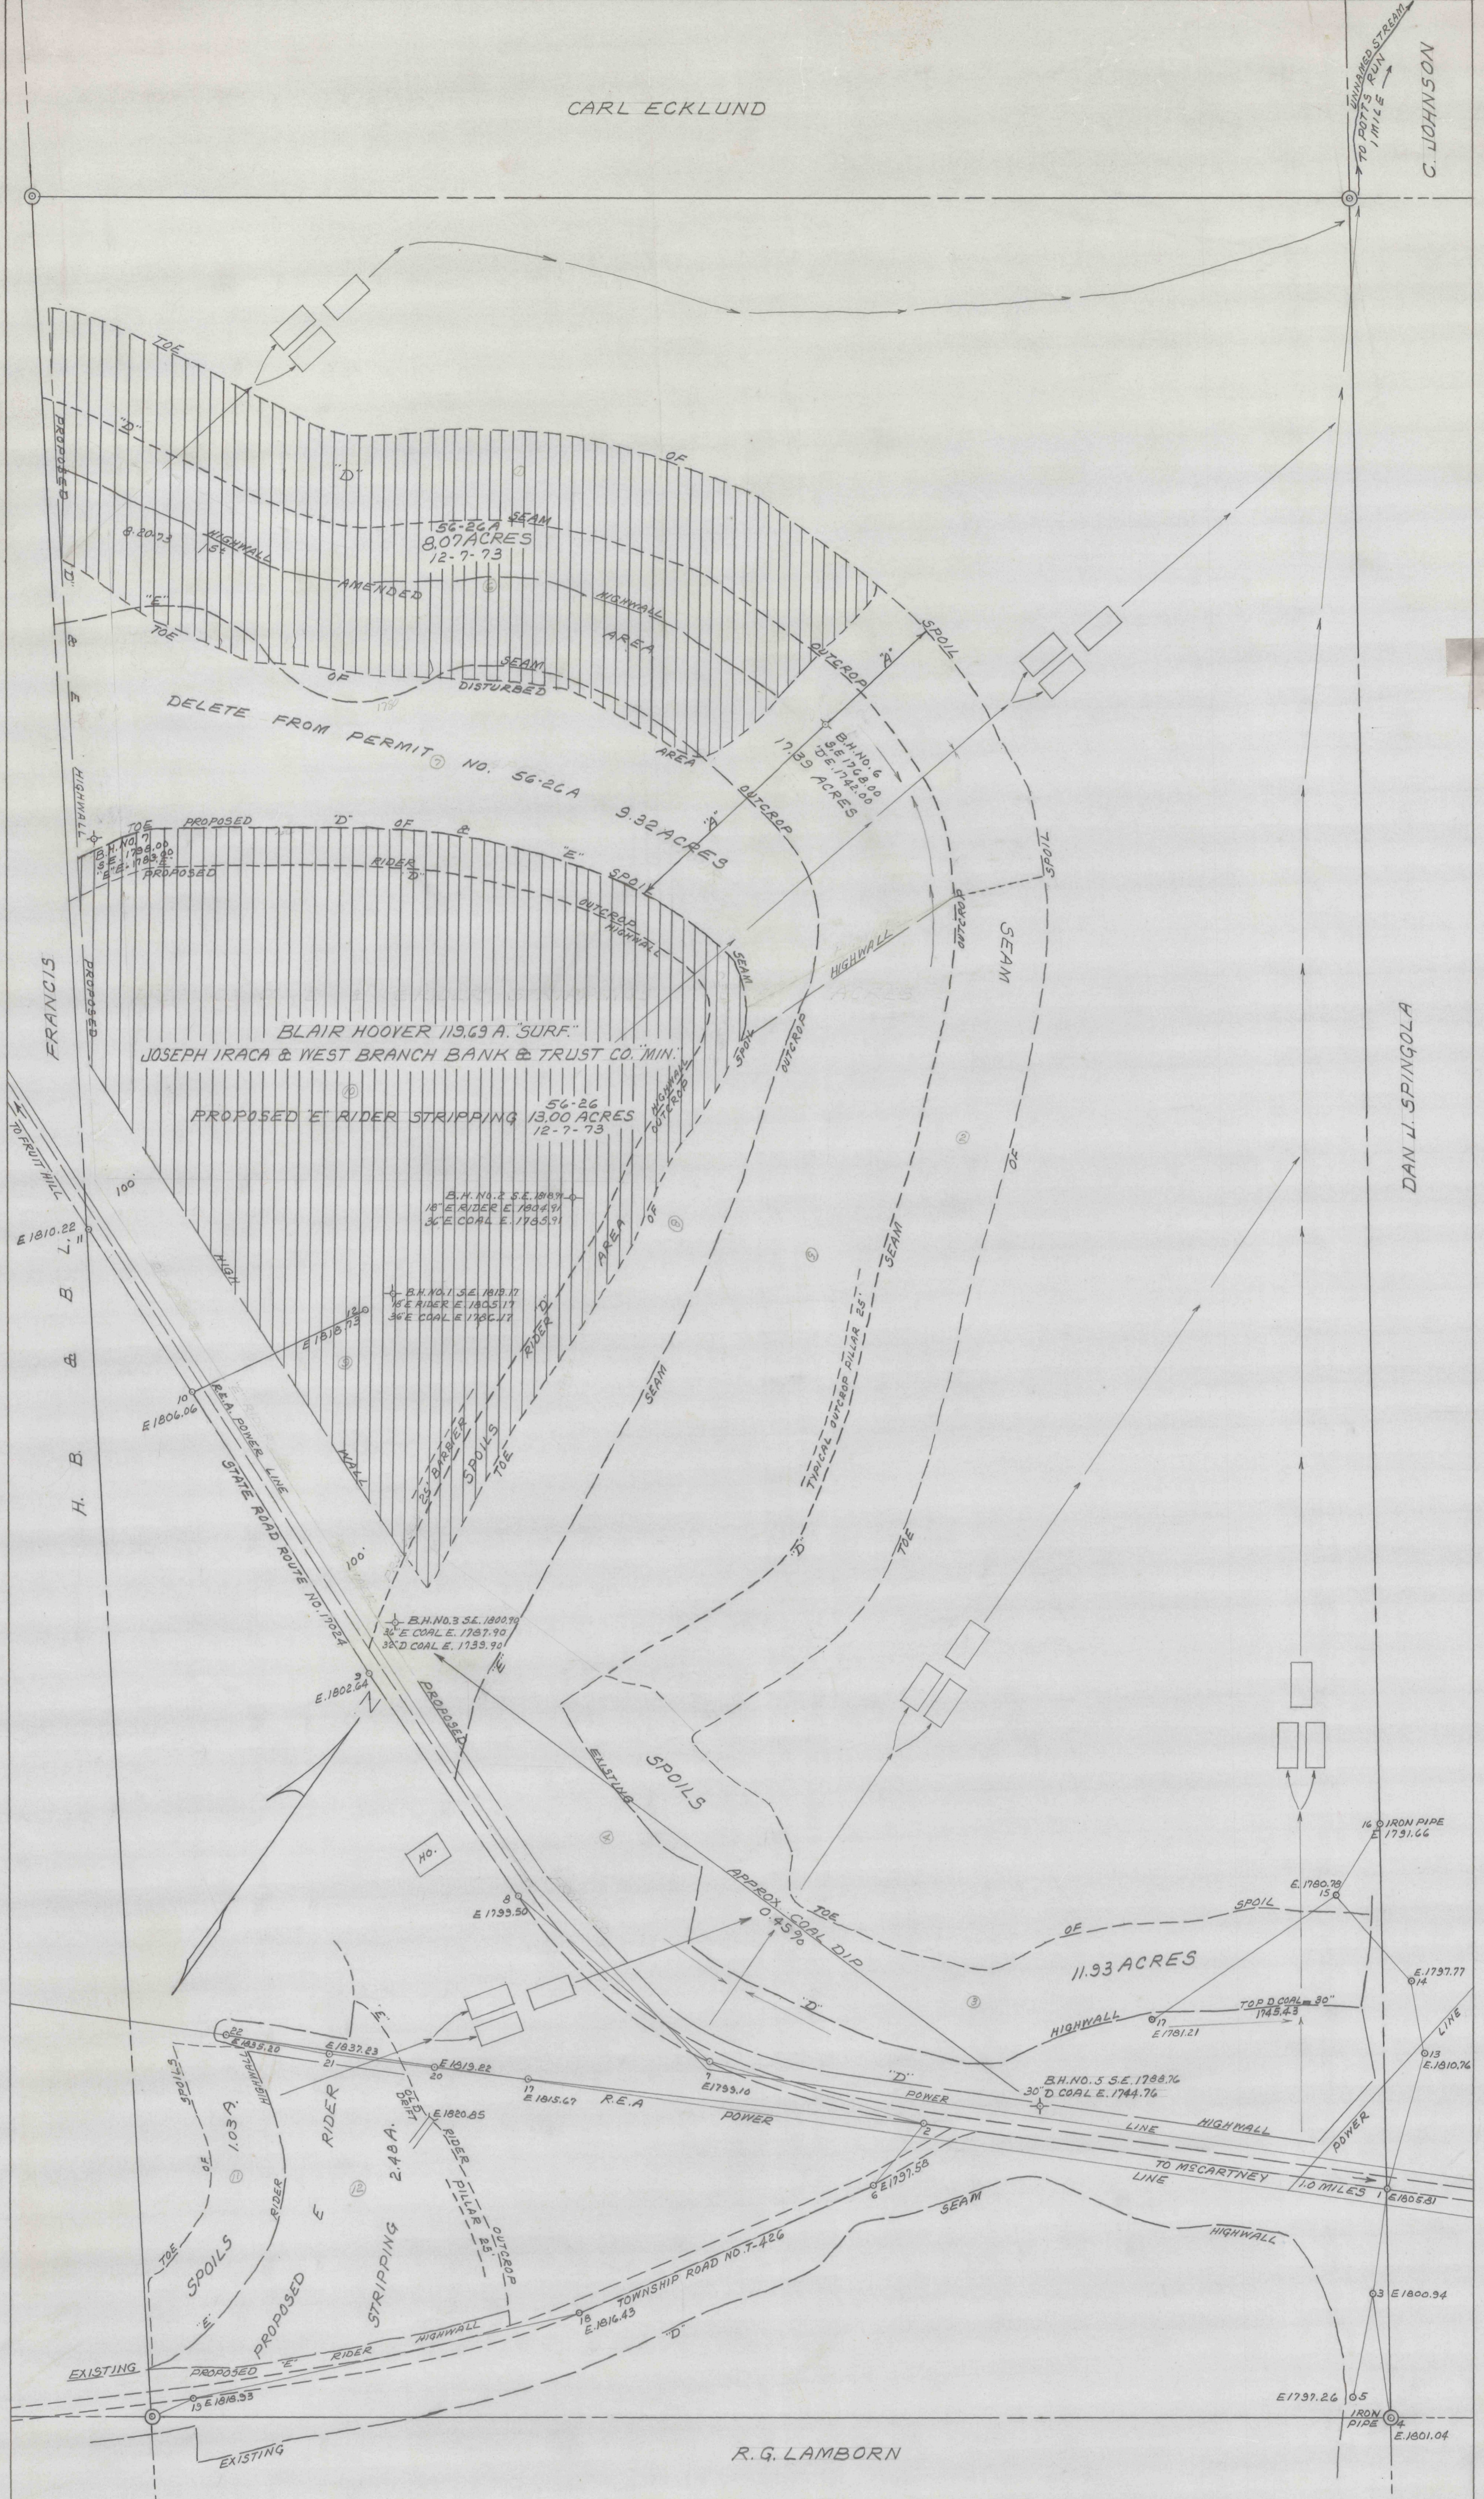

NOTE:
 PROPOSED "D" "E" & E RIDER STRIPPING 38.51 A. PLUS SPOILS 11.93 A.
 PROPOSED E RIDER STRIPPING 2.48 A. PLUS SPOILS 1.03 A.
 K. & J. STRIP MINE DRAINAGE PERMIT NO. 3269B5M26

NOTE
 10-13-72 ORIGINAL STRIPPING PERMIT 13.00 A. S.P.NO. 56-26 BOND 6/84.917
 8-20-73 13rd AMENDED AREA 17.39 A. + 15% 2.61A 56-26A BOND 8061-70.00
 12-7-73 56-26 BACKFILLED AND LEVELED 13.00 ACRES
 12-7-73 56-26A BACKFILLED AND LEVELED 8.07 ACRES
 12-7-73 56-26A DELETE FROM PERMIT 9.32 ACRES
 12-7-73 PLUS 15% 2.61 ACRES
 TOTAL 33.00 ACRES

M

MAP SHOWING PROPOSED "D" "E" & E RIDER STRIPPING
 OPERATED BY KRISTIANSON & JOHNSON COAL COMPANY INC.
 JORDAN TOWNSHIP CLEARFIELD COUNTY PENNA.
 SCALE 1"=100' AUG. 1, 1969

G.W. CARLSON OF BERNARD LUCAS ASSOC.

C.D. 642

PEIA

413A