


4115

4162

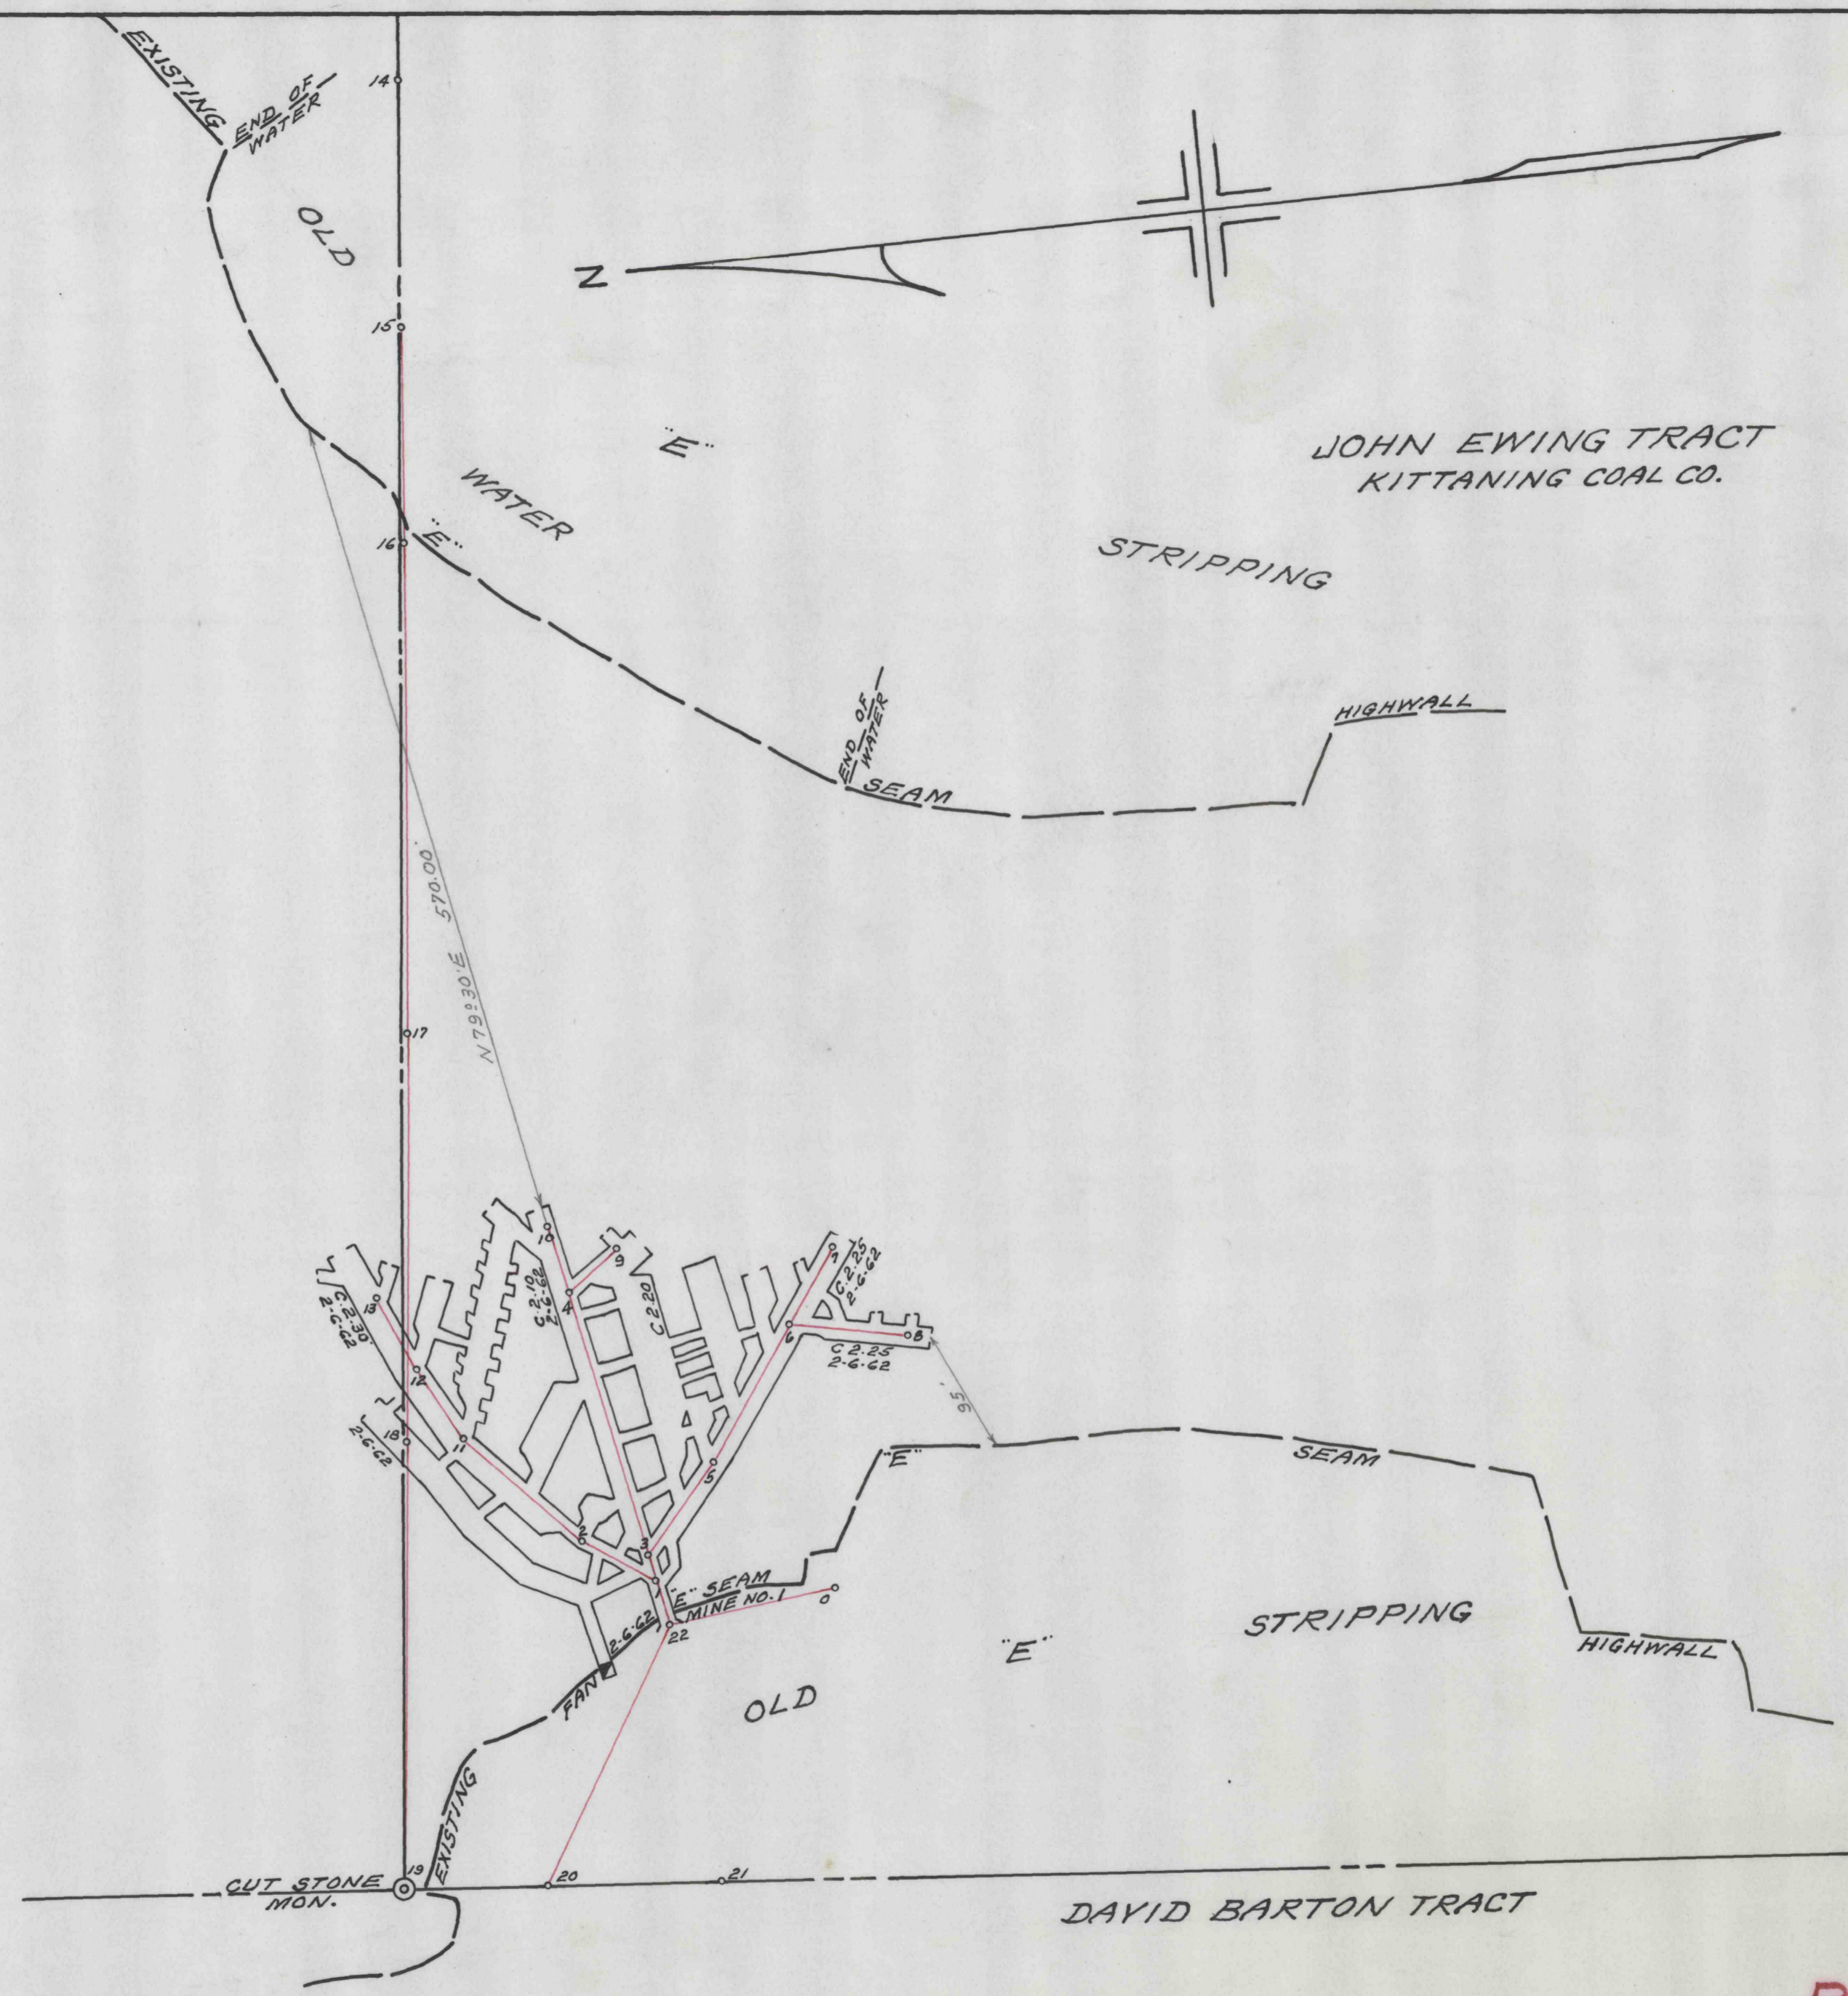

PD

— MAP SHOWING "E" SEAM DEEP MINE NO. 1 —
 — OPERATED BY HILL COAL CO. - ALBERT SROCK —
 — GULICH TWP. CLEARFIELD COUNTY PENNA. —
 — SCALE 1"=100' — FEB. 8, 1962 —
 — BERNARD LUCAS ASSOCIATES —

C.D. 706