

817


JOHN AND CLAIR GOSS

KRISTIANSON & JOHNSON COAL CO.

LAMADLIE

WILLIAM

JOHN THOMPSON

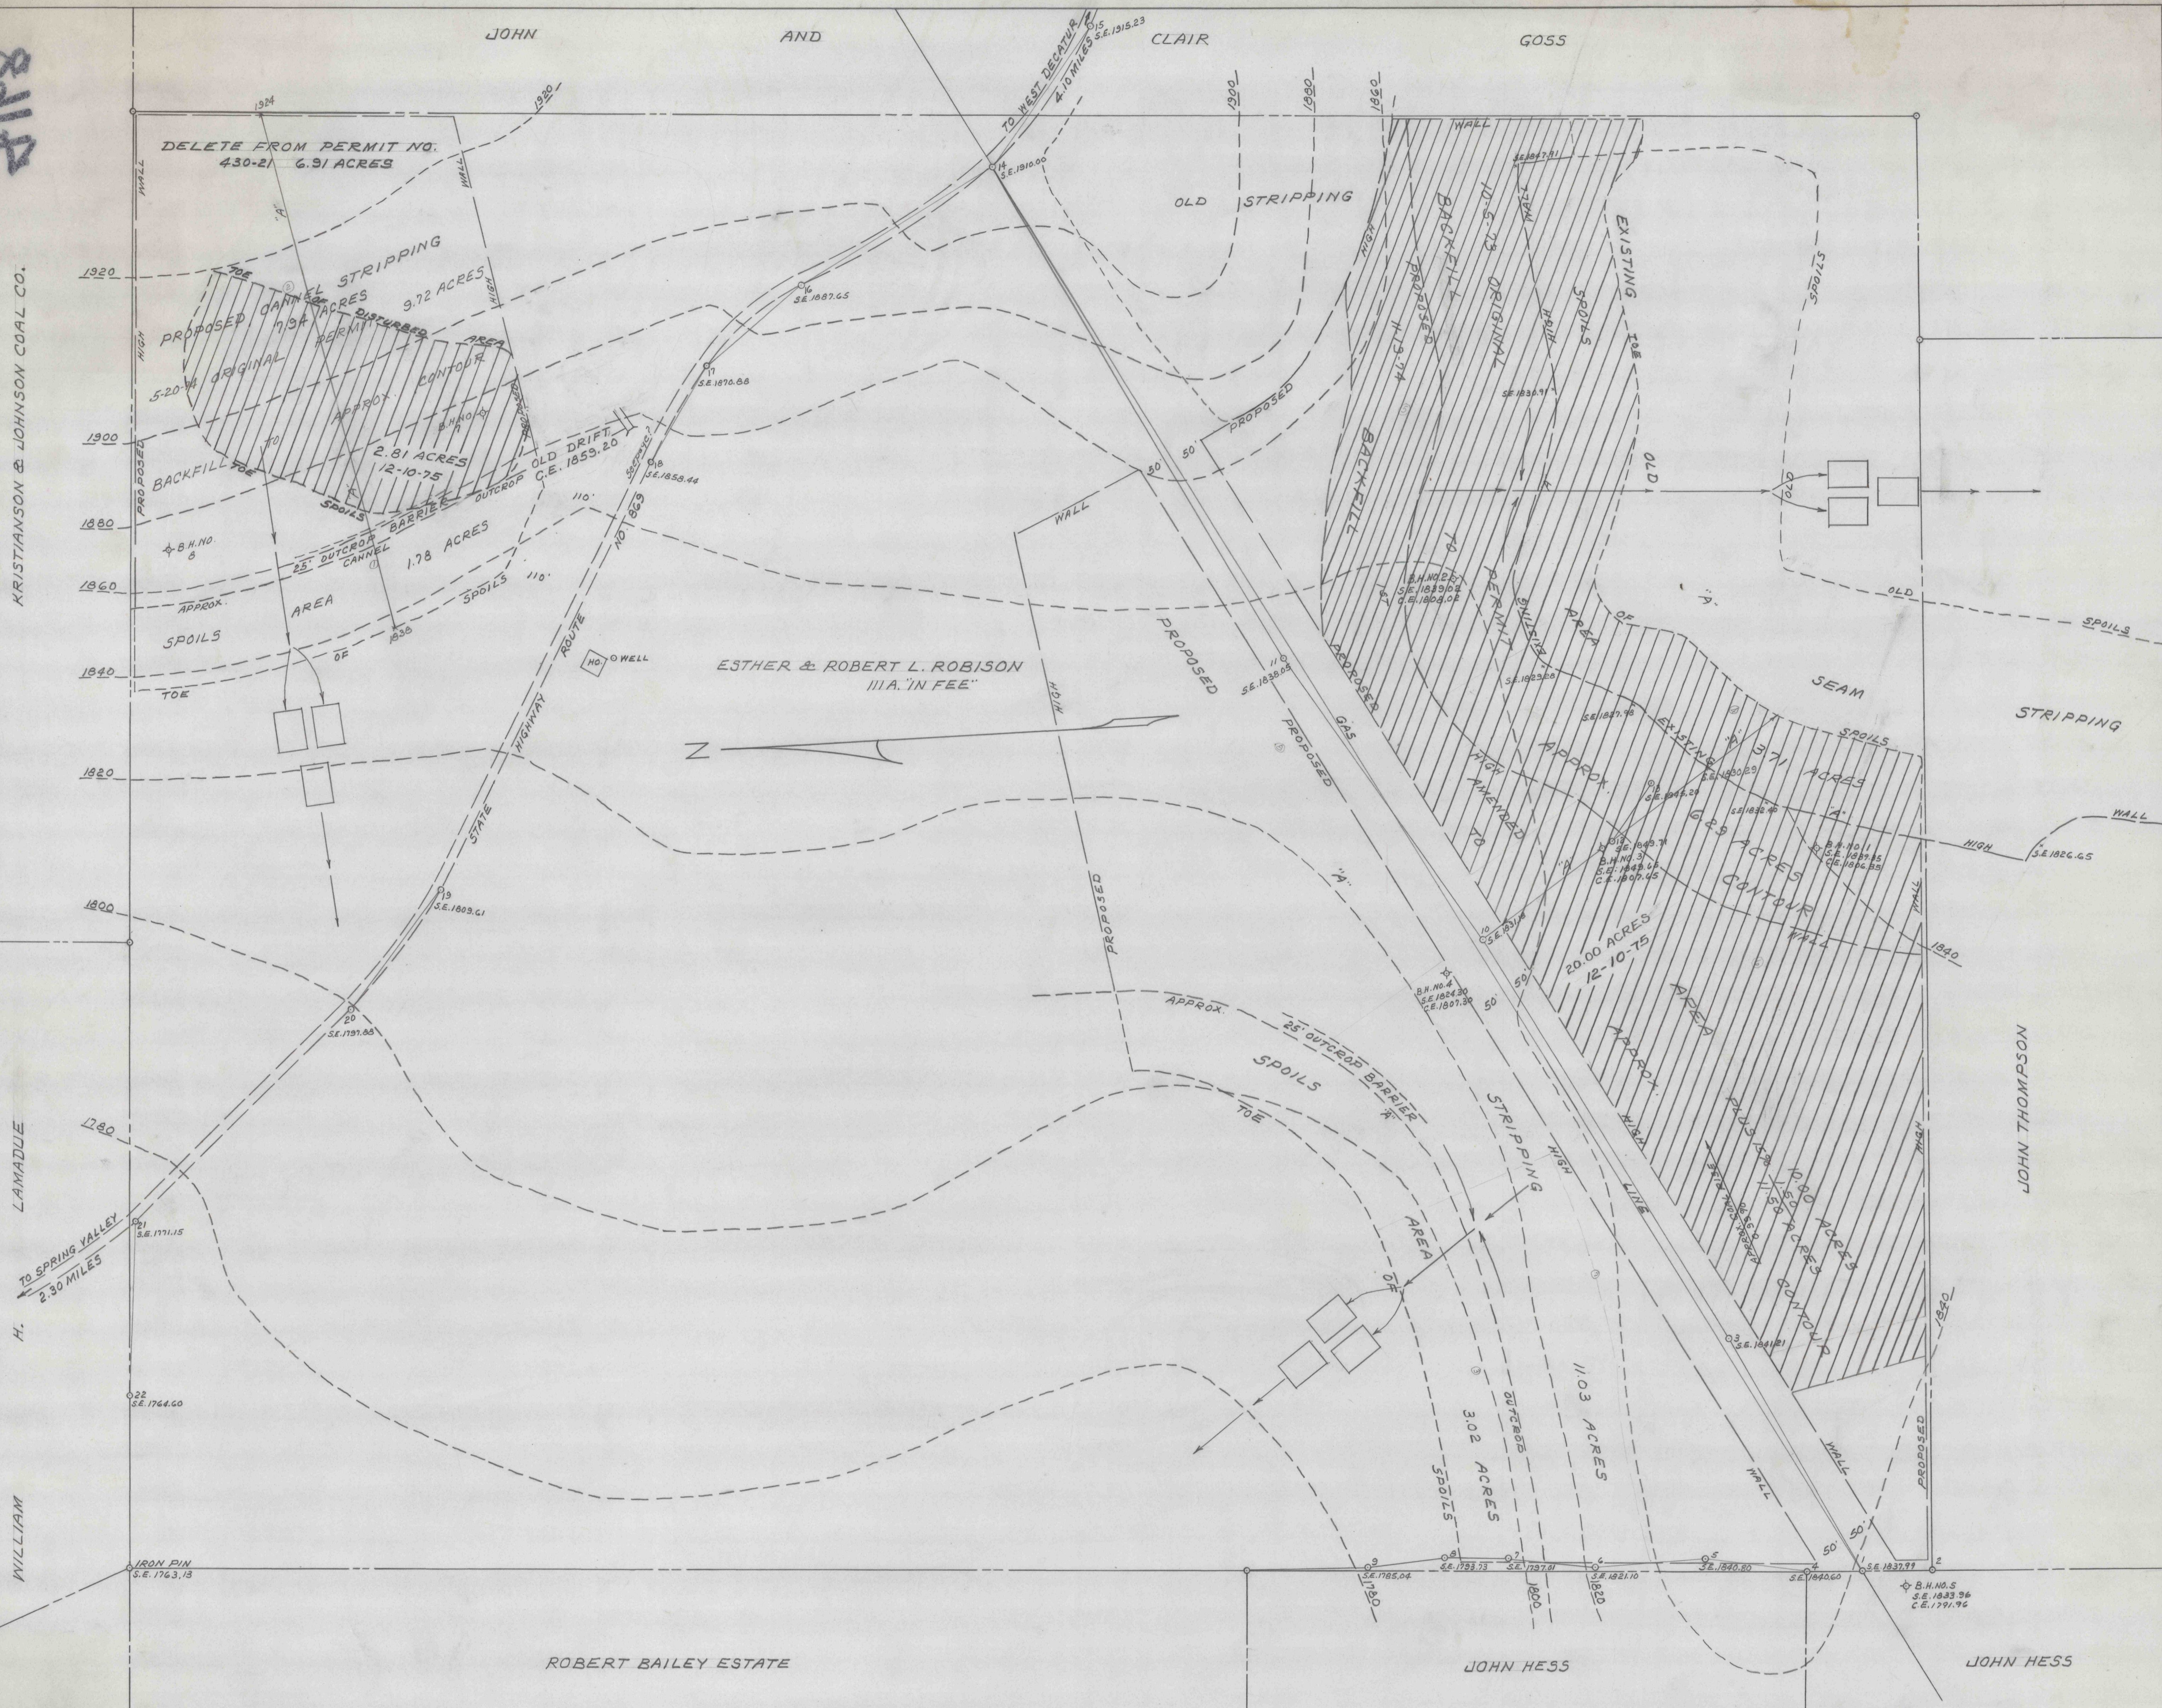

NOTE:  
 PROPOSED CANNEL SEAM STRIPPING 7.94 A. PLUS SPOIL AREA 1.78 A. = 9.72 ACRES  
 PROPOSED A SEAM STRIPPING 28.13 A. PLUS SPOIL AREA 6.73 A. = 34.86 ACRES  
 PIKE NO. 14 M.D. PERMIT NO. 4472 S/118 TOTAL AFFECTED AREA 44.58 ACRES

NOTE:  
 10-5-73 ORIGINAL STRIPPING PERMIT 10.00 A. S.P. NO. 430-13 BOND NO. 324 A 6000  
 11-13-74 1<sup>st</sup> AMENDED AREA 10 A. PLUS 15% 11.50 A. S.P. NO. 430-13A BOND NO. 497 B 2952  
 12-10-75 BACKFILLED & LEVELED 20.00 ACRES

NOTE:  
 5-20-74 ORIGINAL STRIPPING PERMIT 9.72 A. S.P. NO. 430-21 BOND NO. 216 B 3336  
 12-10-75 BACKFILLED & LEVELED 2.81 ACRES  
 12-10-75 DELETE FROM PERMIT 430-21 6.91 ACRES

MAP SHOWING CANNEL AND A SEAM STRIPPINGS  
 OPERATED BY PIKE COAL COMPANY  
 BOGGS TOWNSHIP CLEARFIELD COUNTY, PENNA.  
 SCALE 1" = 100' OCT. 24, 1972  
 BERNARD LUCAS ASSOC.

C.D. 648

4168