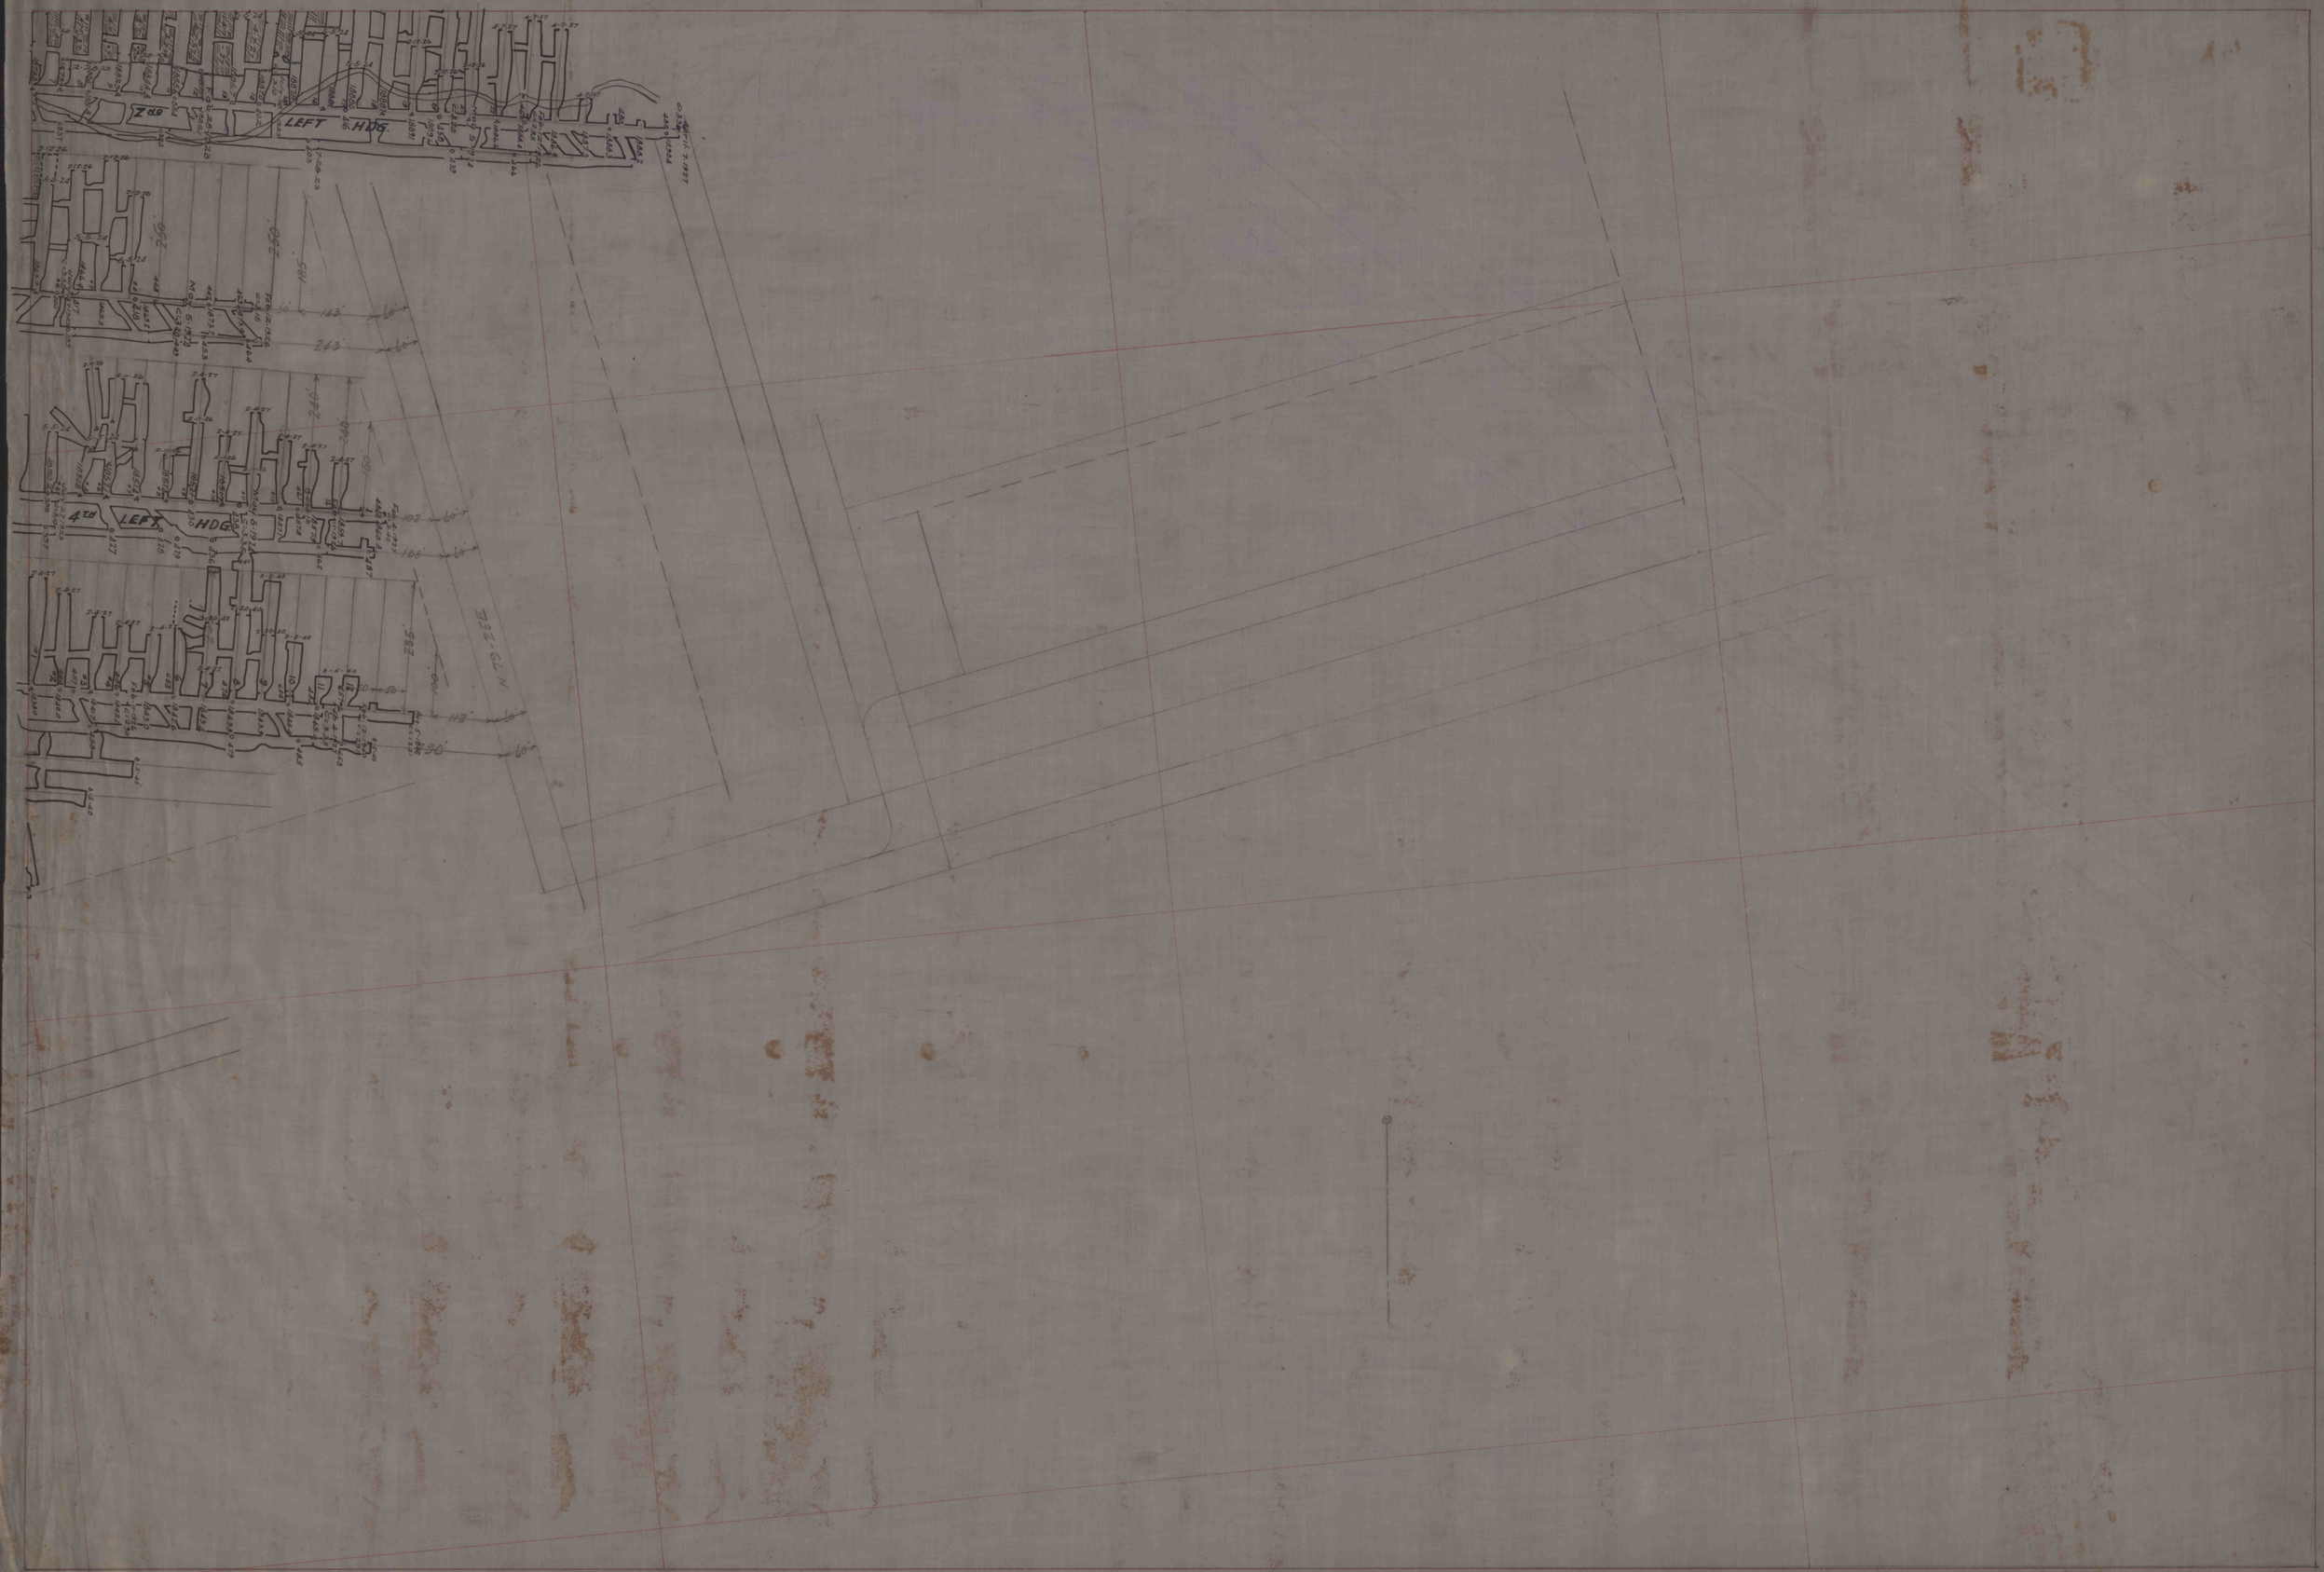

2nd LEFT HDG.
4th LEFT HDG.
N 79-25E