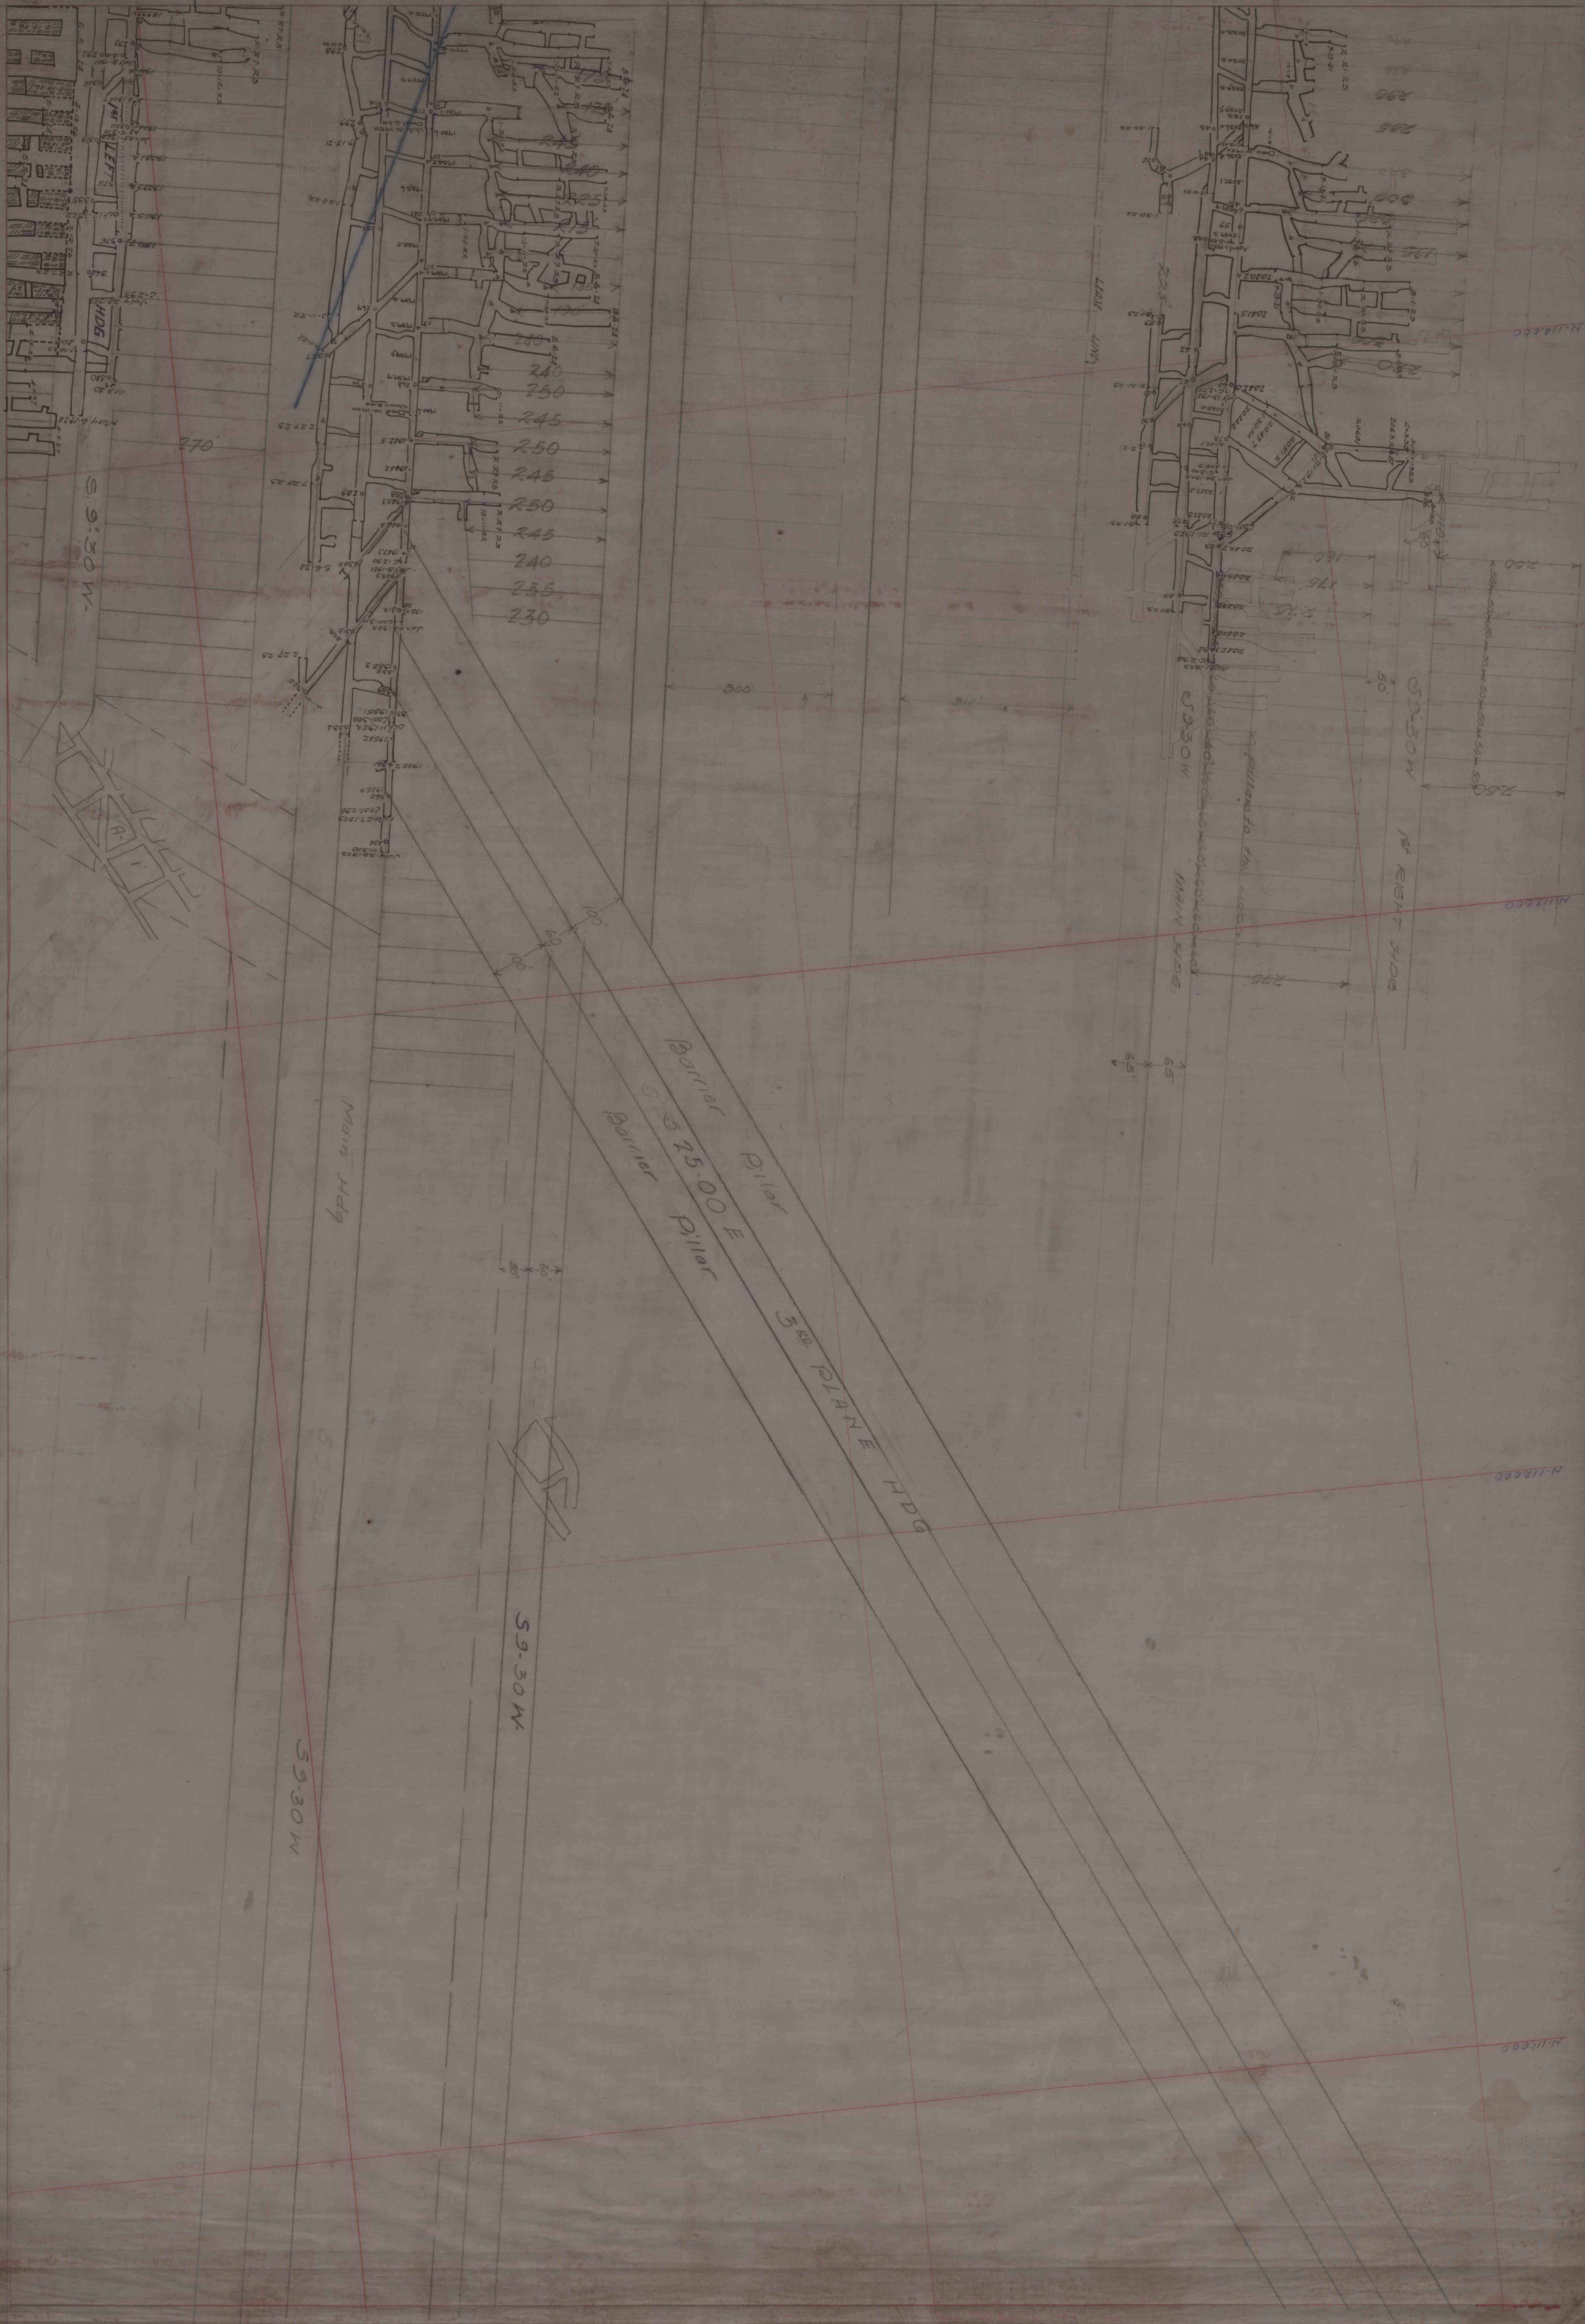

Barrier Pillar
S 25·00 E
Barrier Pillar
3rd PLANE HDG
Main Hdg
S.9°30 W.
S9-30 W
S9·30 W.
S9·30 W
1st LEFT HDG
LEASE LINE
S9-30 W
MAIN HDG
S9-30 W
1st RIGHT HDG
Pillars to the lines
270'
300'
275'
250
N-114,000
N-113,000
N-112,000
N-111,000