


HOWARD H. ROWLAND EST.

WILLIAM WILSON TRACT
S.P. HANSEL

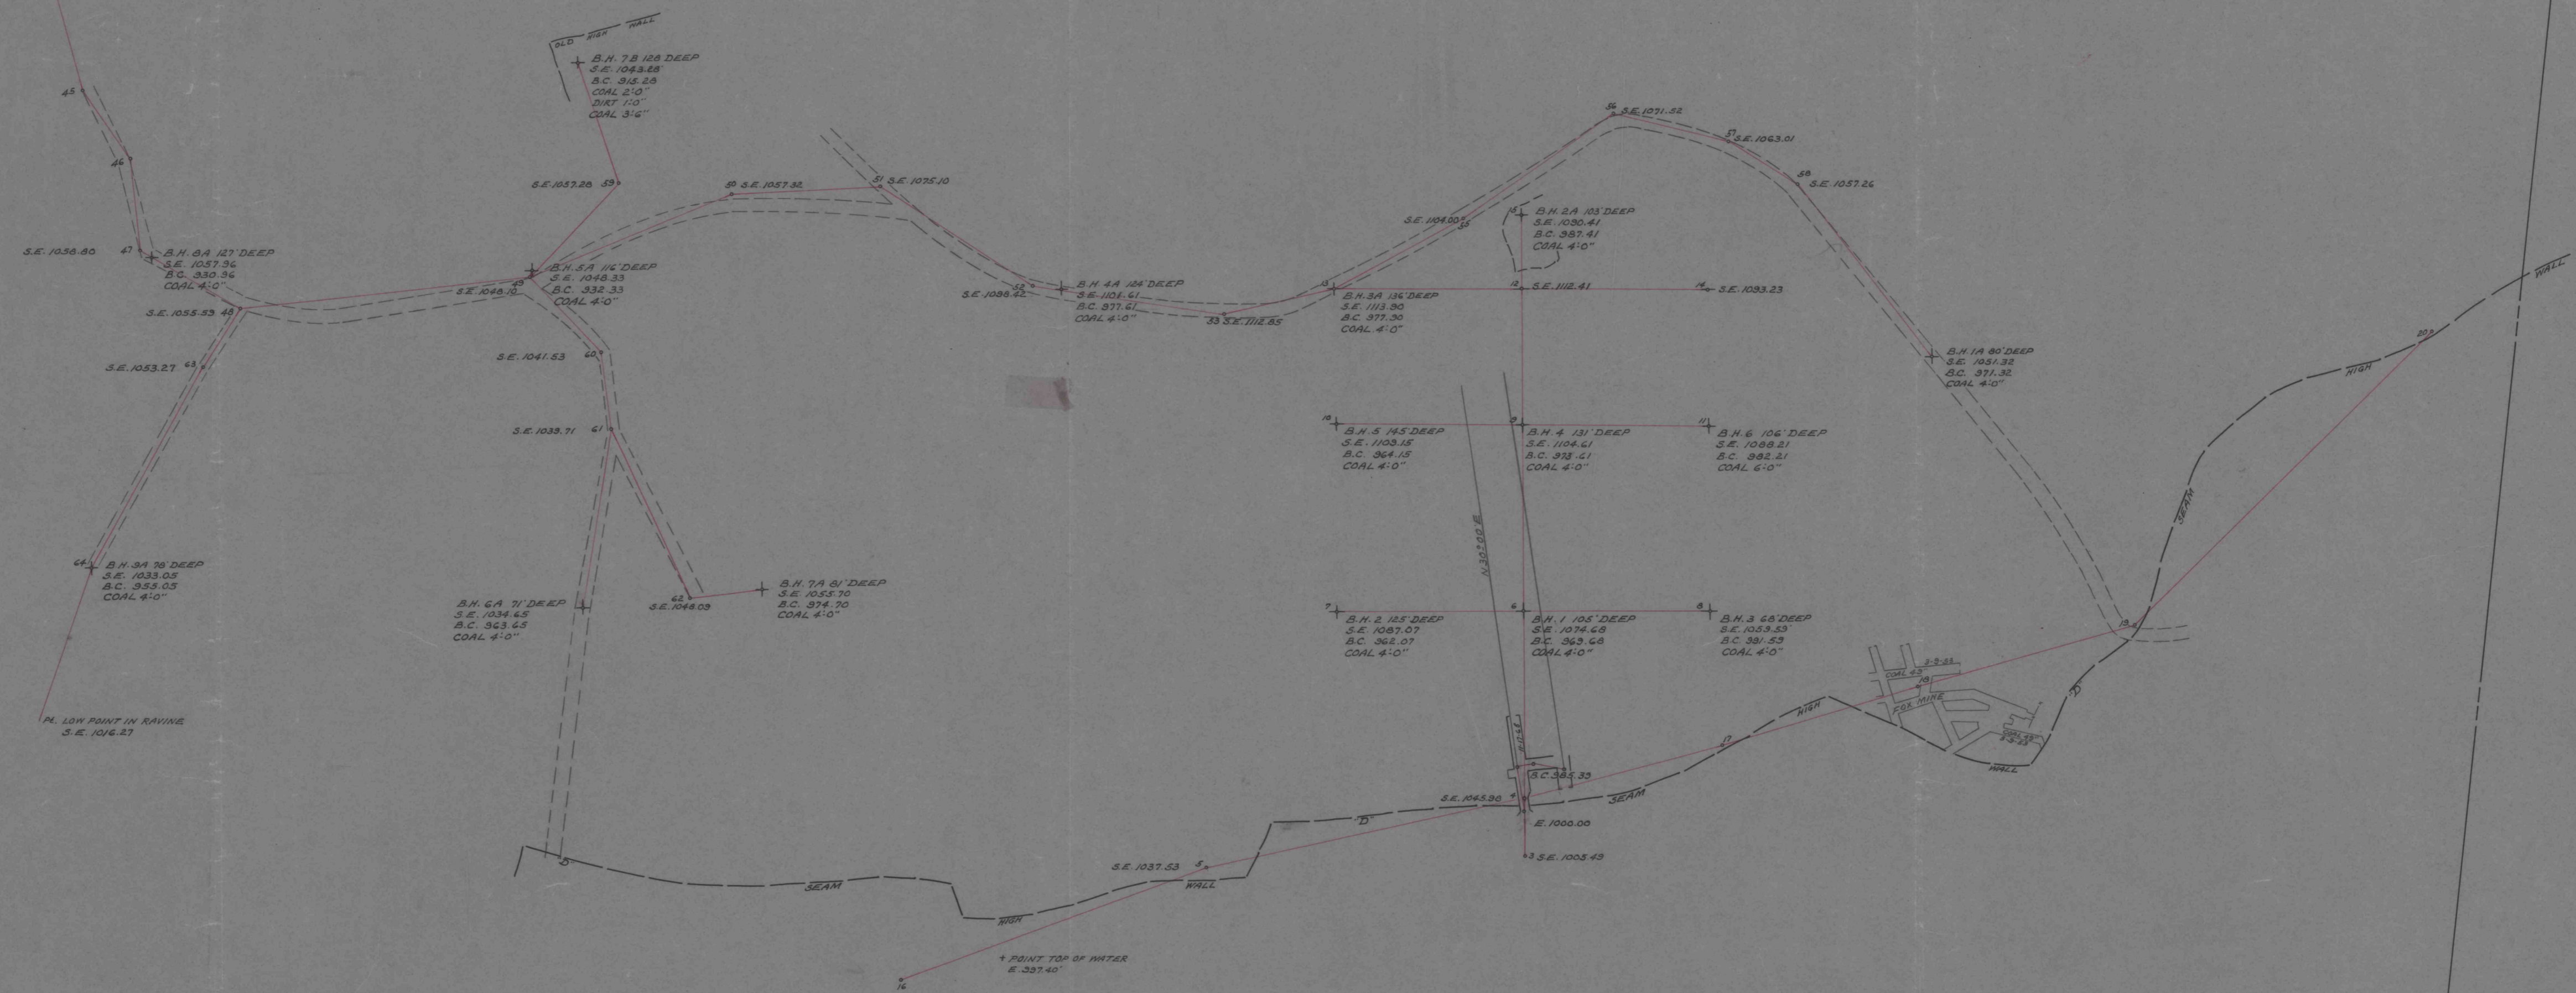

H.H. Rowland Prop
Woodward Prop
DH
C.D. 760

NOTE:
S.E. = SURFACE ELEVATIONS
B.C. = BOTTOM OF COAL SEAM
SCALE 1/2" = 100' OCT. 13, 1965

4242

4242

4242