


8957

4298

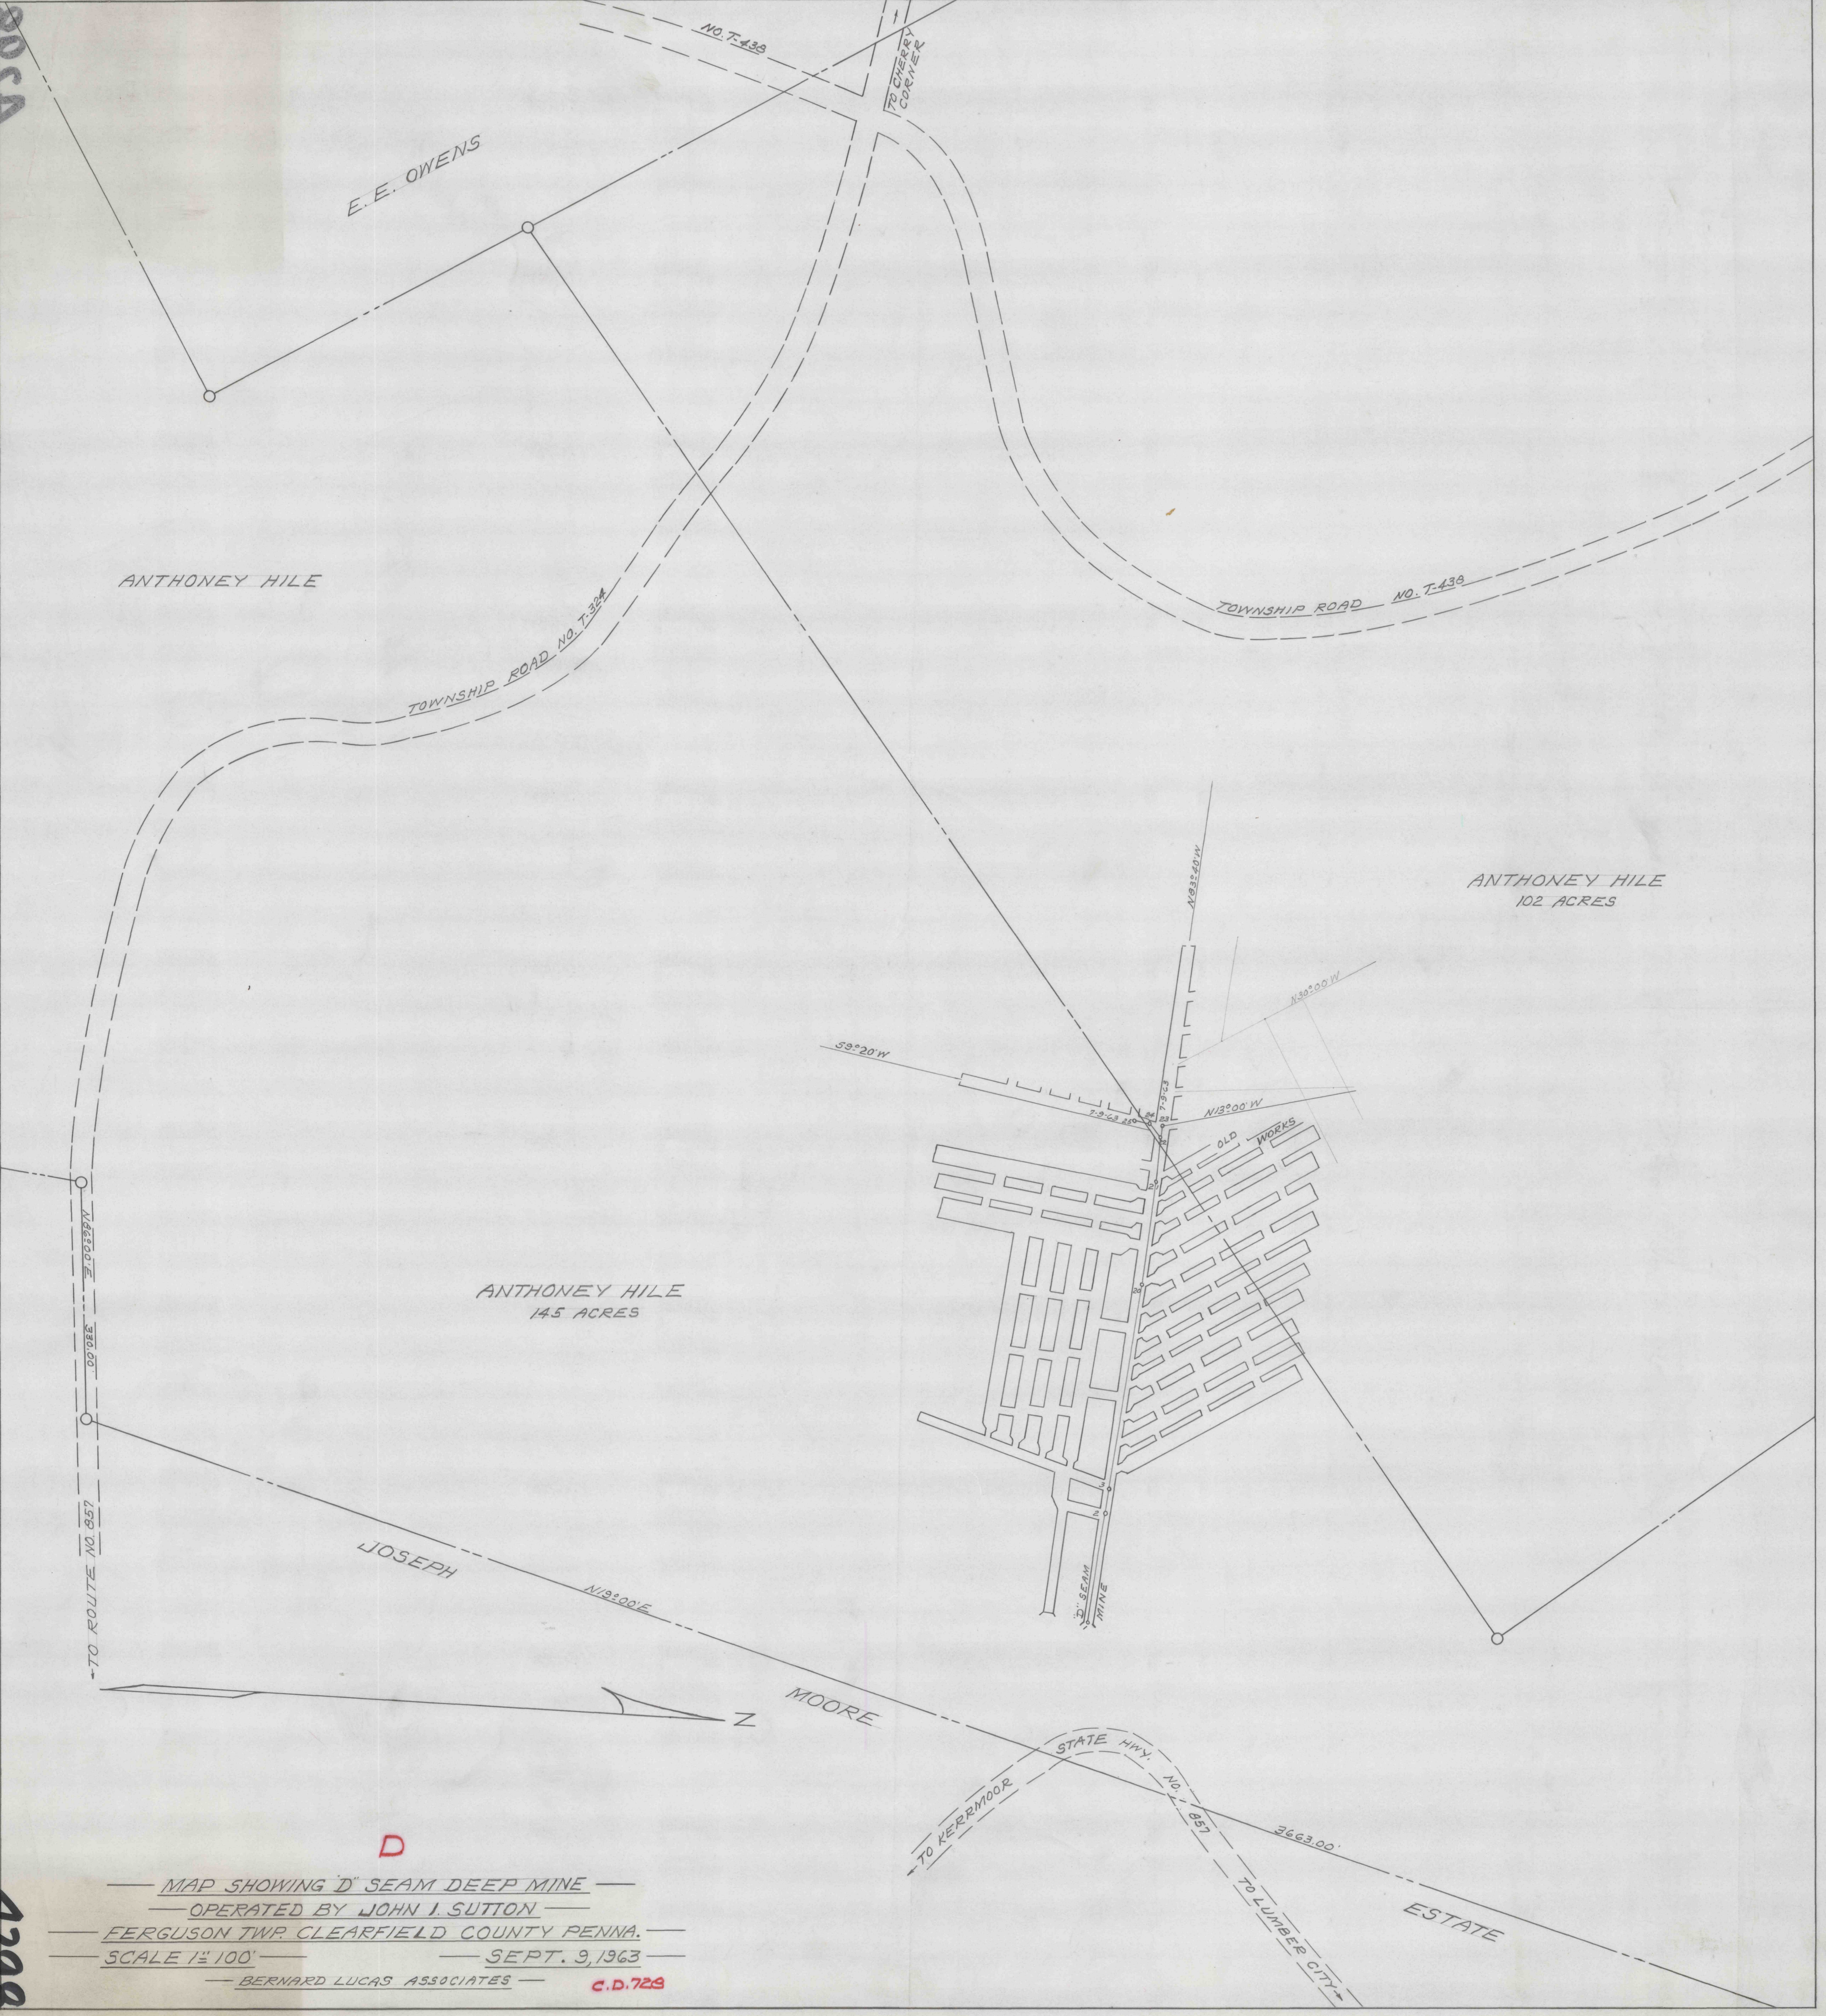

D

— MAP SHOWING 'D' SEAM DEEP MINE —
 — OPERATED BY JOHN I. SUTTON —
 — FERGUSON TWP. CLEARFIELD COUNTY PENNA. —
 — SCALE 1"=100' — SEPT. 9, 1963 —
 — BERNARD LUCAS ASSOCIATES — C.D. 729