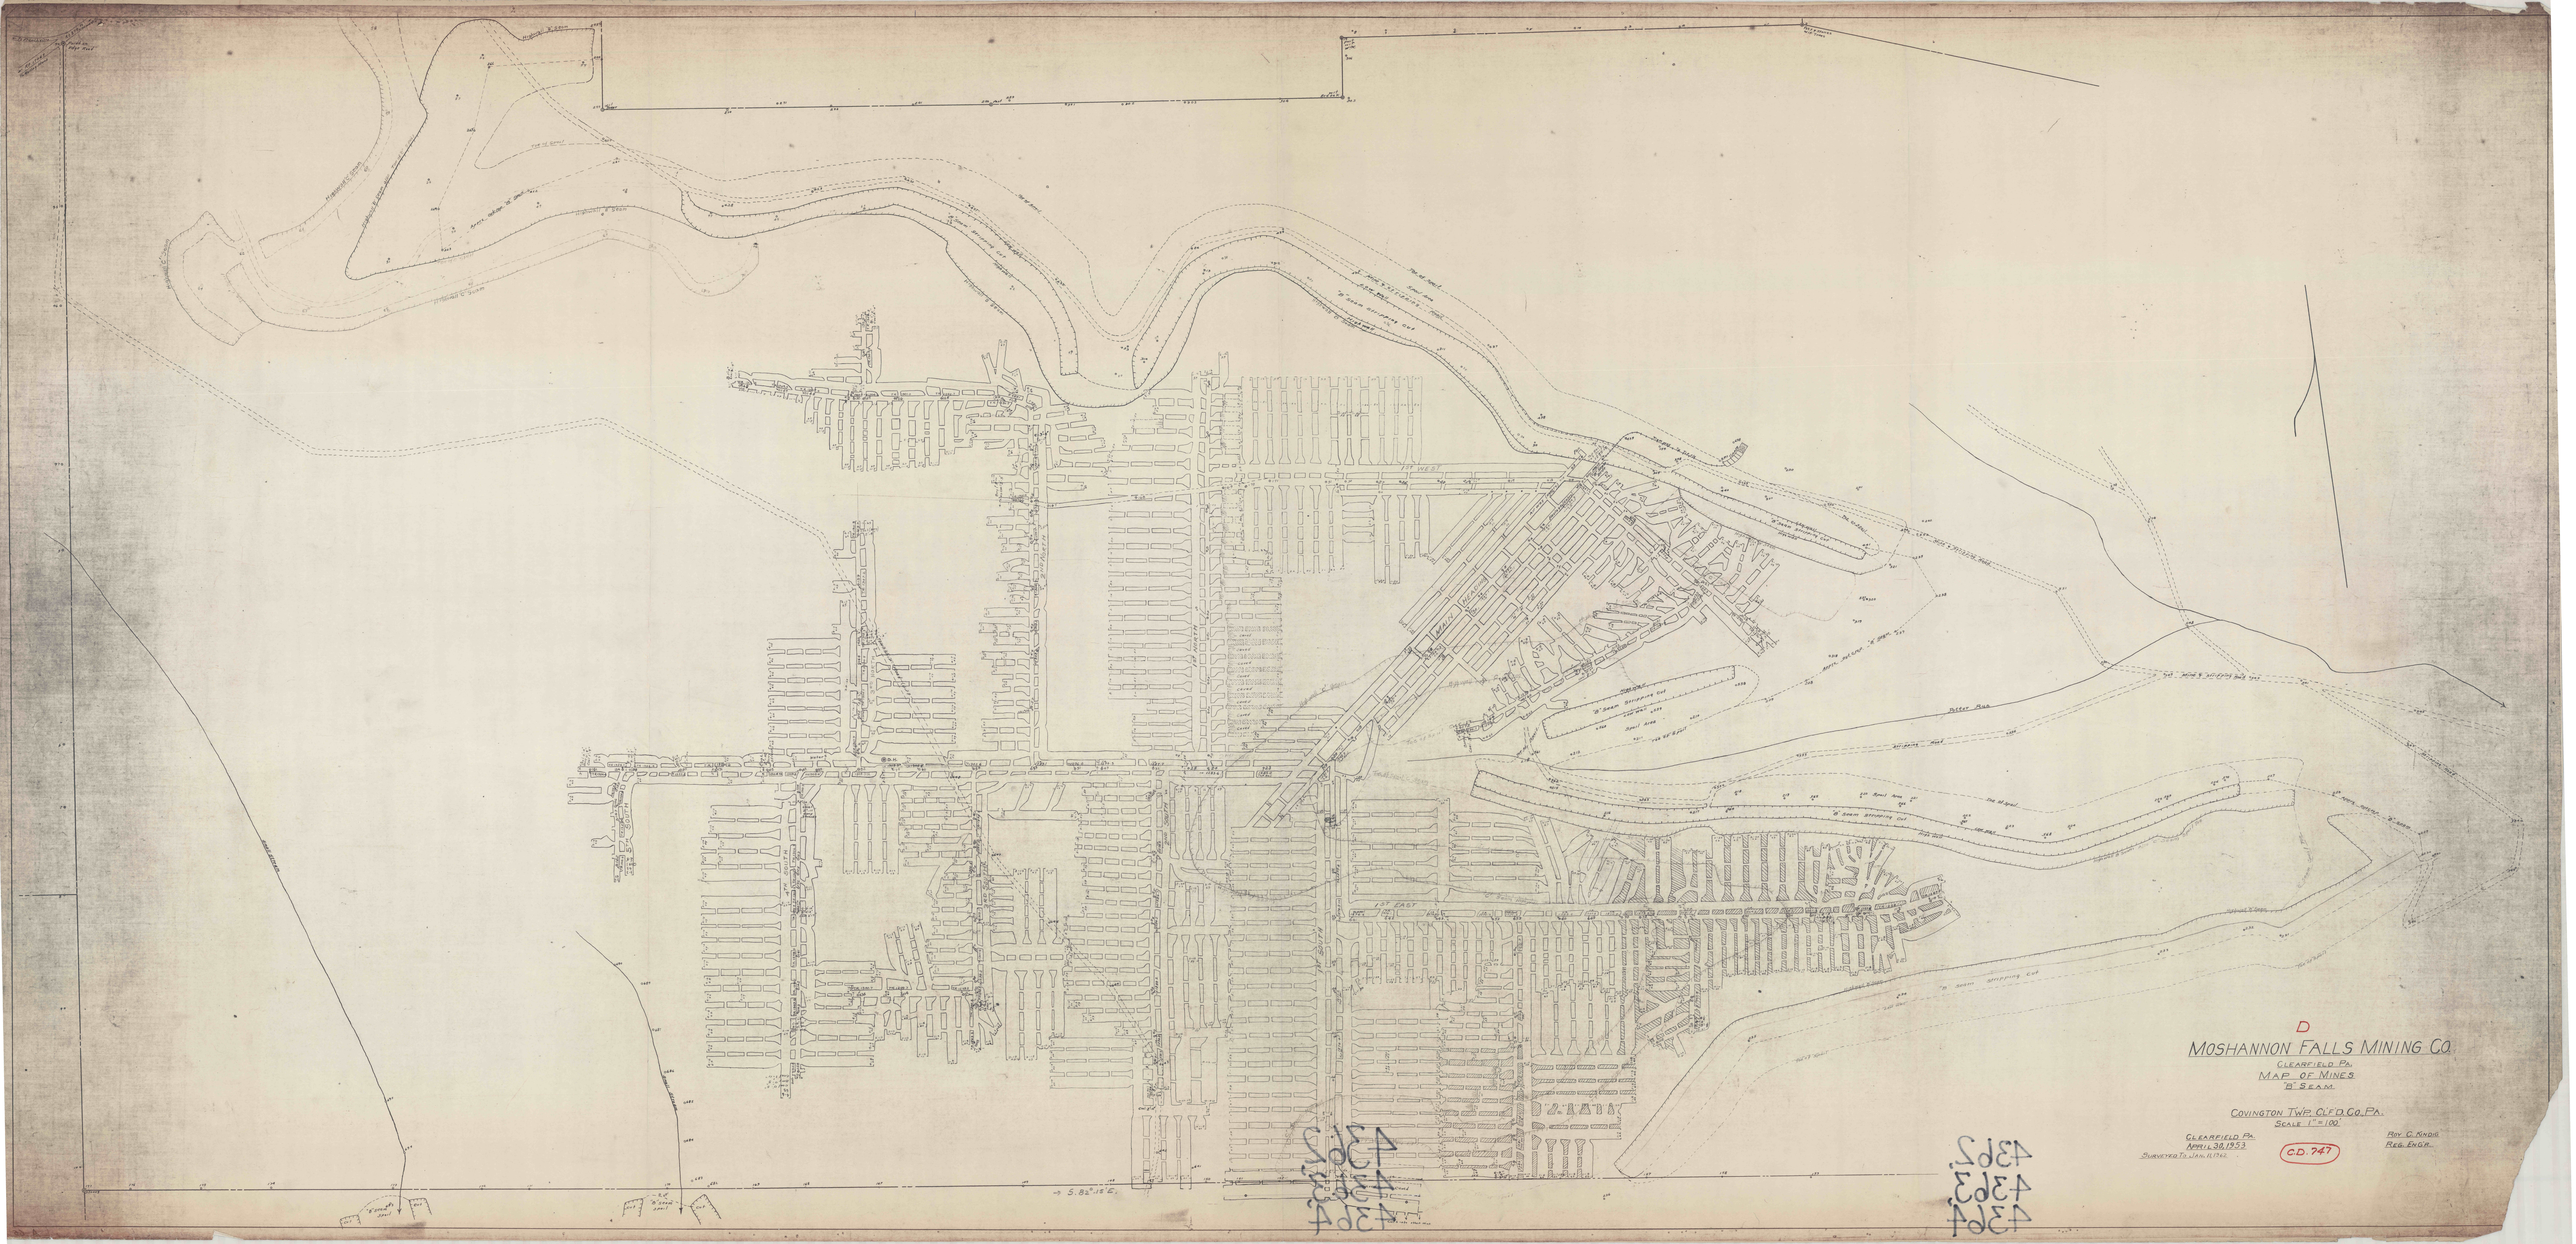
D
MOSHANNON FALLS MINING CO.
CLEARFIELD PA.
MAP OF MINES
"B" SEAM
COVINGTON TWP. CLFD. CO. PA.
SCALE 1" = 100'
CLEARFIELD PA.
APRIL 30, 1953
SURVEYED TO JAN. 11, 1941
ROY C. KNOX
REG. ENGR.
C.D. 747
1ST WEST
1ST EAST
B SEAM OUTCROP
B SEAM SPLITTING OUT
B SEAM OUTCROP CUT
B SEAM SPLITTING CUT
4362
4363
4364