


J.M. CHASE EST.

DANIEL BARNETT EST.

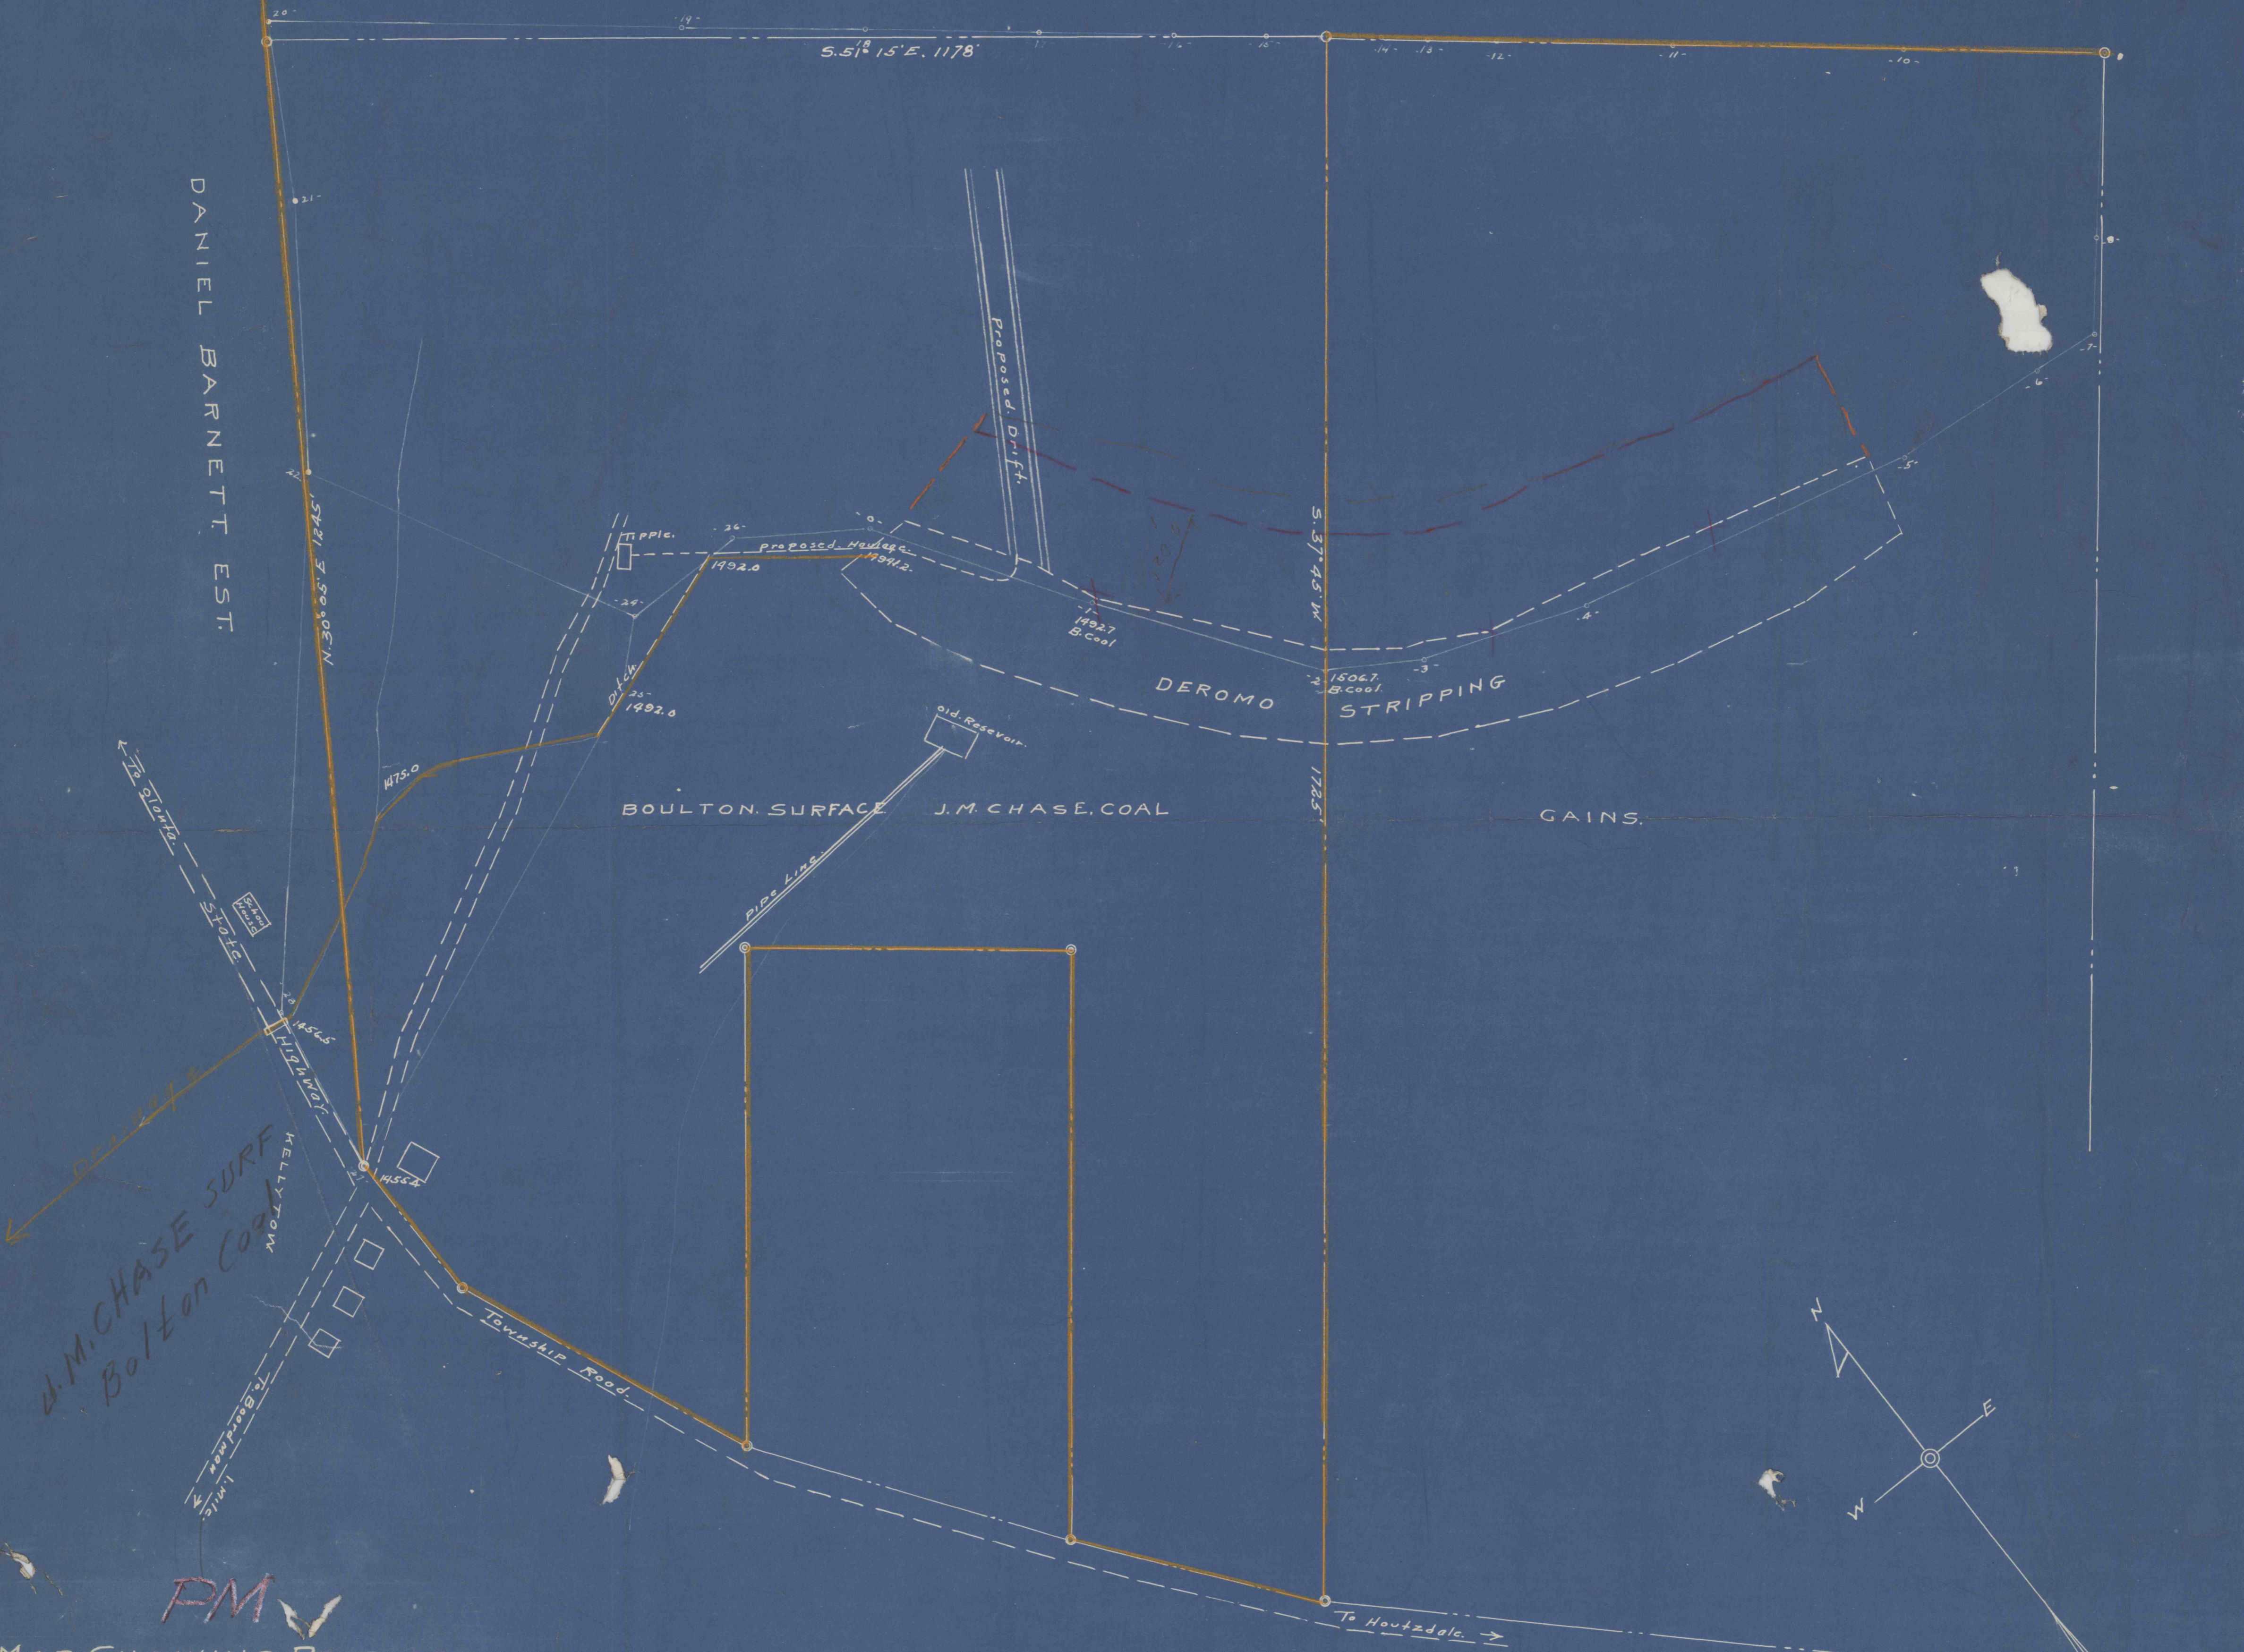

J.M. CHASE SURF
Boulton Coal
 KELLYTON
 To Boardman
 1 MILE

PM
 MAP SHOWING PROPOSED
 COAL MINE OF
 JOHN EARNEST AND SON
 SITUATED KNOX TWP. CLFD. CO.
 LEASED FROM J.M. CHASE EST.
 SCALE 1" = 100'

OCT-8-1947 Grier Bell Engr.

CD. 602

4663