


CLEARFIELD CLAY WORKING COMPANY
 MAP OF
 SOFT CLAY MINES,
 AT THE
 REED FARM,
 CLEARFIELD PENNA.
 SCALE 1"=100'
 CURWENSVILLE, PA. JAN. 16-1918.

SURVEYED JAN. 2-9-1918
 MAY 9-1918
 AUG. 16-1918
 JAN. 3-1919
 JUNE 3-1919
 OCT. 16-1919
 DEC. 19-1919
 NOV. 22-1920
 MARCH 20, 1922

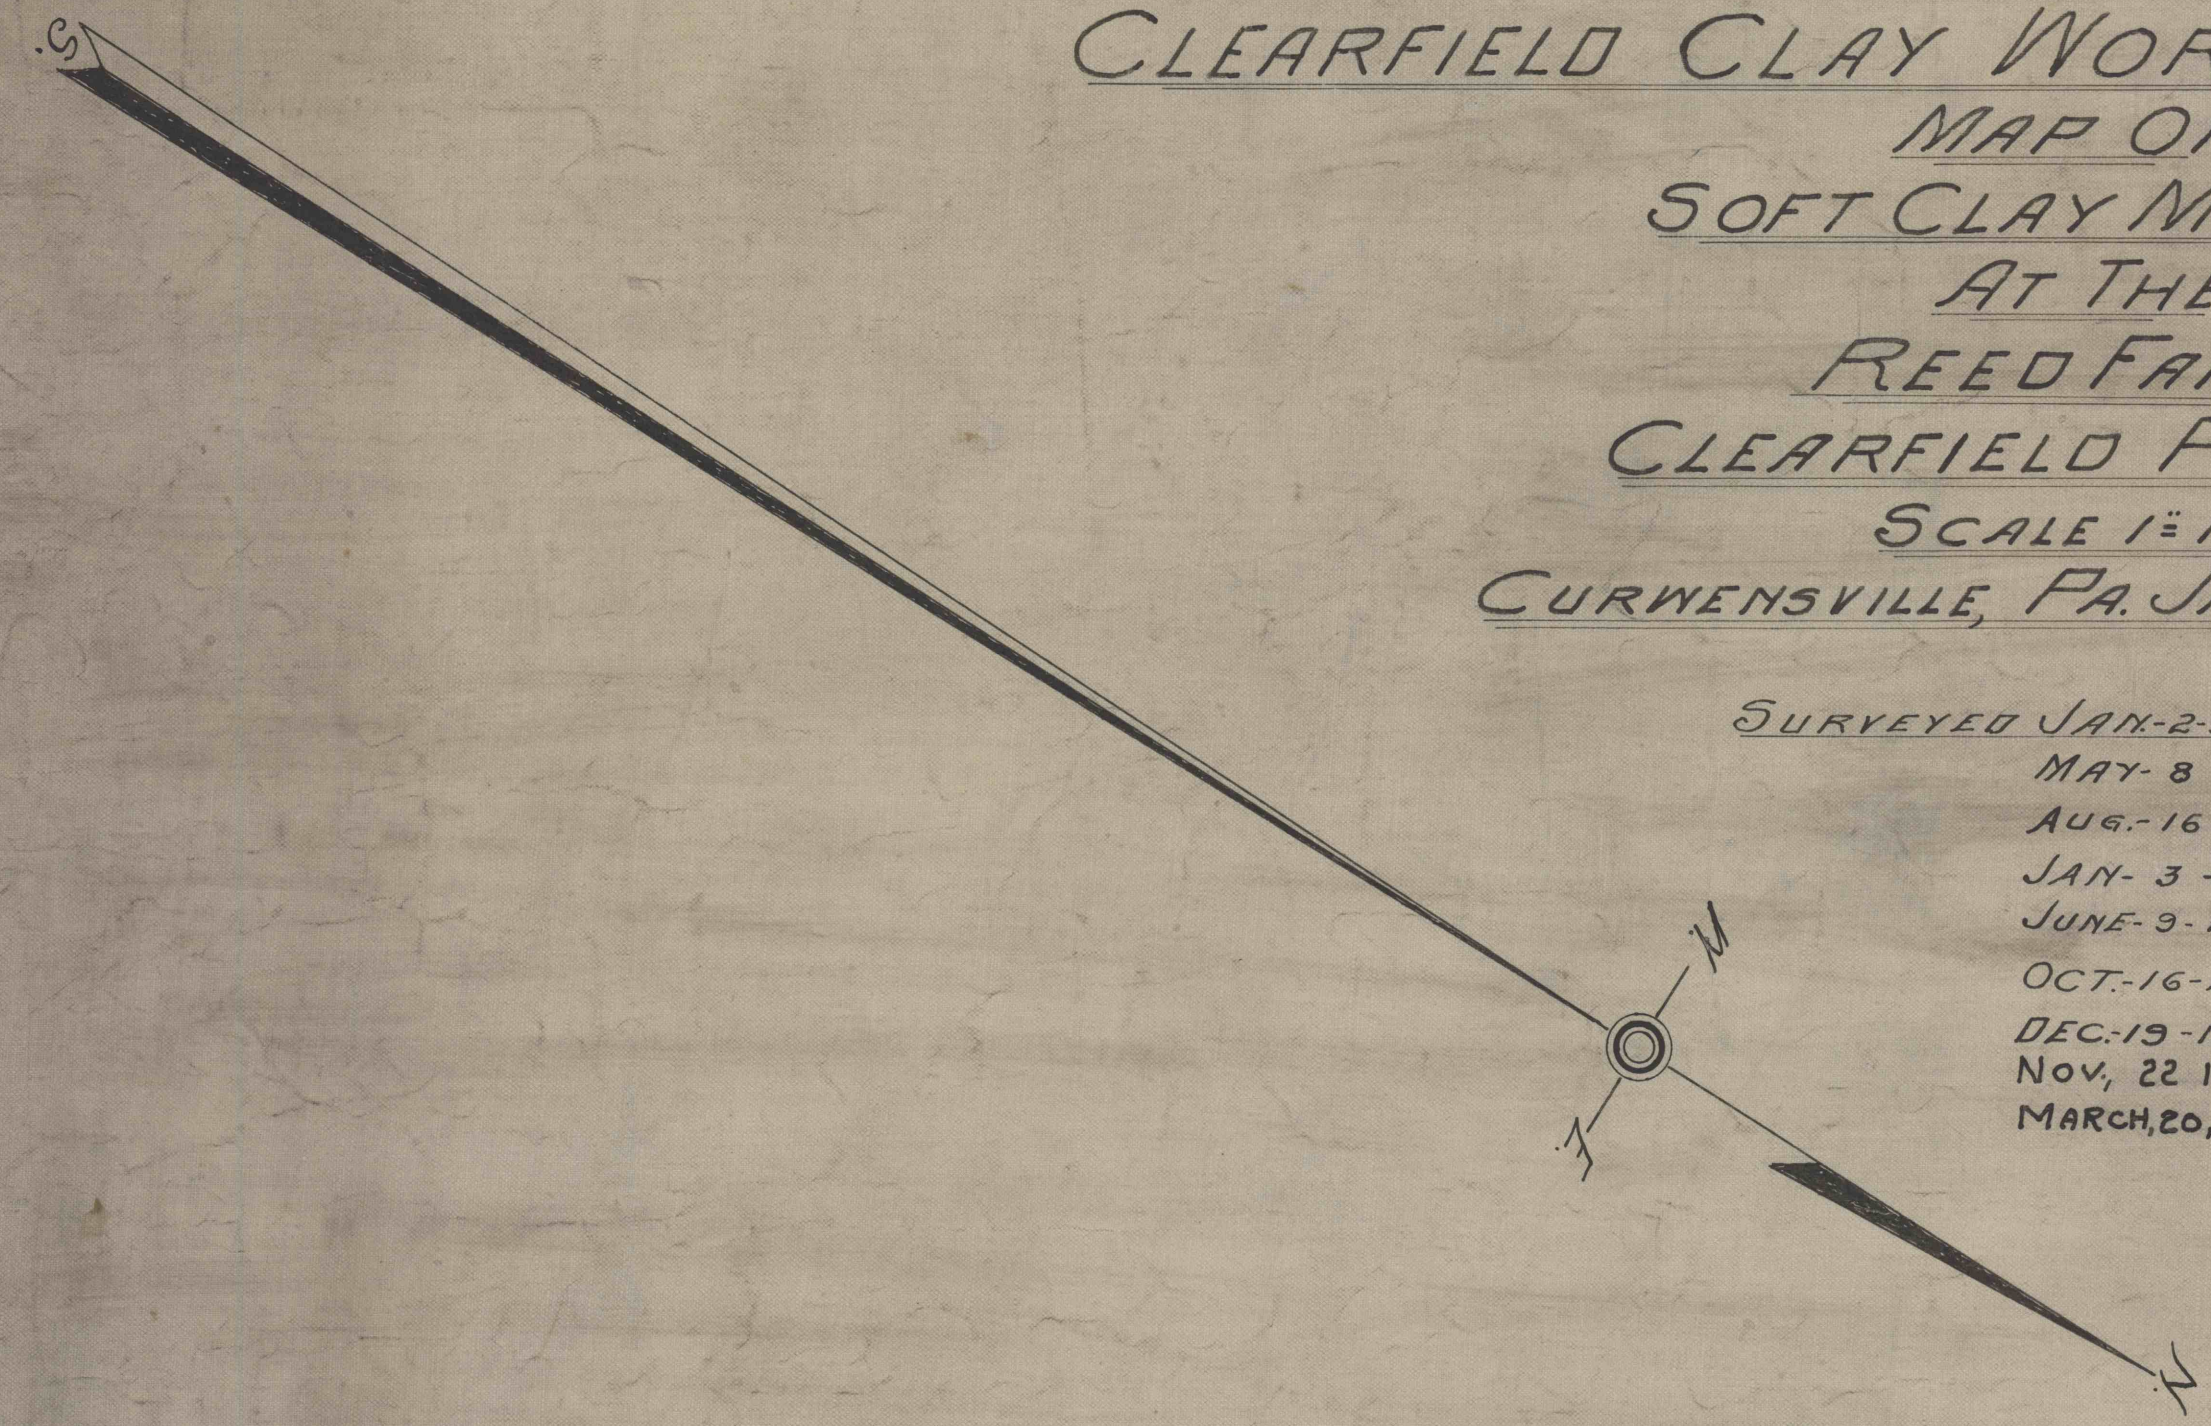

CLEARFIELD BRICK MFG. CO.

JAMES MITCHELL

R. MITCHELL EST.

Headings 40' to 10' wide
 Rooms 30' to 14' wide 150' long
 30' Barrier Ribs for All Headings

INDEX No.
 47-2-2

