






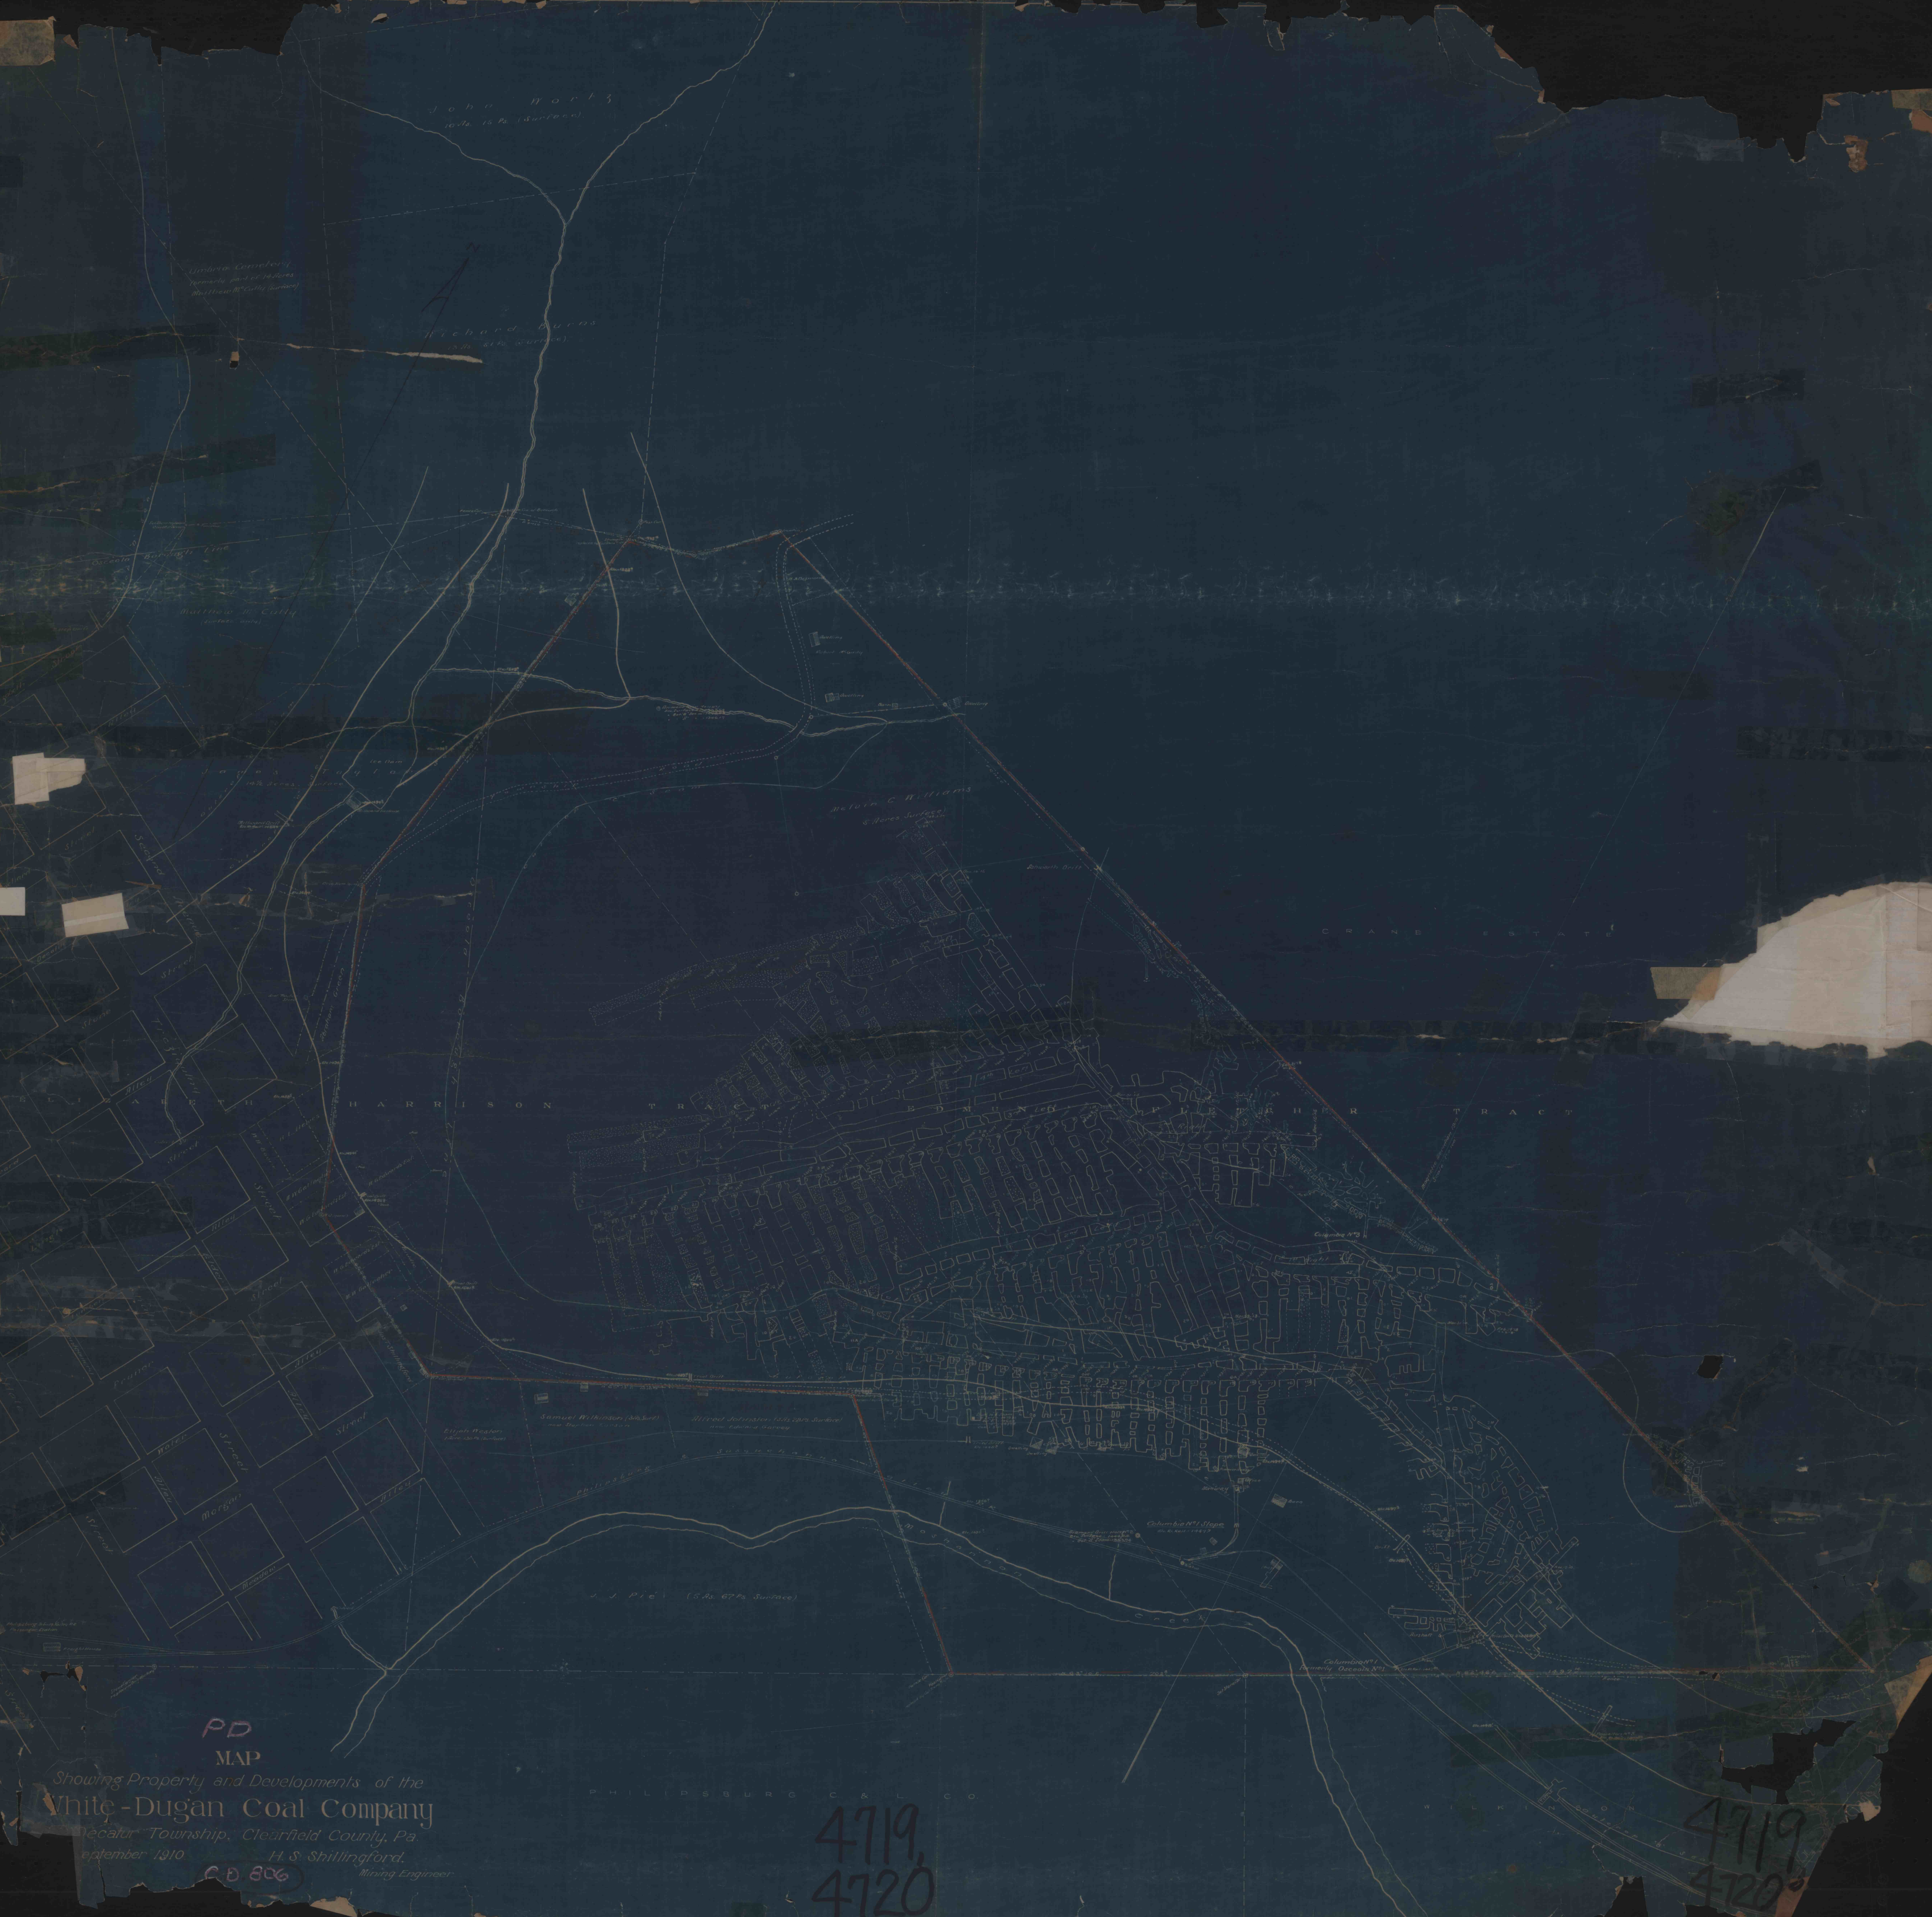

PD  
MAP

Showing Property and Developments of the  
White-Dugan Coal Company  
September 1910  
H. S. Shillingford,  
Mining Engineer.

C. D. 806

4719  
4720

4719  
4720