


CRAIN HEIRS

Foot of Sheep Branch

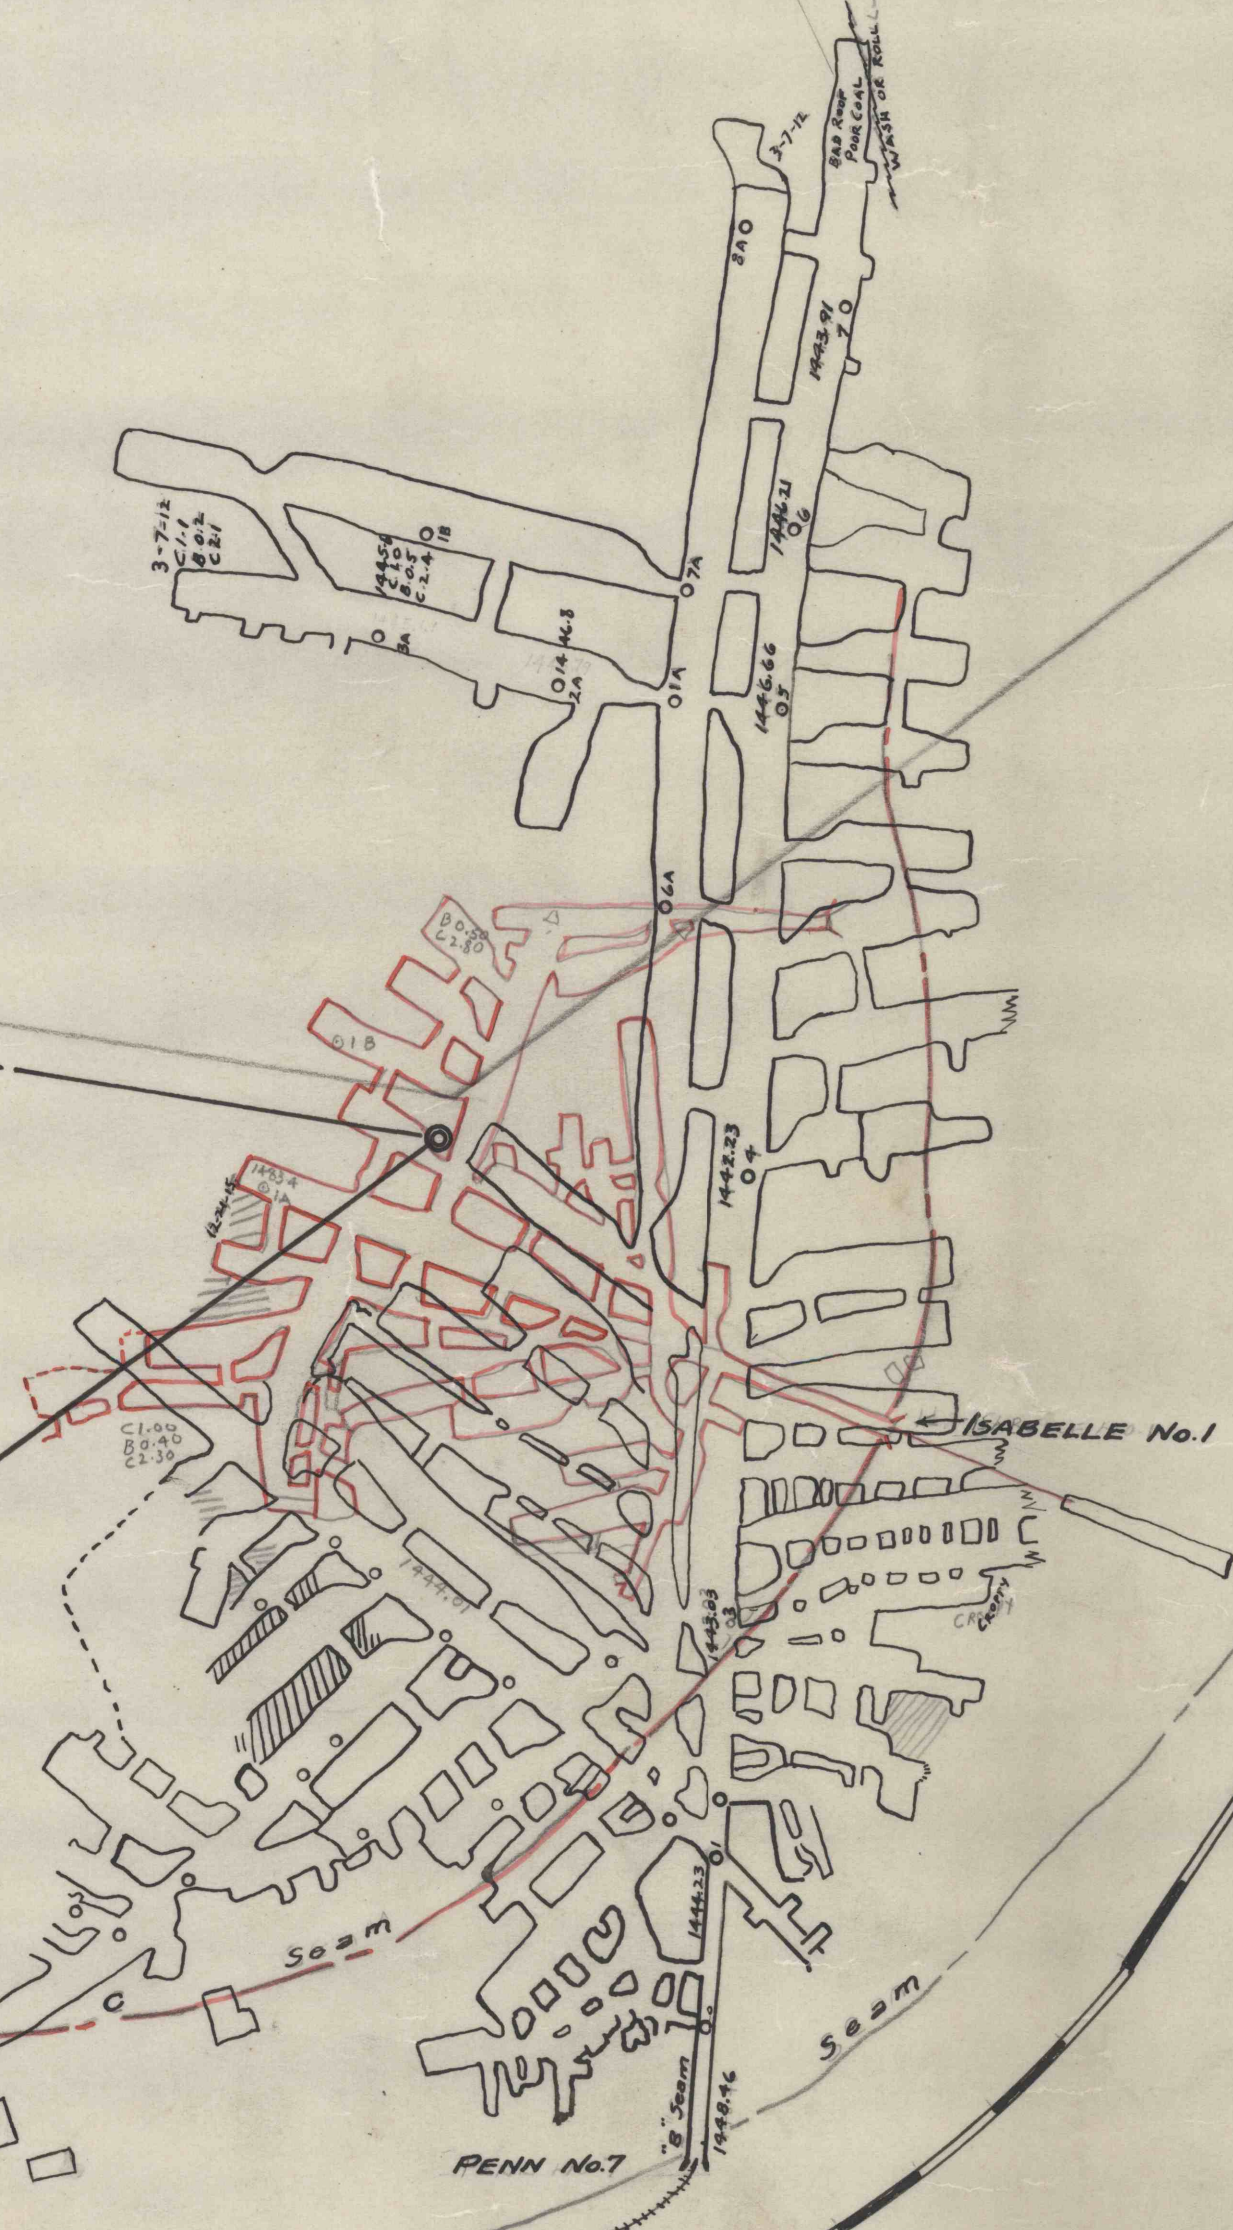

Line

Creek

WILKINSON

D

MAP SHOWING PENN No. 7 & ISABELLE No. 1 MINES
NEAR
OSCEOLA MILLS, CLEARFIELD COUNTY PENNA.

Scale 1" = 100'

January 1909

C.D.

& L. Co.

D
D
SAGA

4742