


C.D.

4746
4747

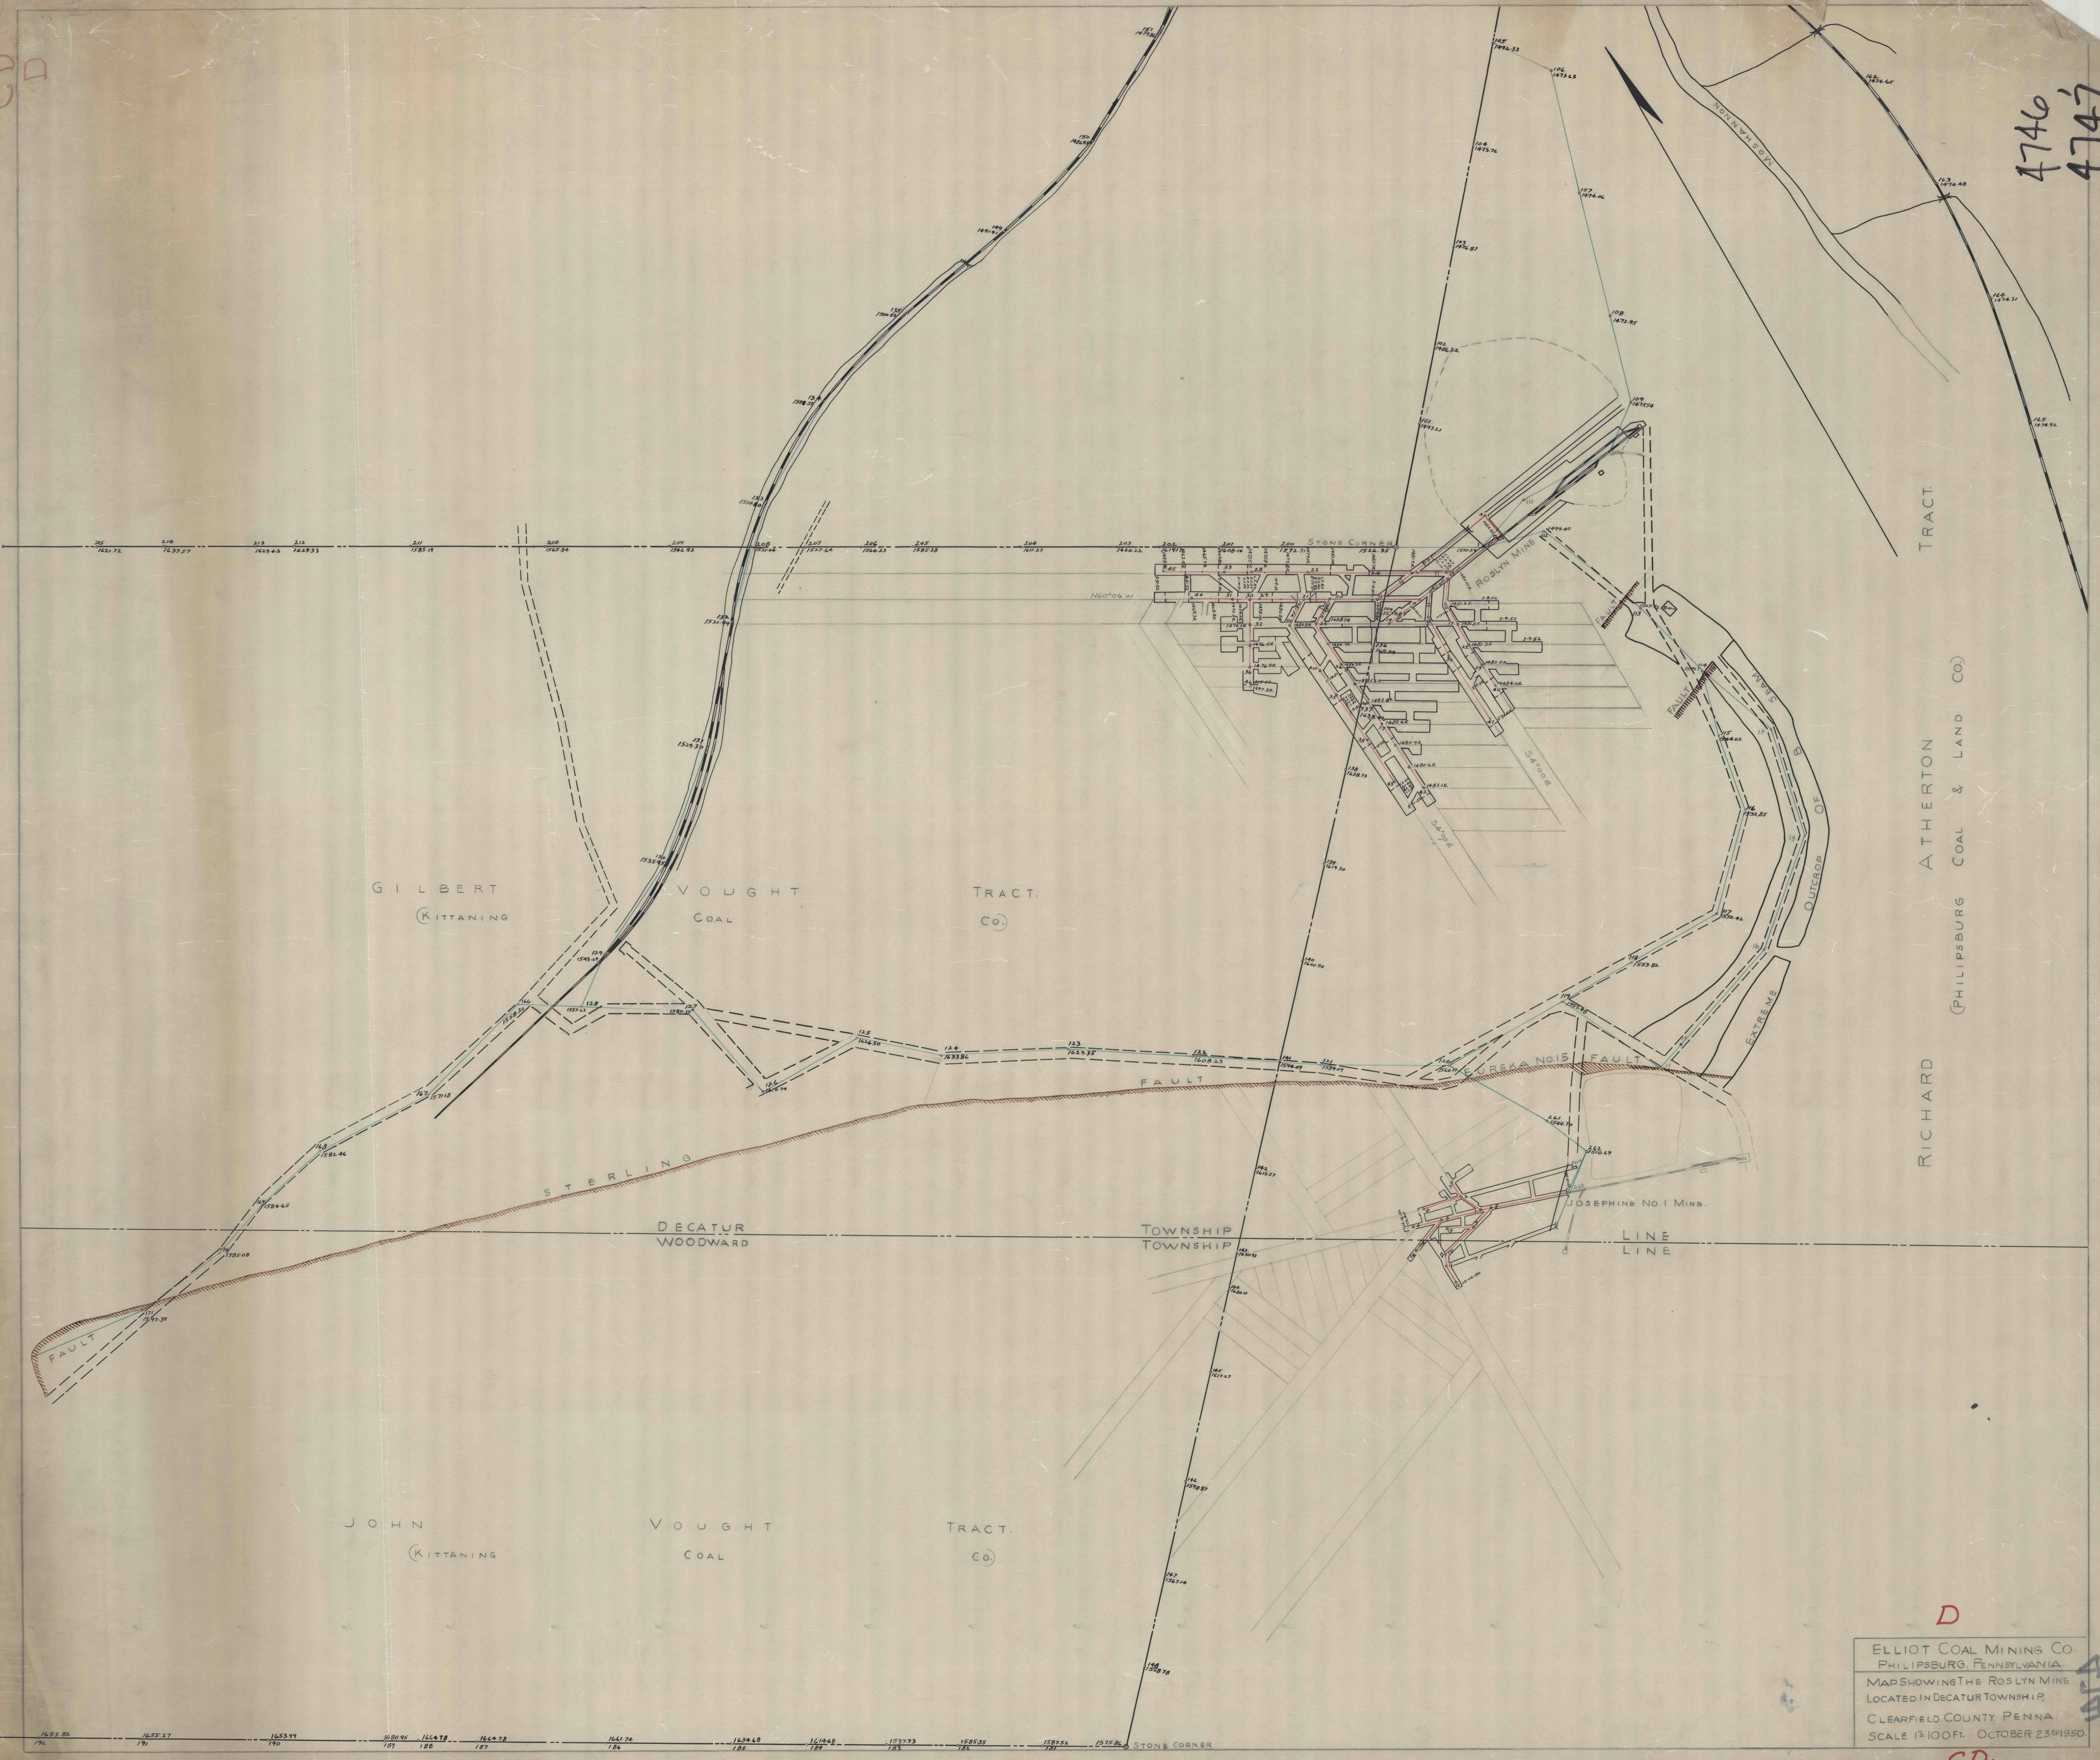

ELLIOT COAL MINING CO.
 PHILIPSBURG, PENNSYLVANIA.
 MAP SHOWING THE ROSLYN MINE
 LOCATED IN DECATUR TOWNSHIP,
 CLEARFIELD COUNTY, PENNA.
 SCALE 1"=100 FT. OCTOBER 25th 1950.

D

C.D.