


C.D.

4769

CHRISTIAN HUBER TRACT.

DANIEL WITMER TRACT.

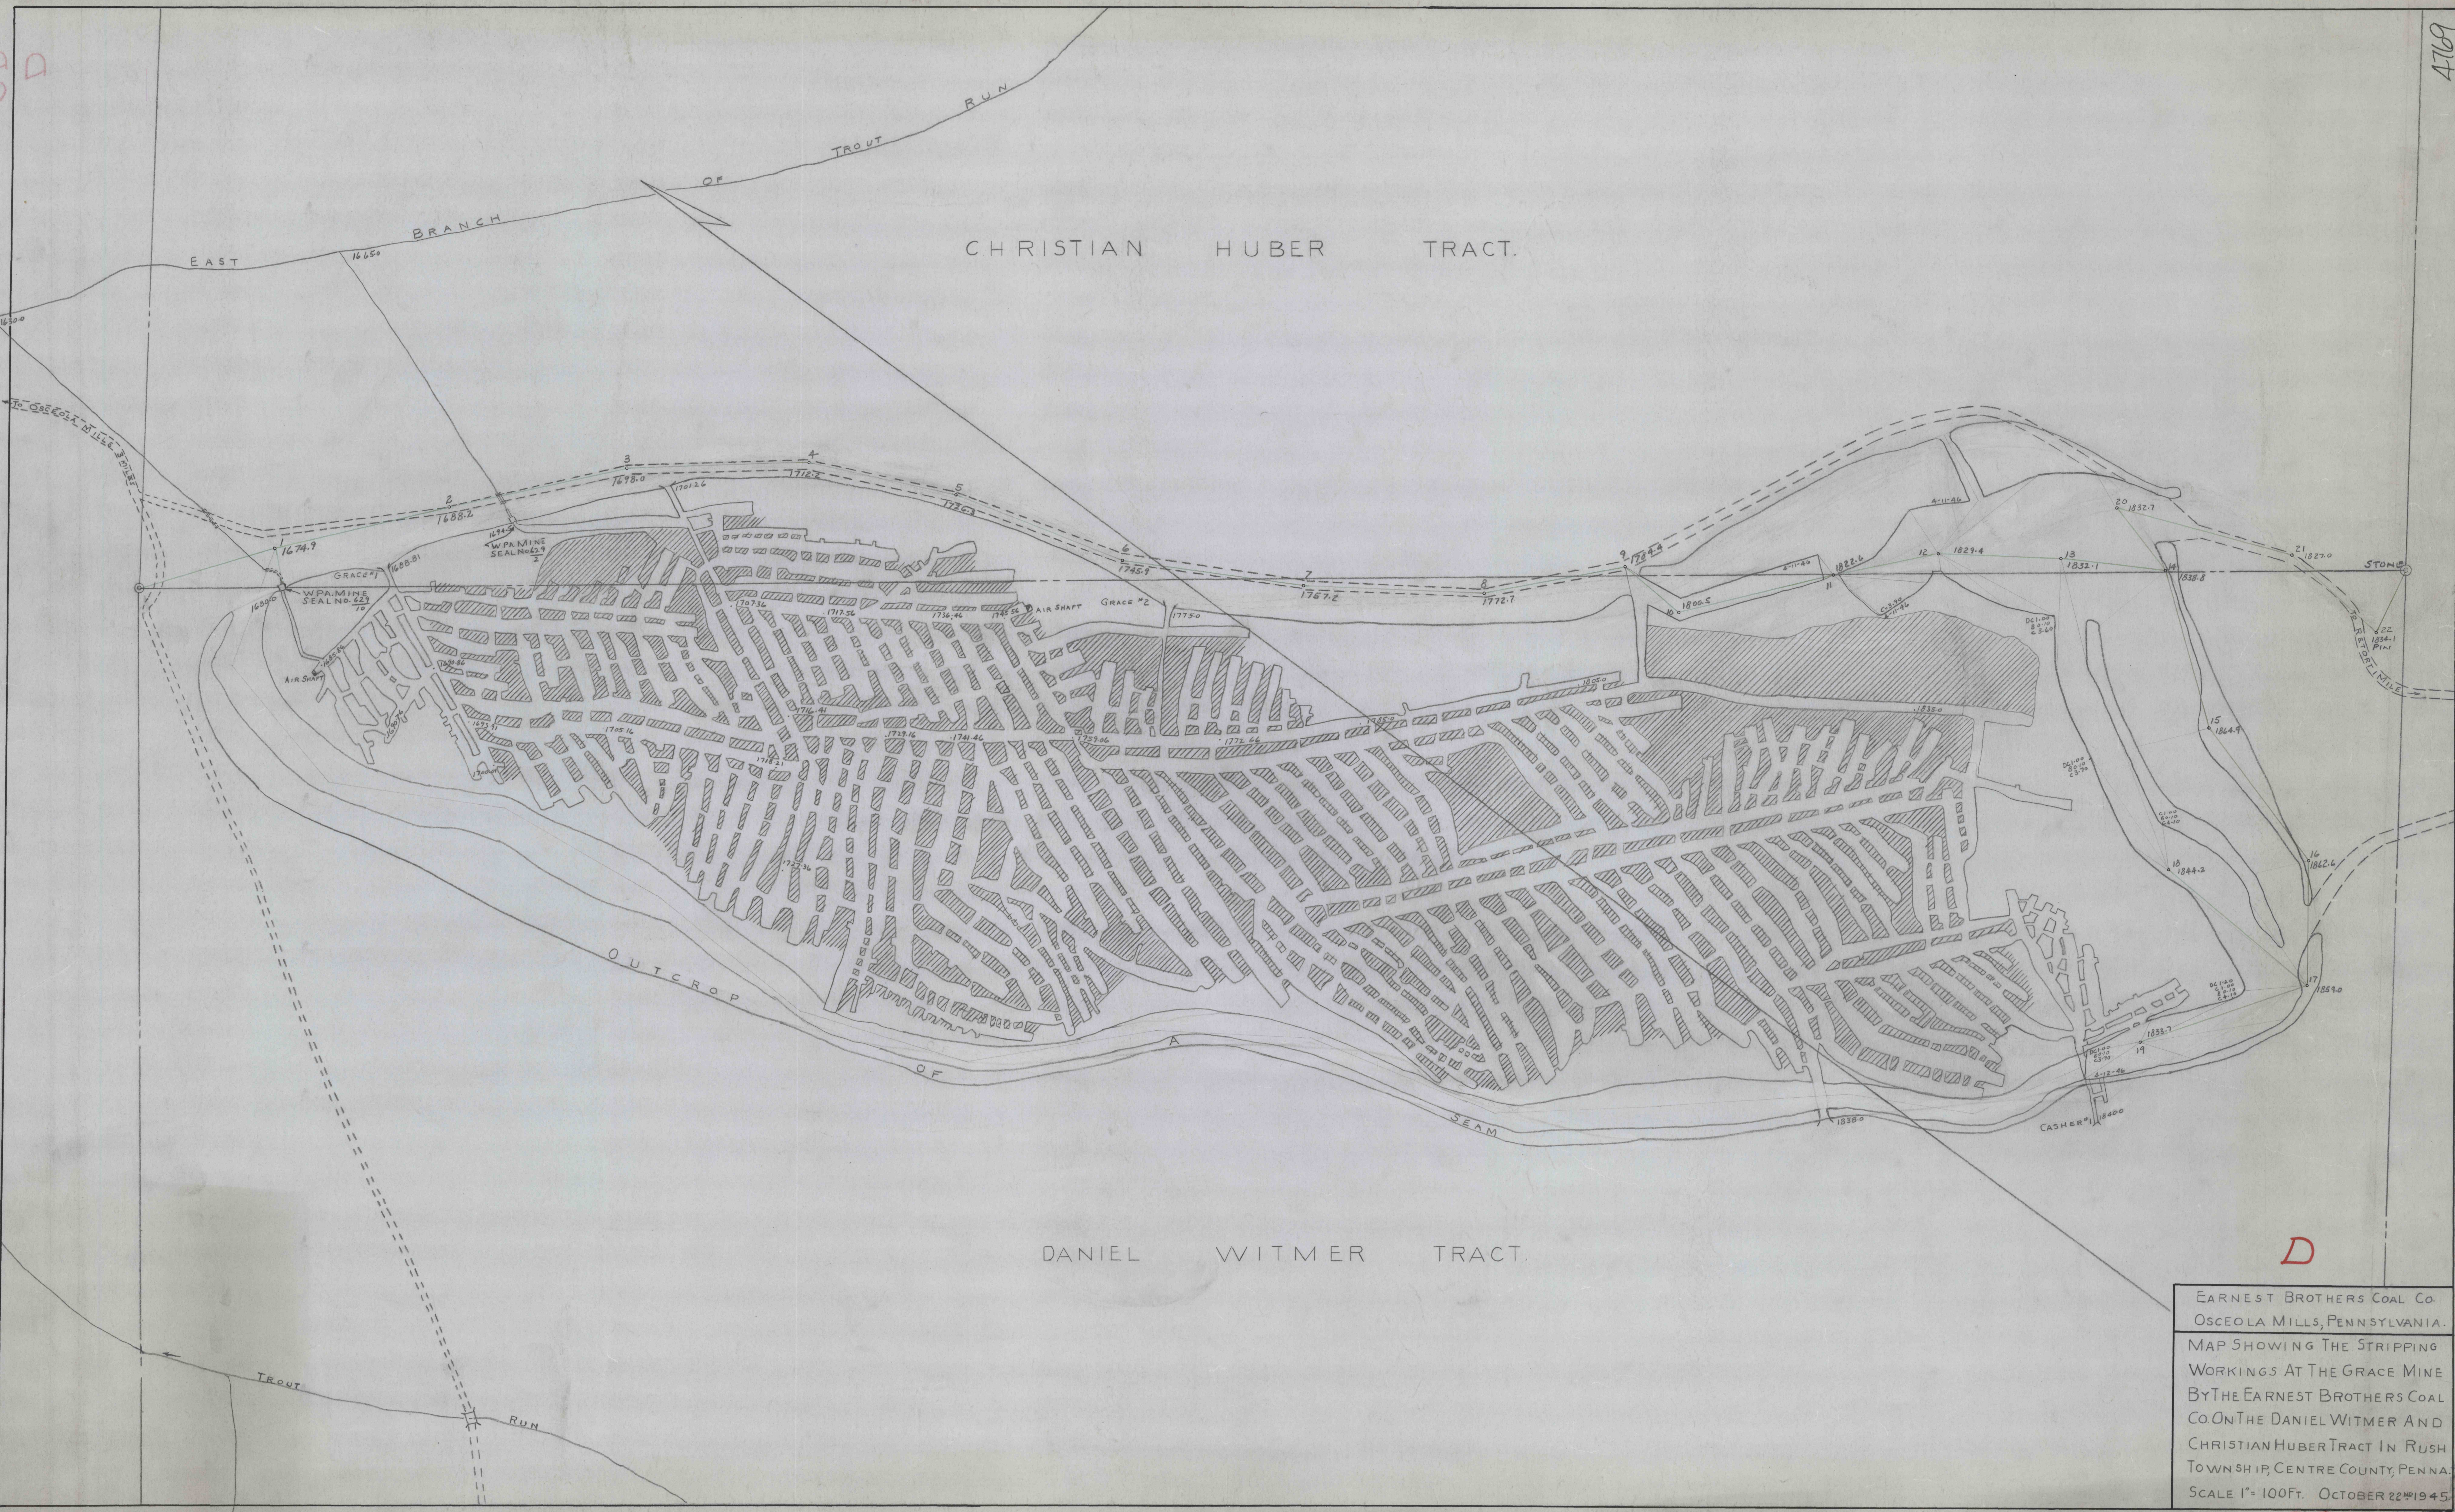

EARNEST BROTHERS COAL CO.
 OSCEOLA MILLS, PENNSYLVANIA.
 MAP SHOWING THE STRIPPING
 WORKINGS AT THE GRACE MINE
 BY THE EARNEST BROTHERS COAL
 CO. ON THE DANIEL WITMER AND
 CHRISTIAN HUBER TRACT IN RUSH
 TOWNSHIP, CENTRE COUNTY, PENNA.
 SCALE 1" = 100 FT. OCTOBER 22ND 1945

D

C.D.