


CD

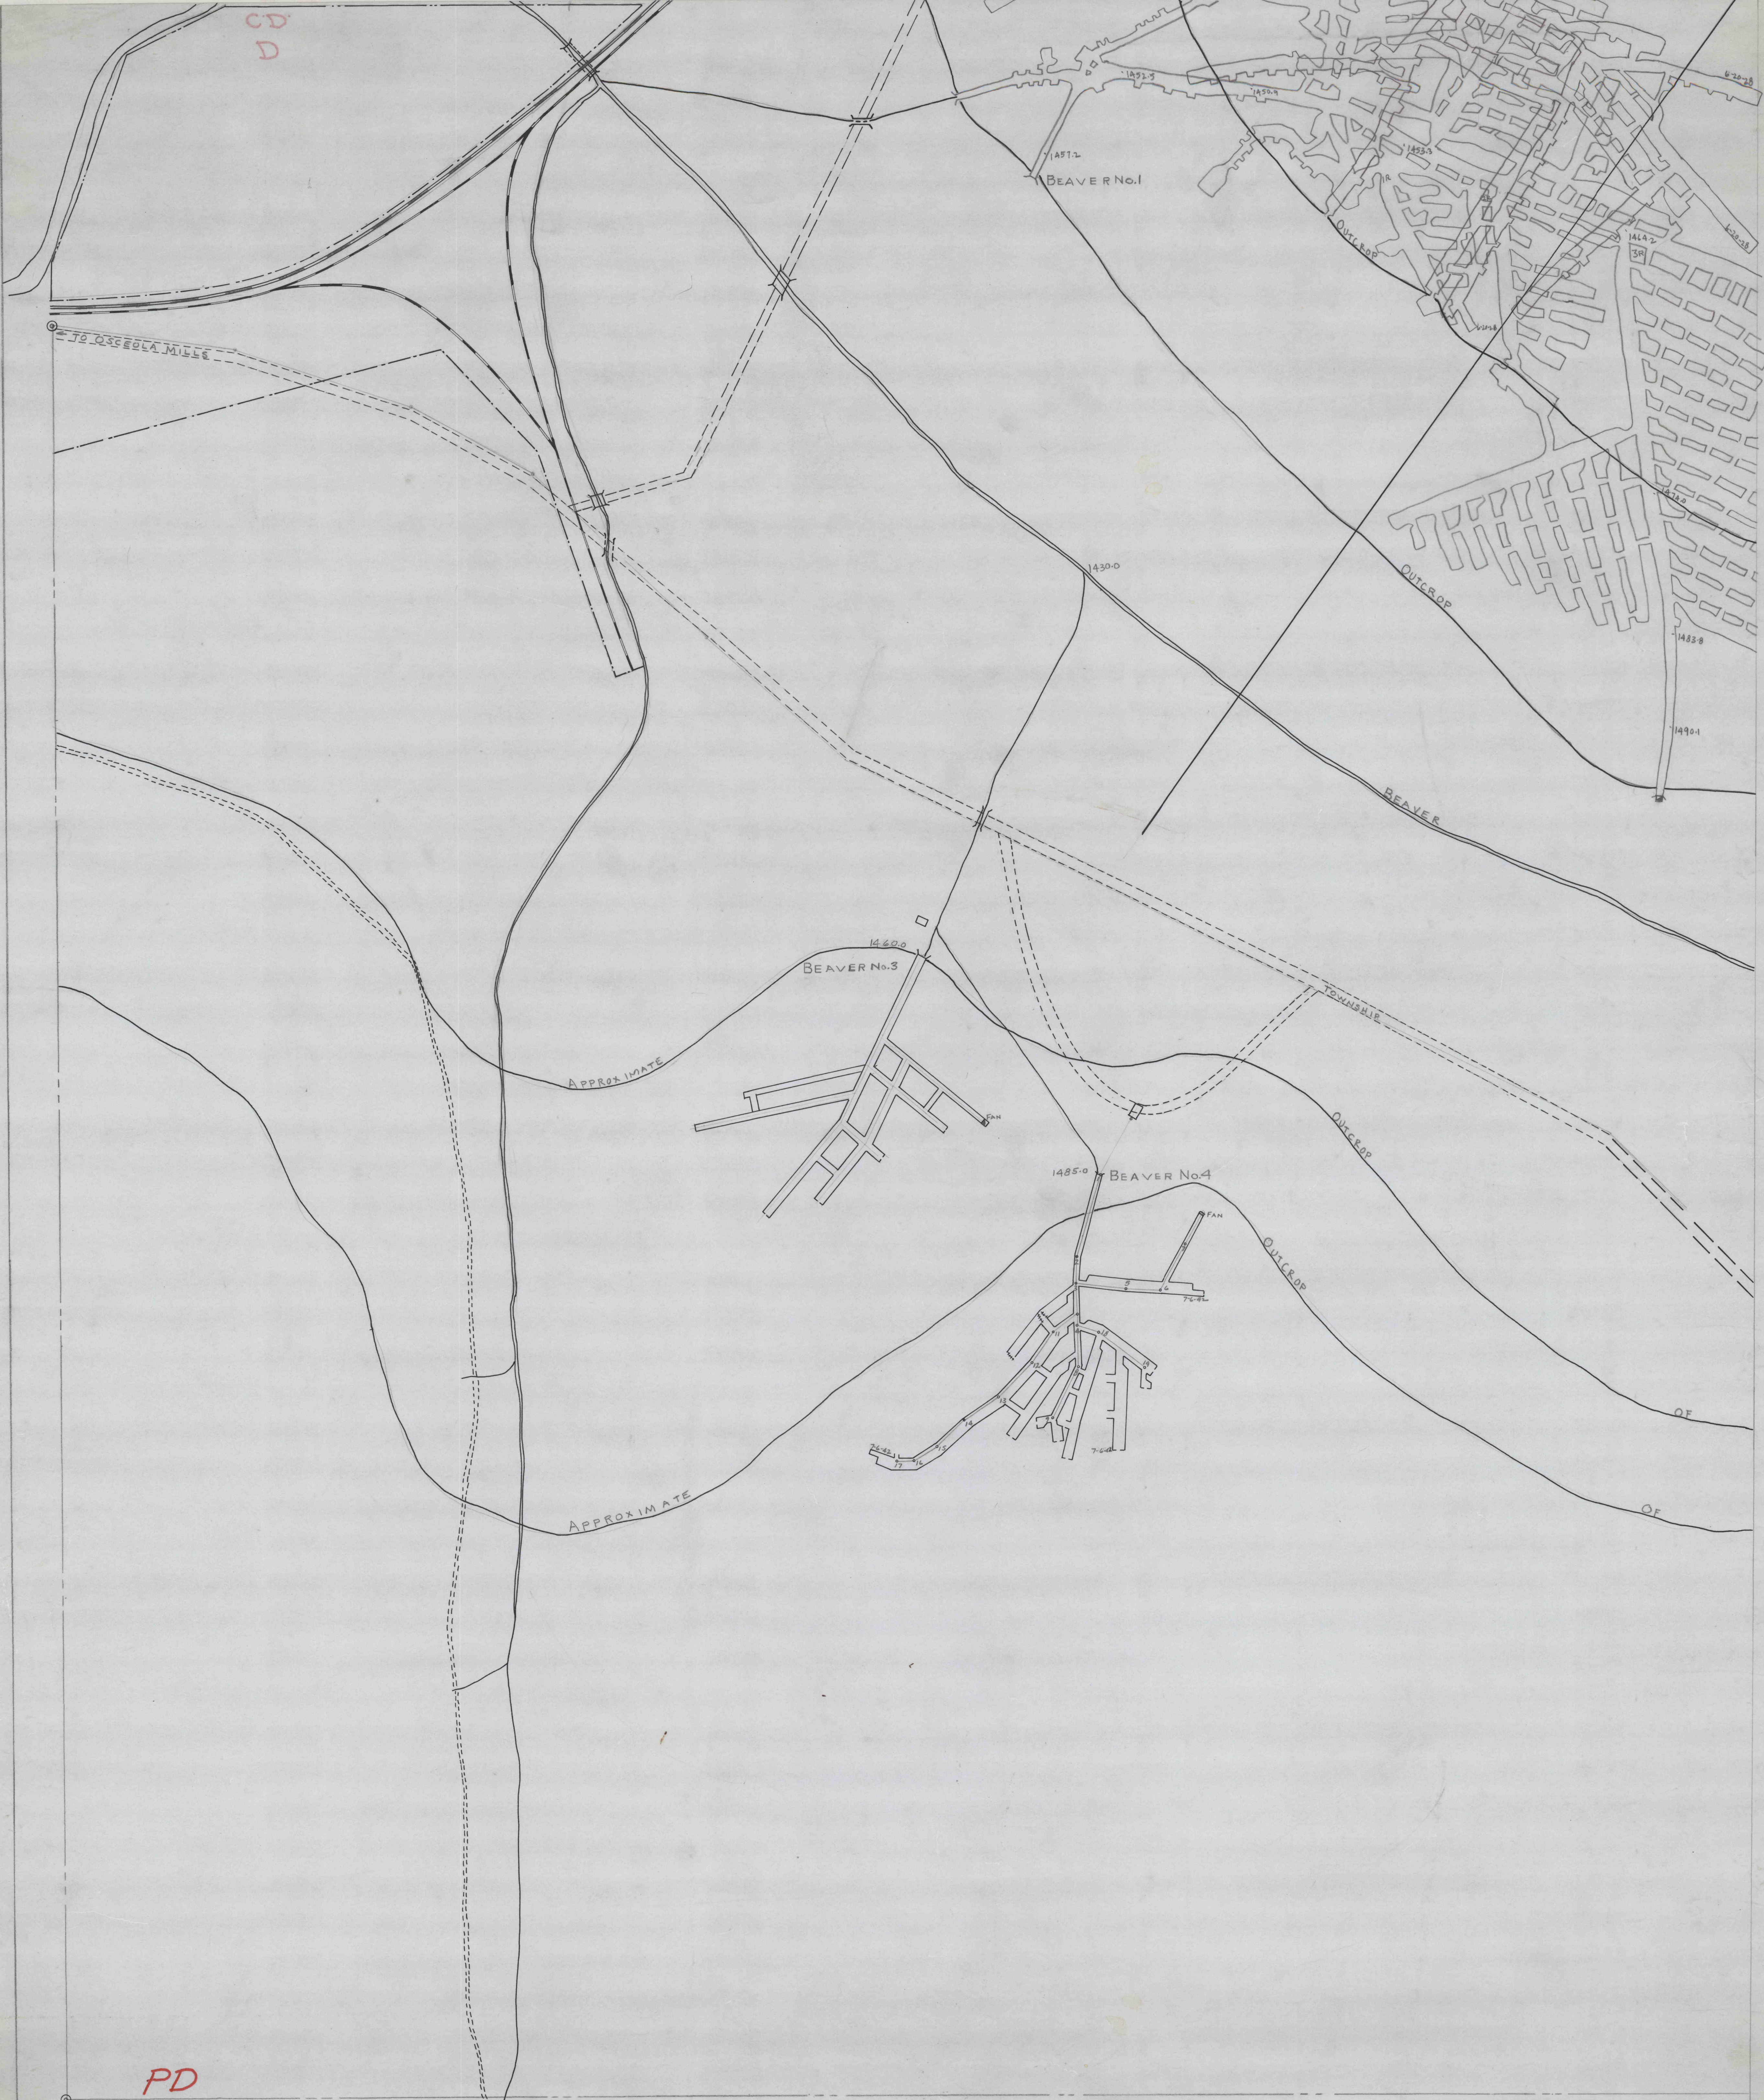

PD

HILLSIDE COAL COMPANY.  
 PHILIPSBURG, PENNSYLVANIA.  
 MAP SHOWING AREA OF B & C  
 COAL UNDER LEASE BY HILLSIDE  
 COAL CO. ON THE BEAVER ESTATE IN RUSH  
 TOWNSHIP CENTRE COUNTY PENNA.  
 SCALE 1" = 100 FEET. JUNE 15-1945.

8177 C.D.

4778