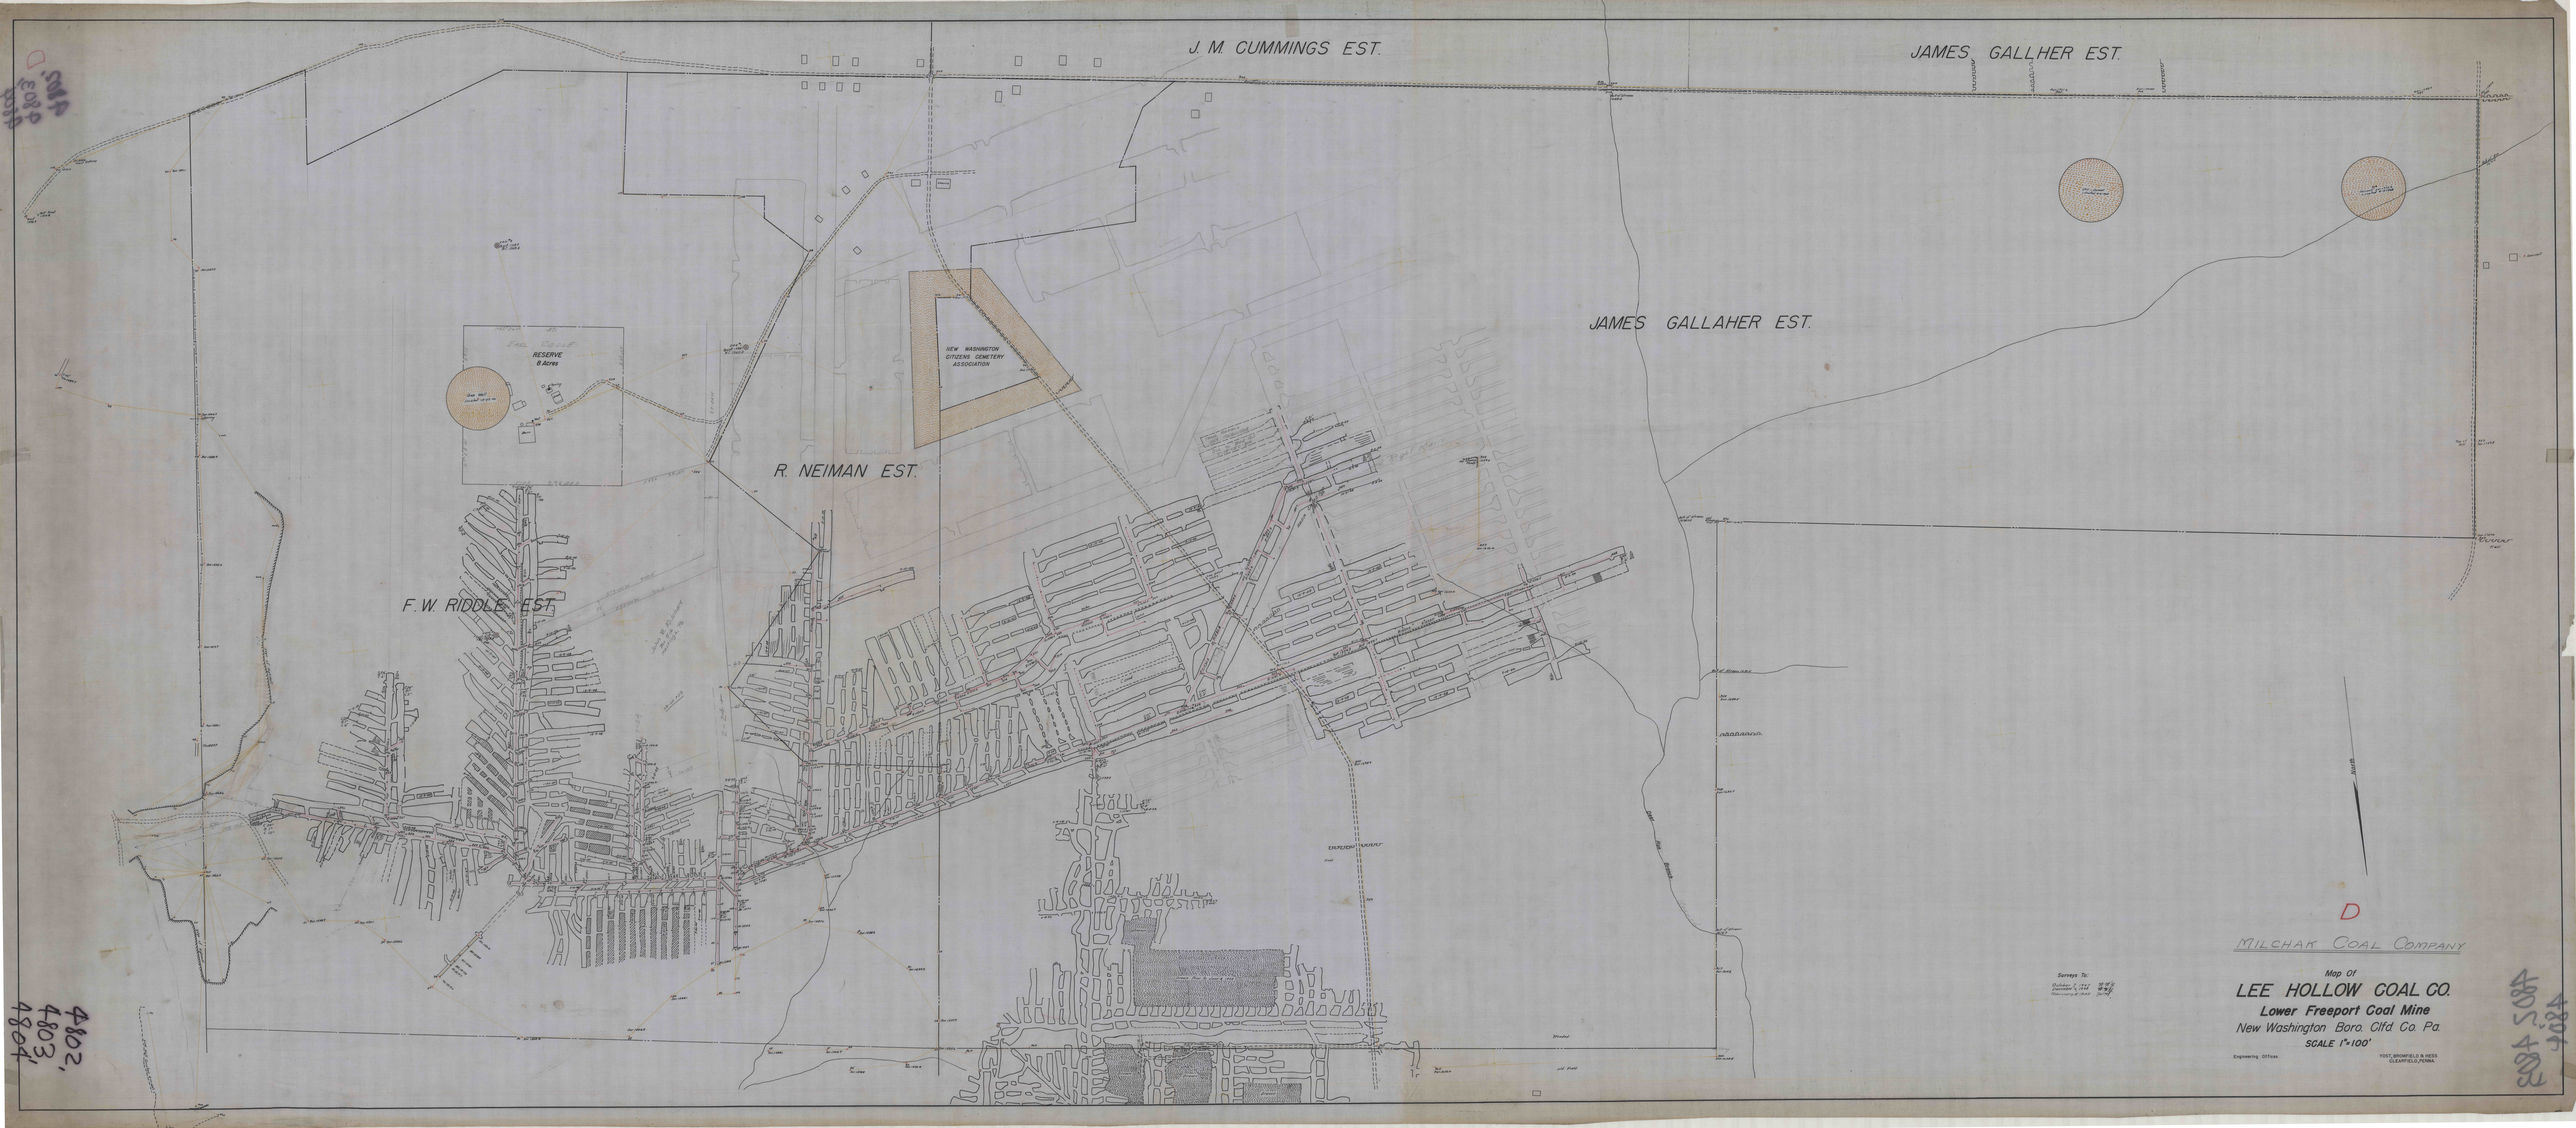
J. M. CUMMINGS EST.
JAMES GALLHER EST.
JAMES GALLAHER EST.
R. NEIMAN EST.
F. W. RIDDLE EST.
RESERVE
6 Acres
NEW WASHINGTON
CITIZENS CEMETERY
ASSOCIATION
D
MILCHAR COAL COMPANY
Map Of
LEE HOLLOW COAL CO.
Lower Freeport Coal Mine
New Washington Boro. Clfd Co. Pa.
SCALE 1"=100'
Engineering Offices
YOST, BROMFIELD & HESS
CLEARFIELD, PENNA.