


1004
4808

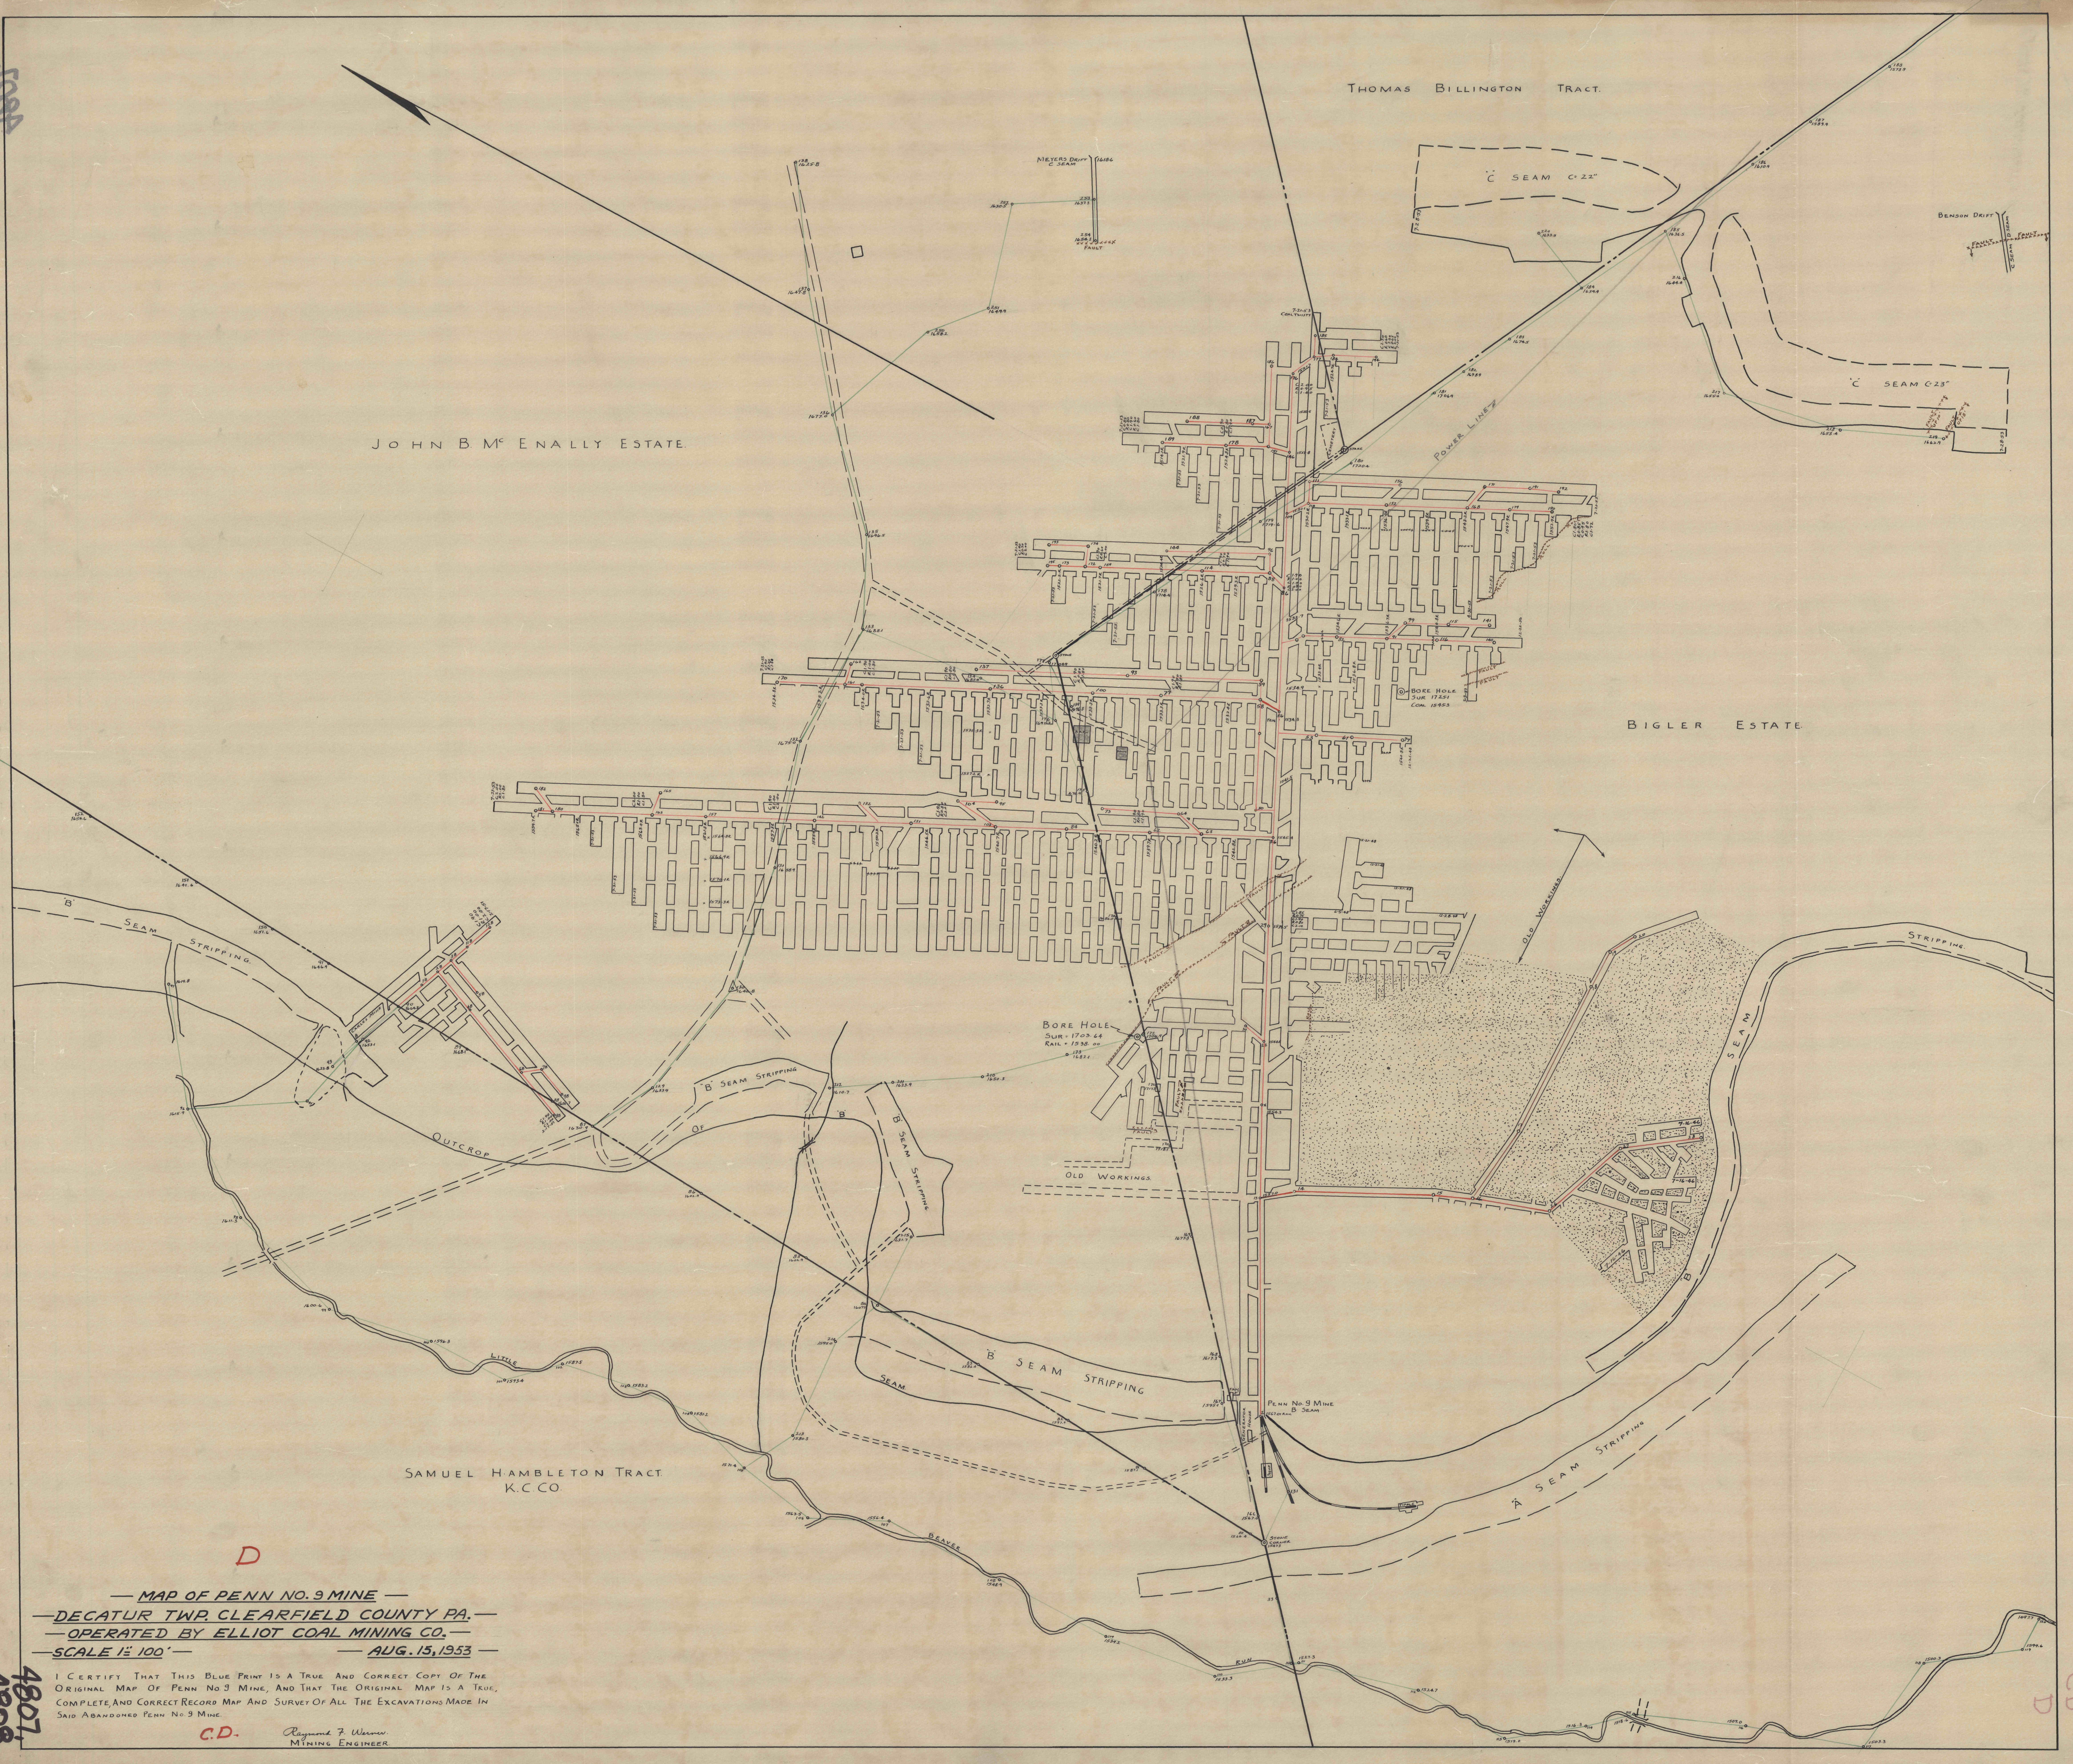

JOHN B Mc ENALLY ESTATE

THOMAS BILLINGTON TRACT

BIGLER ESTATE

SAMUEL HAMBLETON TRACT
K.C.CO.

D

— MAP OF PENN NO. 9 MINE —
 — DECATUR TWP. CLEARFIELD COUNTY PA. —
 — OPERATED BY ELLIOT COAL MINING CO. —

I CERTIFY THAT THIS BLUE PRINT IS A TRUE AND CORRECT COPY OF THE ORIGINAL MAP OF PENN NO. 9 MINE, AND THAT THE ORIGINAL MAP IS A TRUE, COMPLETE AND CORRECT RECORD MAP AND SURVEY OF ALL THE EXCAVATIONS MADE IN SAID ABANDONED PENN NO. 9 MINE.

C.D. Raymond F. Warner
 MINING ENGINEER

4807
4808

CD
D