

PD

CLEARFIELD SEWER PIPE COMPANY
 Gen. E. PAUNDLER

MAP OF THE
 "STANLEY MINE"

GULICH TWP., CLEARFIELD CO., PA.


SCALE 1" = 100'

CLEARFIELD, PA. OFFICE OF E.W. HESS
 FEB. 15, 1918. ENGINEER.

ADIA

RE SURVEYS:-

4840
 COMPILED FROM MINE SURVEY
 OF APRIL 20-21-1917
 AND DEED DESCRIPTIONS

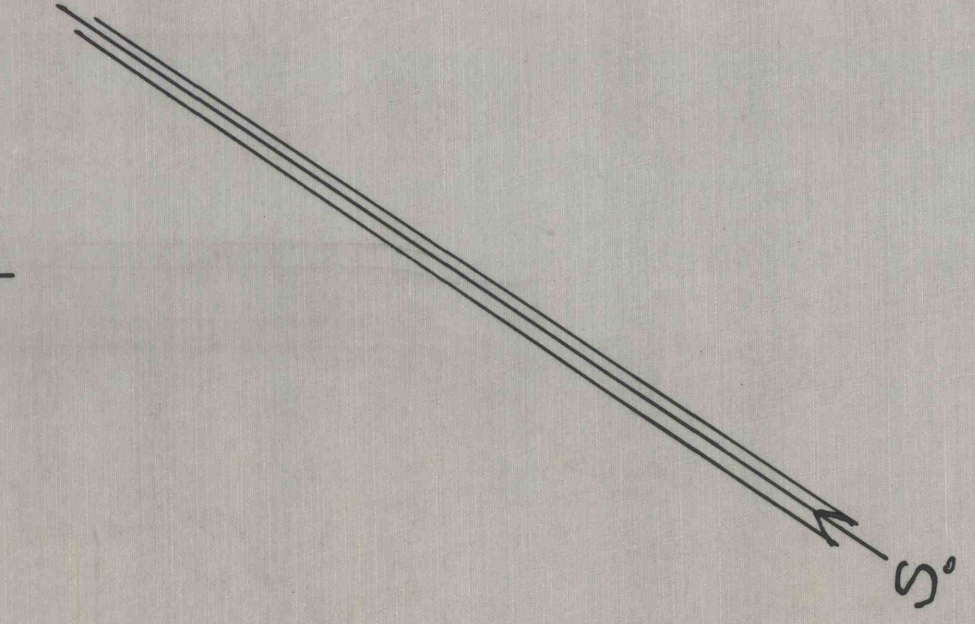

WITNESSED BY BEATRICE SCHAEFER
 PUBLICLY
 DAVID J. STEPHENS

DAVID J. STEPHENS.
 AREA 26 ± Acs
 RESERVE 5
 21 Acs

WITNESSED BY BEATRICE SCHAEFER
 PUBLICLY
 DAVID J. STEPHENS

DAVID STEPHENS
 BY DAVID J. STEPHENS.