

0884



REUBEN HAGGERTY.

BEYER & KIRK.

BEYER & KIRK.

1213.52
ELEVATION OF SUMP
MADERA MINE.

1236.19
MADERA MINE.

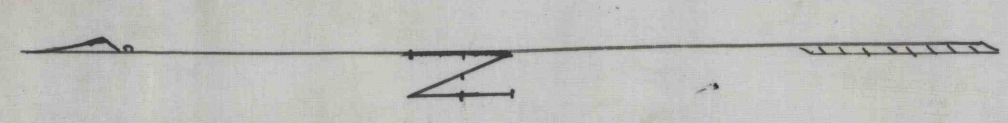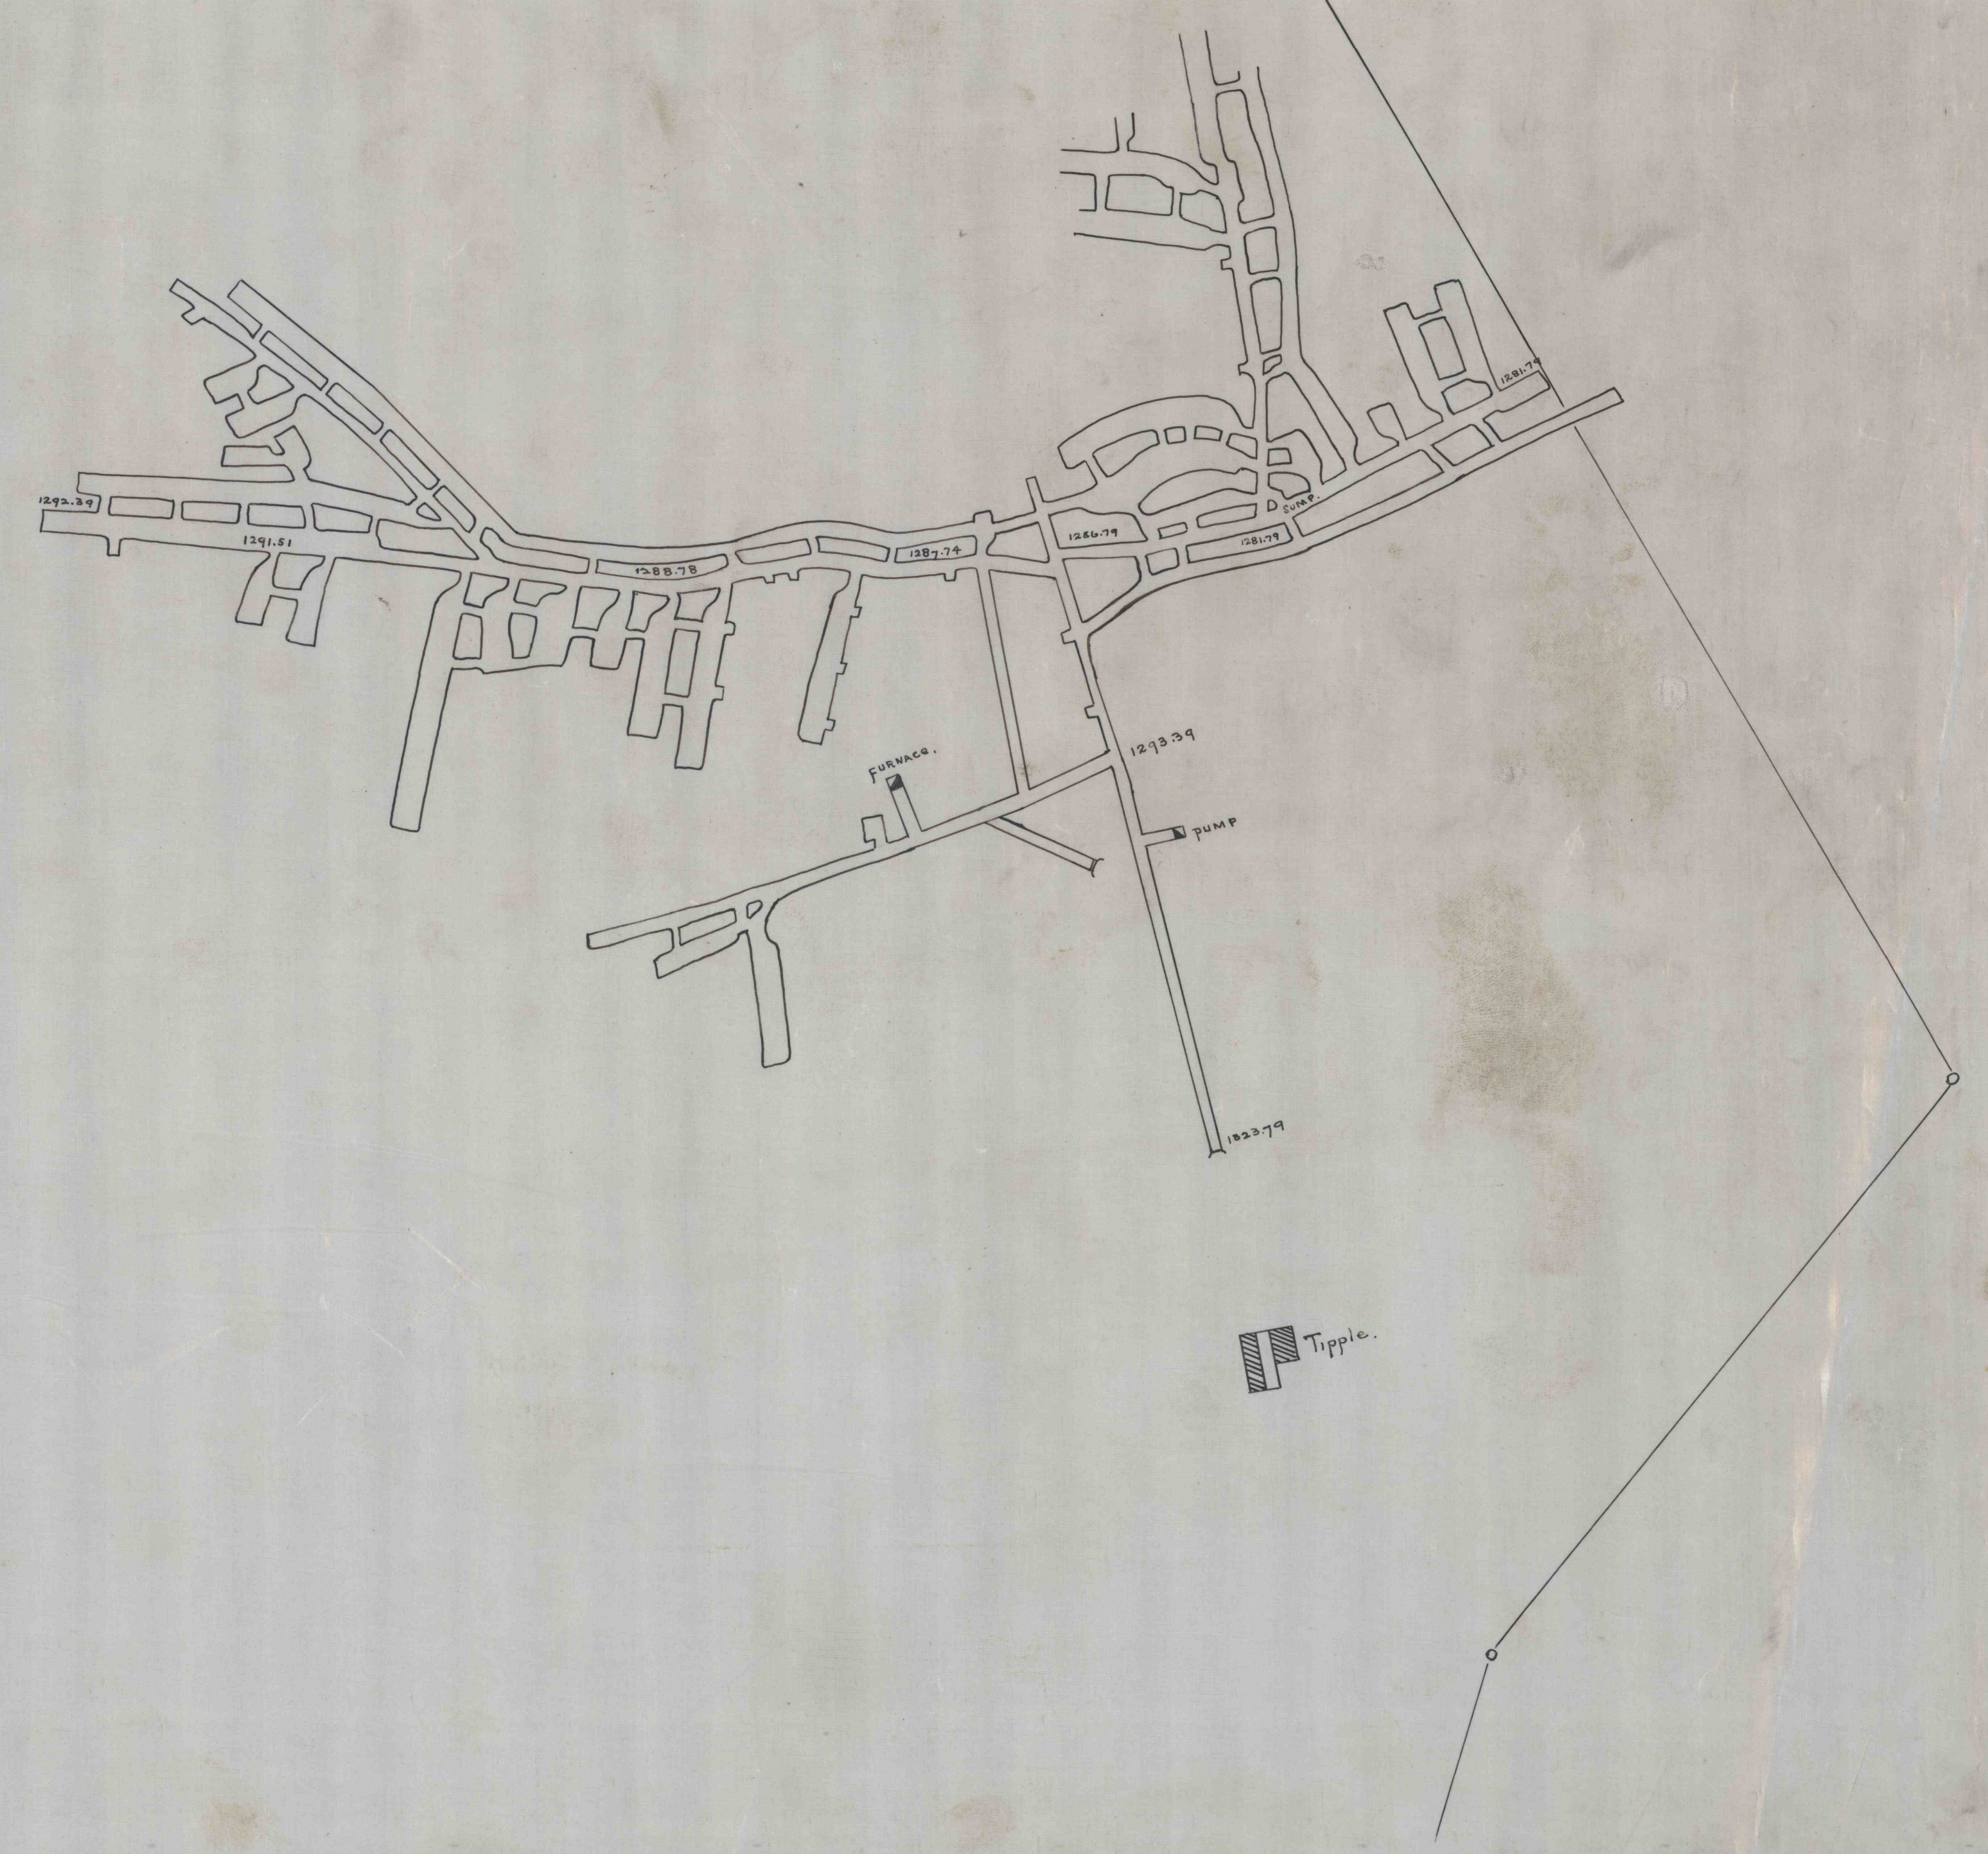

D

MAP
of

ROYAL MINES

OPERATED BY

ROYAL COAL MINING CO.

P. E. HONELSDORFF M. E. G. T. RUMBERGER. H. S. S. T.

Scale: 1 inch = 100 feet
REVISED TO APRIL 10th 1903.

B. VEIN.

4880

D