


T. H. FORCEY ESTATE

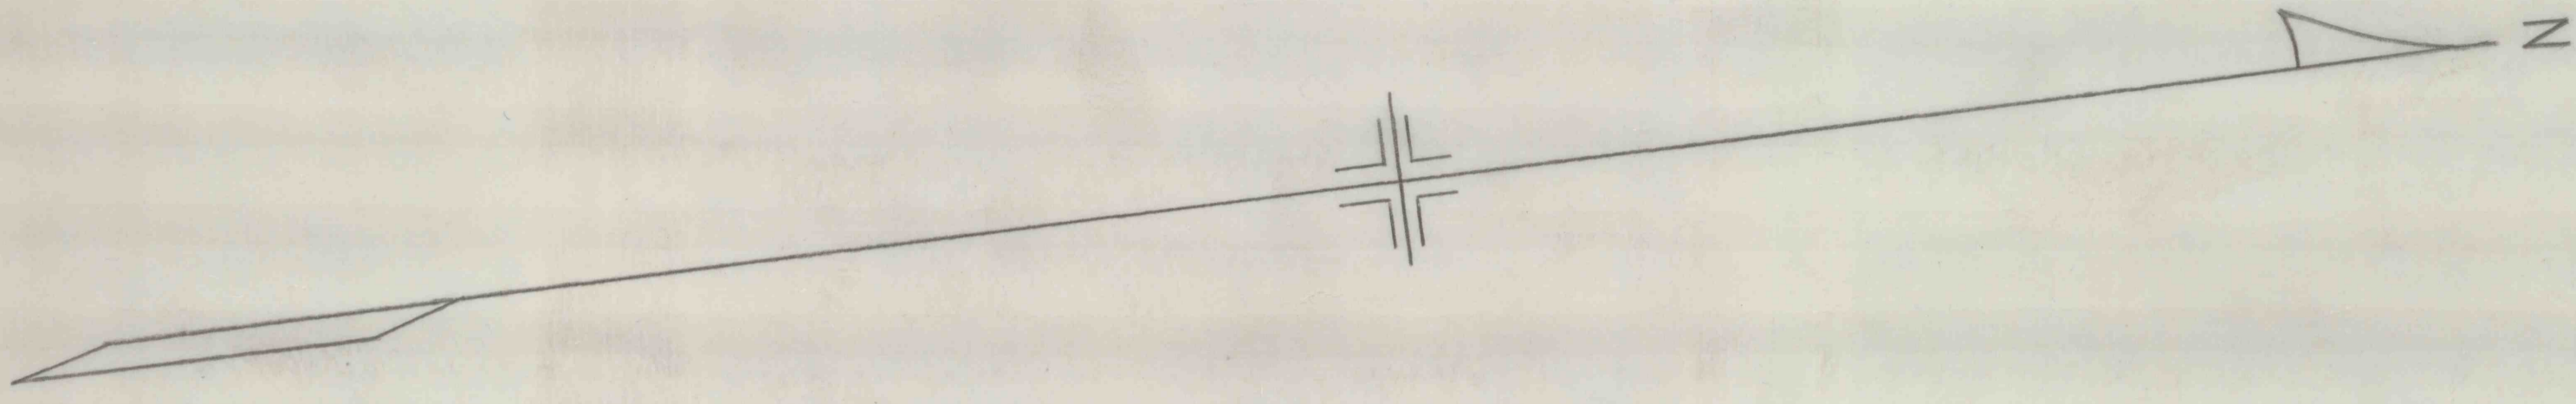

T. H. FORCEY ESTATE

T. G. FORCEY ESTATE


ISREAH HOOVER ESTATE
EVER HILL COAL CO.

8' SEAN STRIPPING
STRIPPED BY OTHERS

WORKED OUT


WORKED OUT

WORKED OUT

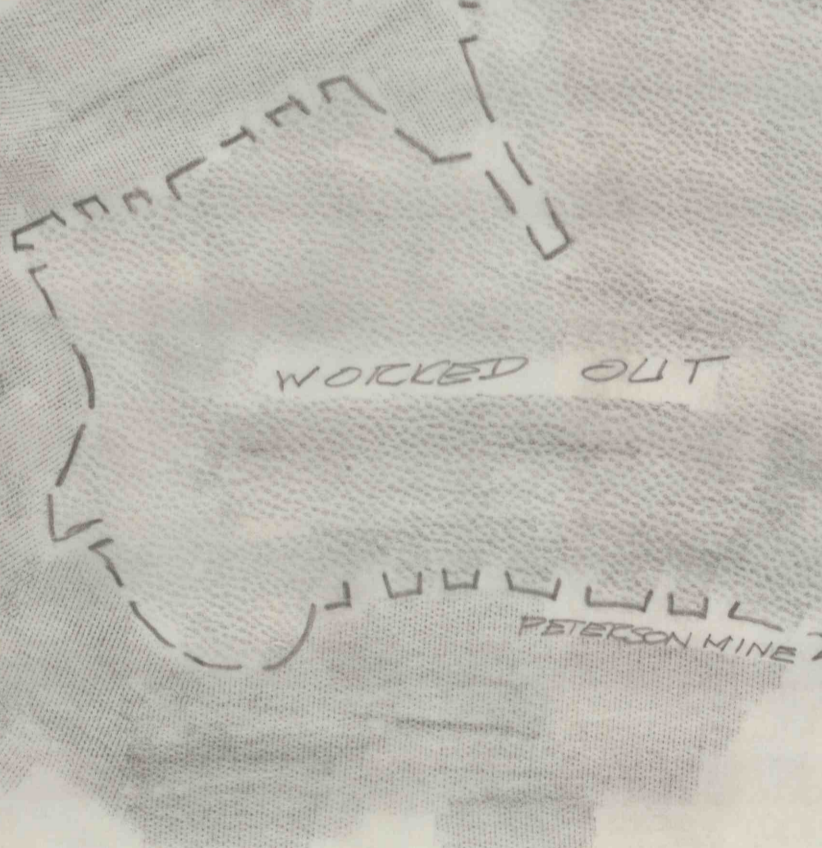

PETERESEN MINE

EVERHILL NO. 3 MINE

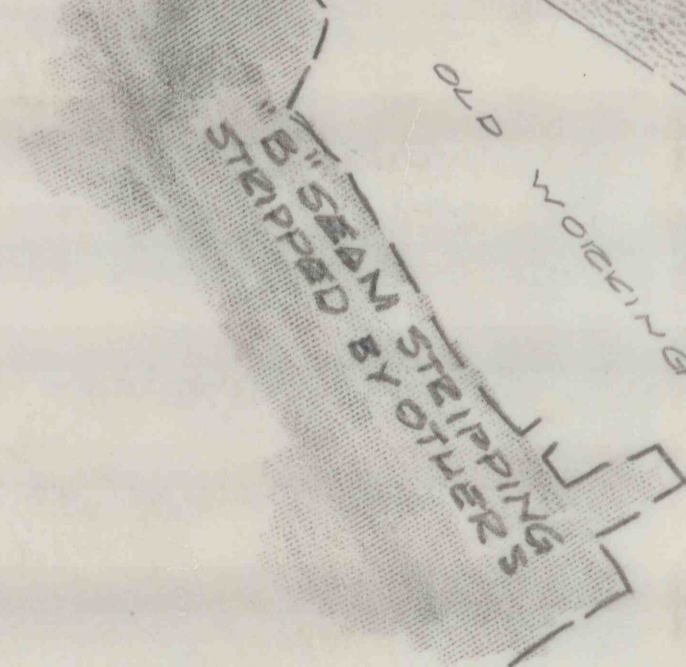

8' SEAN STRIPPING
STRIPPED BY OTHERS

OLD WORKINGS

JOHN NICHOLSON ESTATE

D
MAP OF
EVERHILL MINE NO. 3
OPERATED BY
EVERHILL COAL COMPANY
GEORHAM TWP., CLEARFIELD CO.
SCALE 1"=100' JUNE 15, 1949

July 1, 1957
B. J. A. - J. J. A.

1403A

4885

4882