

LINGLE COAL COMPANY

Coal Mines


Goshen Twp., Clearfield Co., Penna.

SCALE - 1 inch = 100 feet

June 21, 1950  
Clearfield, Penna. Engineering Offices  
Yost, Bromfield & Hess

No. 257, 259A, 271  
EIN 1342A

28  
10  
4

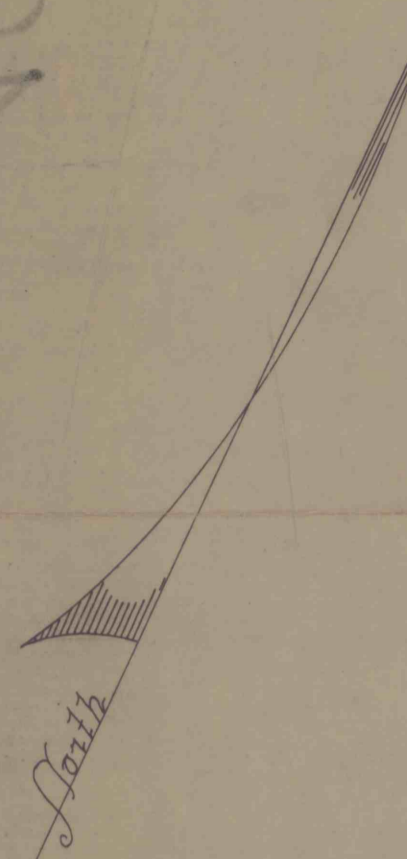

444  
222  
222